


SCALE: 1" = 40' HORIZ.  
1" = 4' VERT.

BENCH: N.W. COR. AS PUMP BE. AT  
CORN VALLEY A.T. W. L. 11. 17. 17.

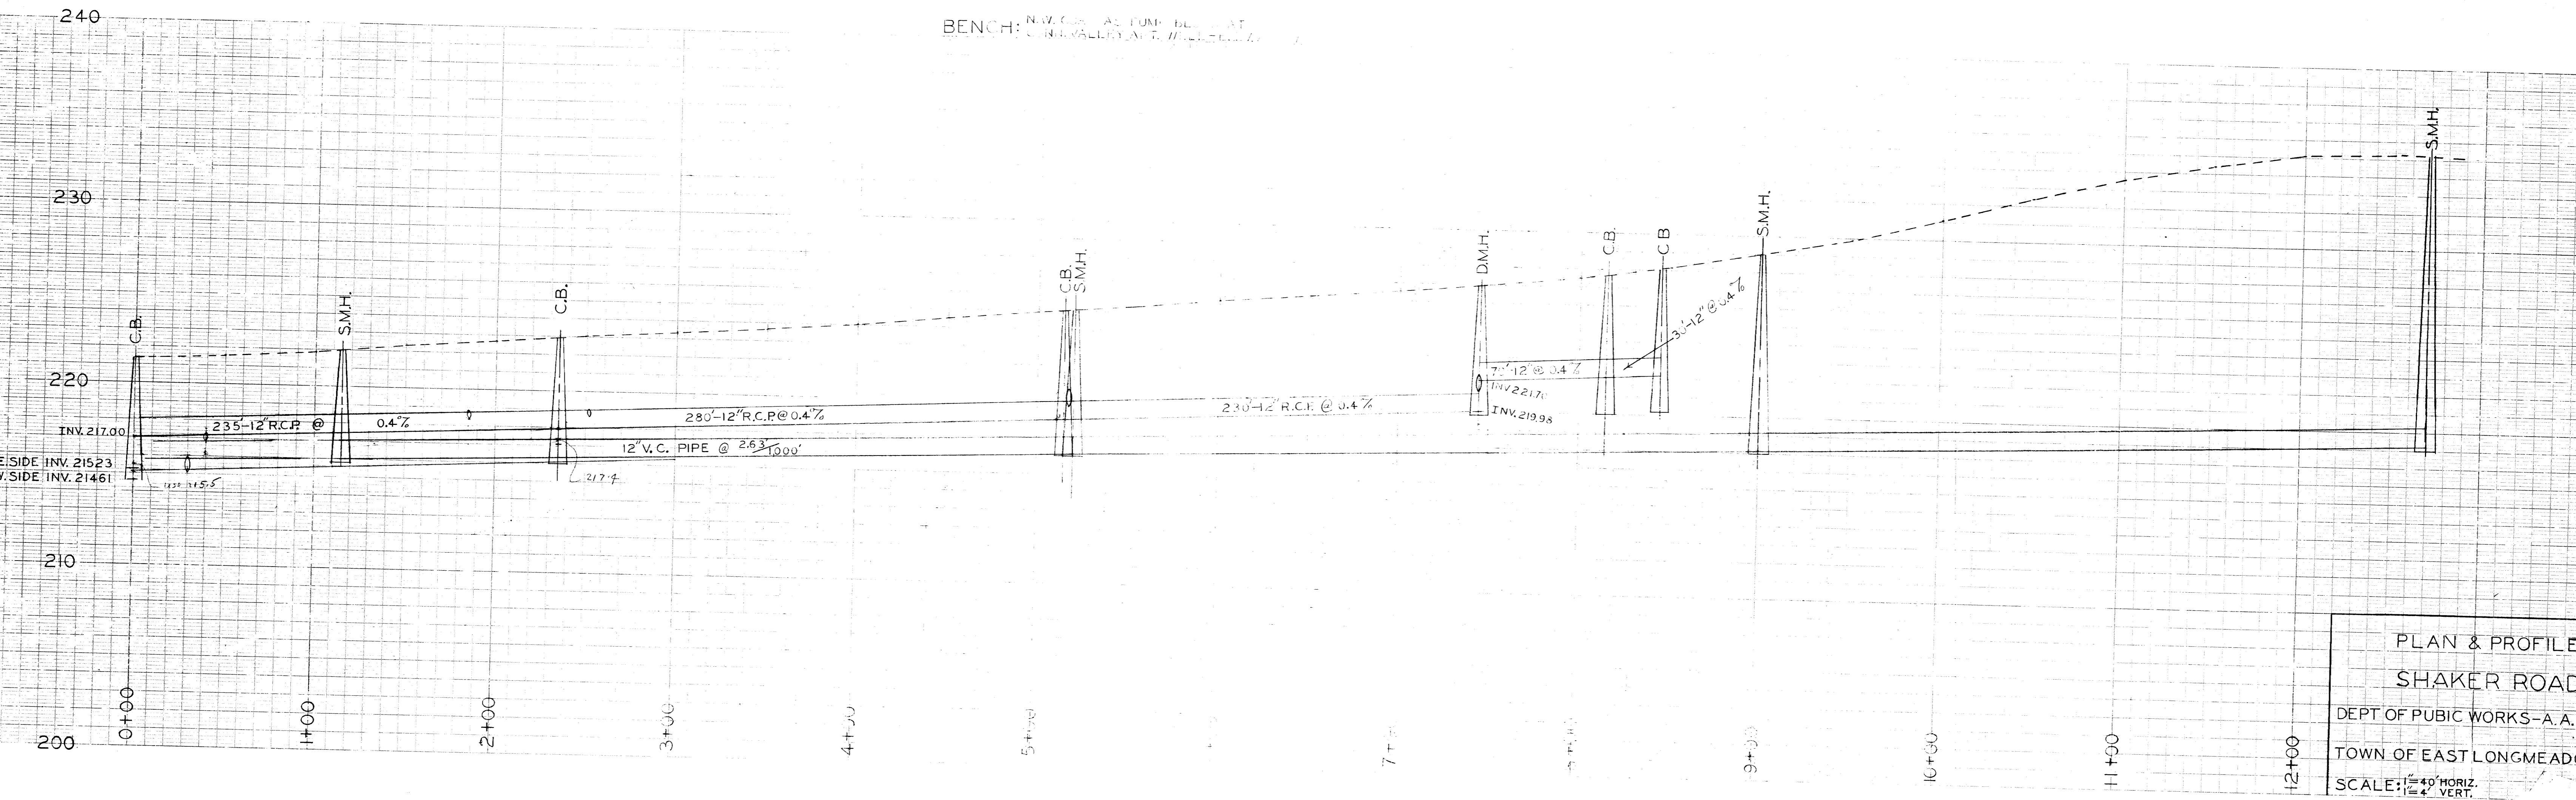

PLAN & PROFILE  
SHAKER ROAD  
DEPT OF PUBIC WORKS-A.A.M  
TOWN OF EAST LONGMEAD  
SCALE: 1" = 40' HORIZ.  
1" = 4' VERT.