




SCALE: 1" = 40' HORIZ.
1" = 4' VERT.

BENCH: TOP OF HYD. SPINDLE FRONT OF HOUSE #129-ELEV. 200.00 (ASSUMED)

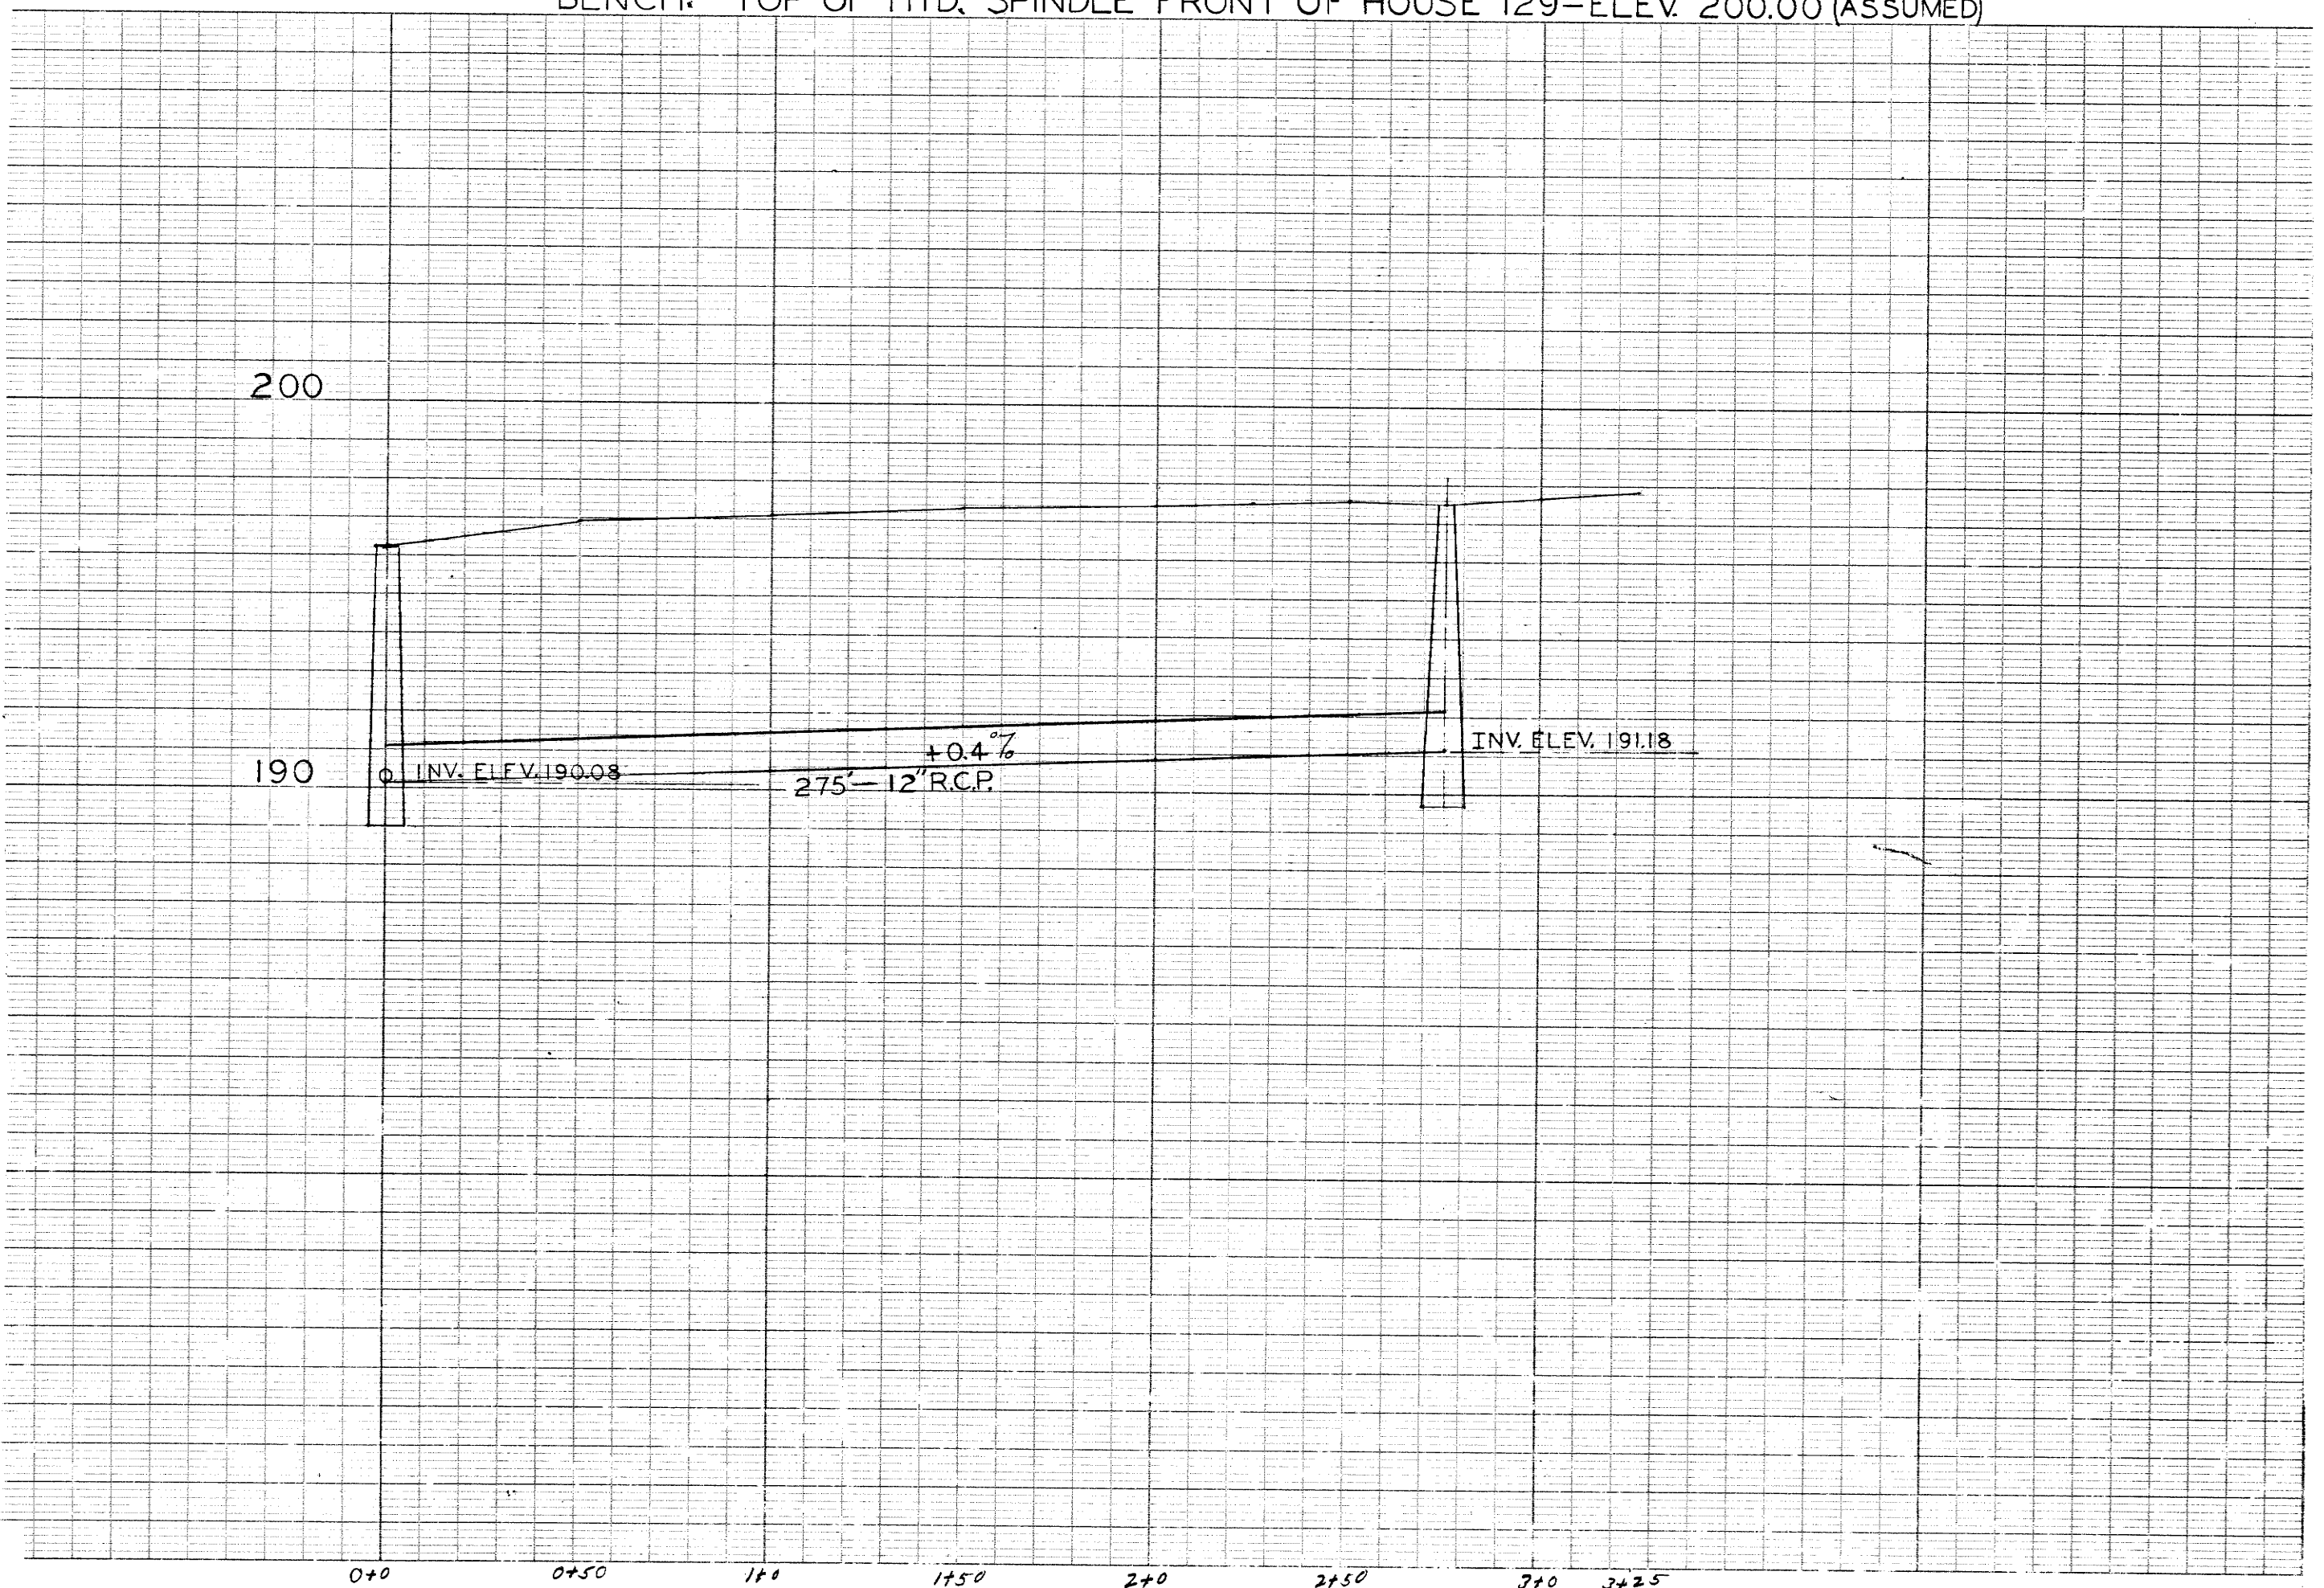

EAST CIRCLE DRIVE

SD-80