


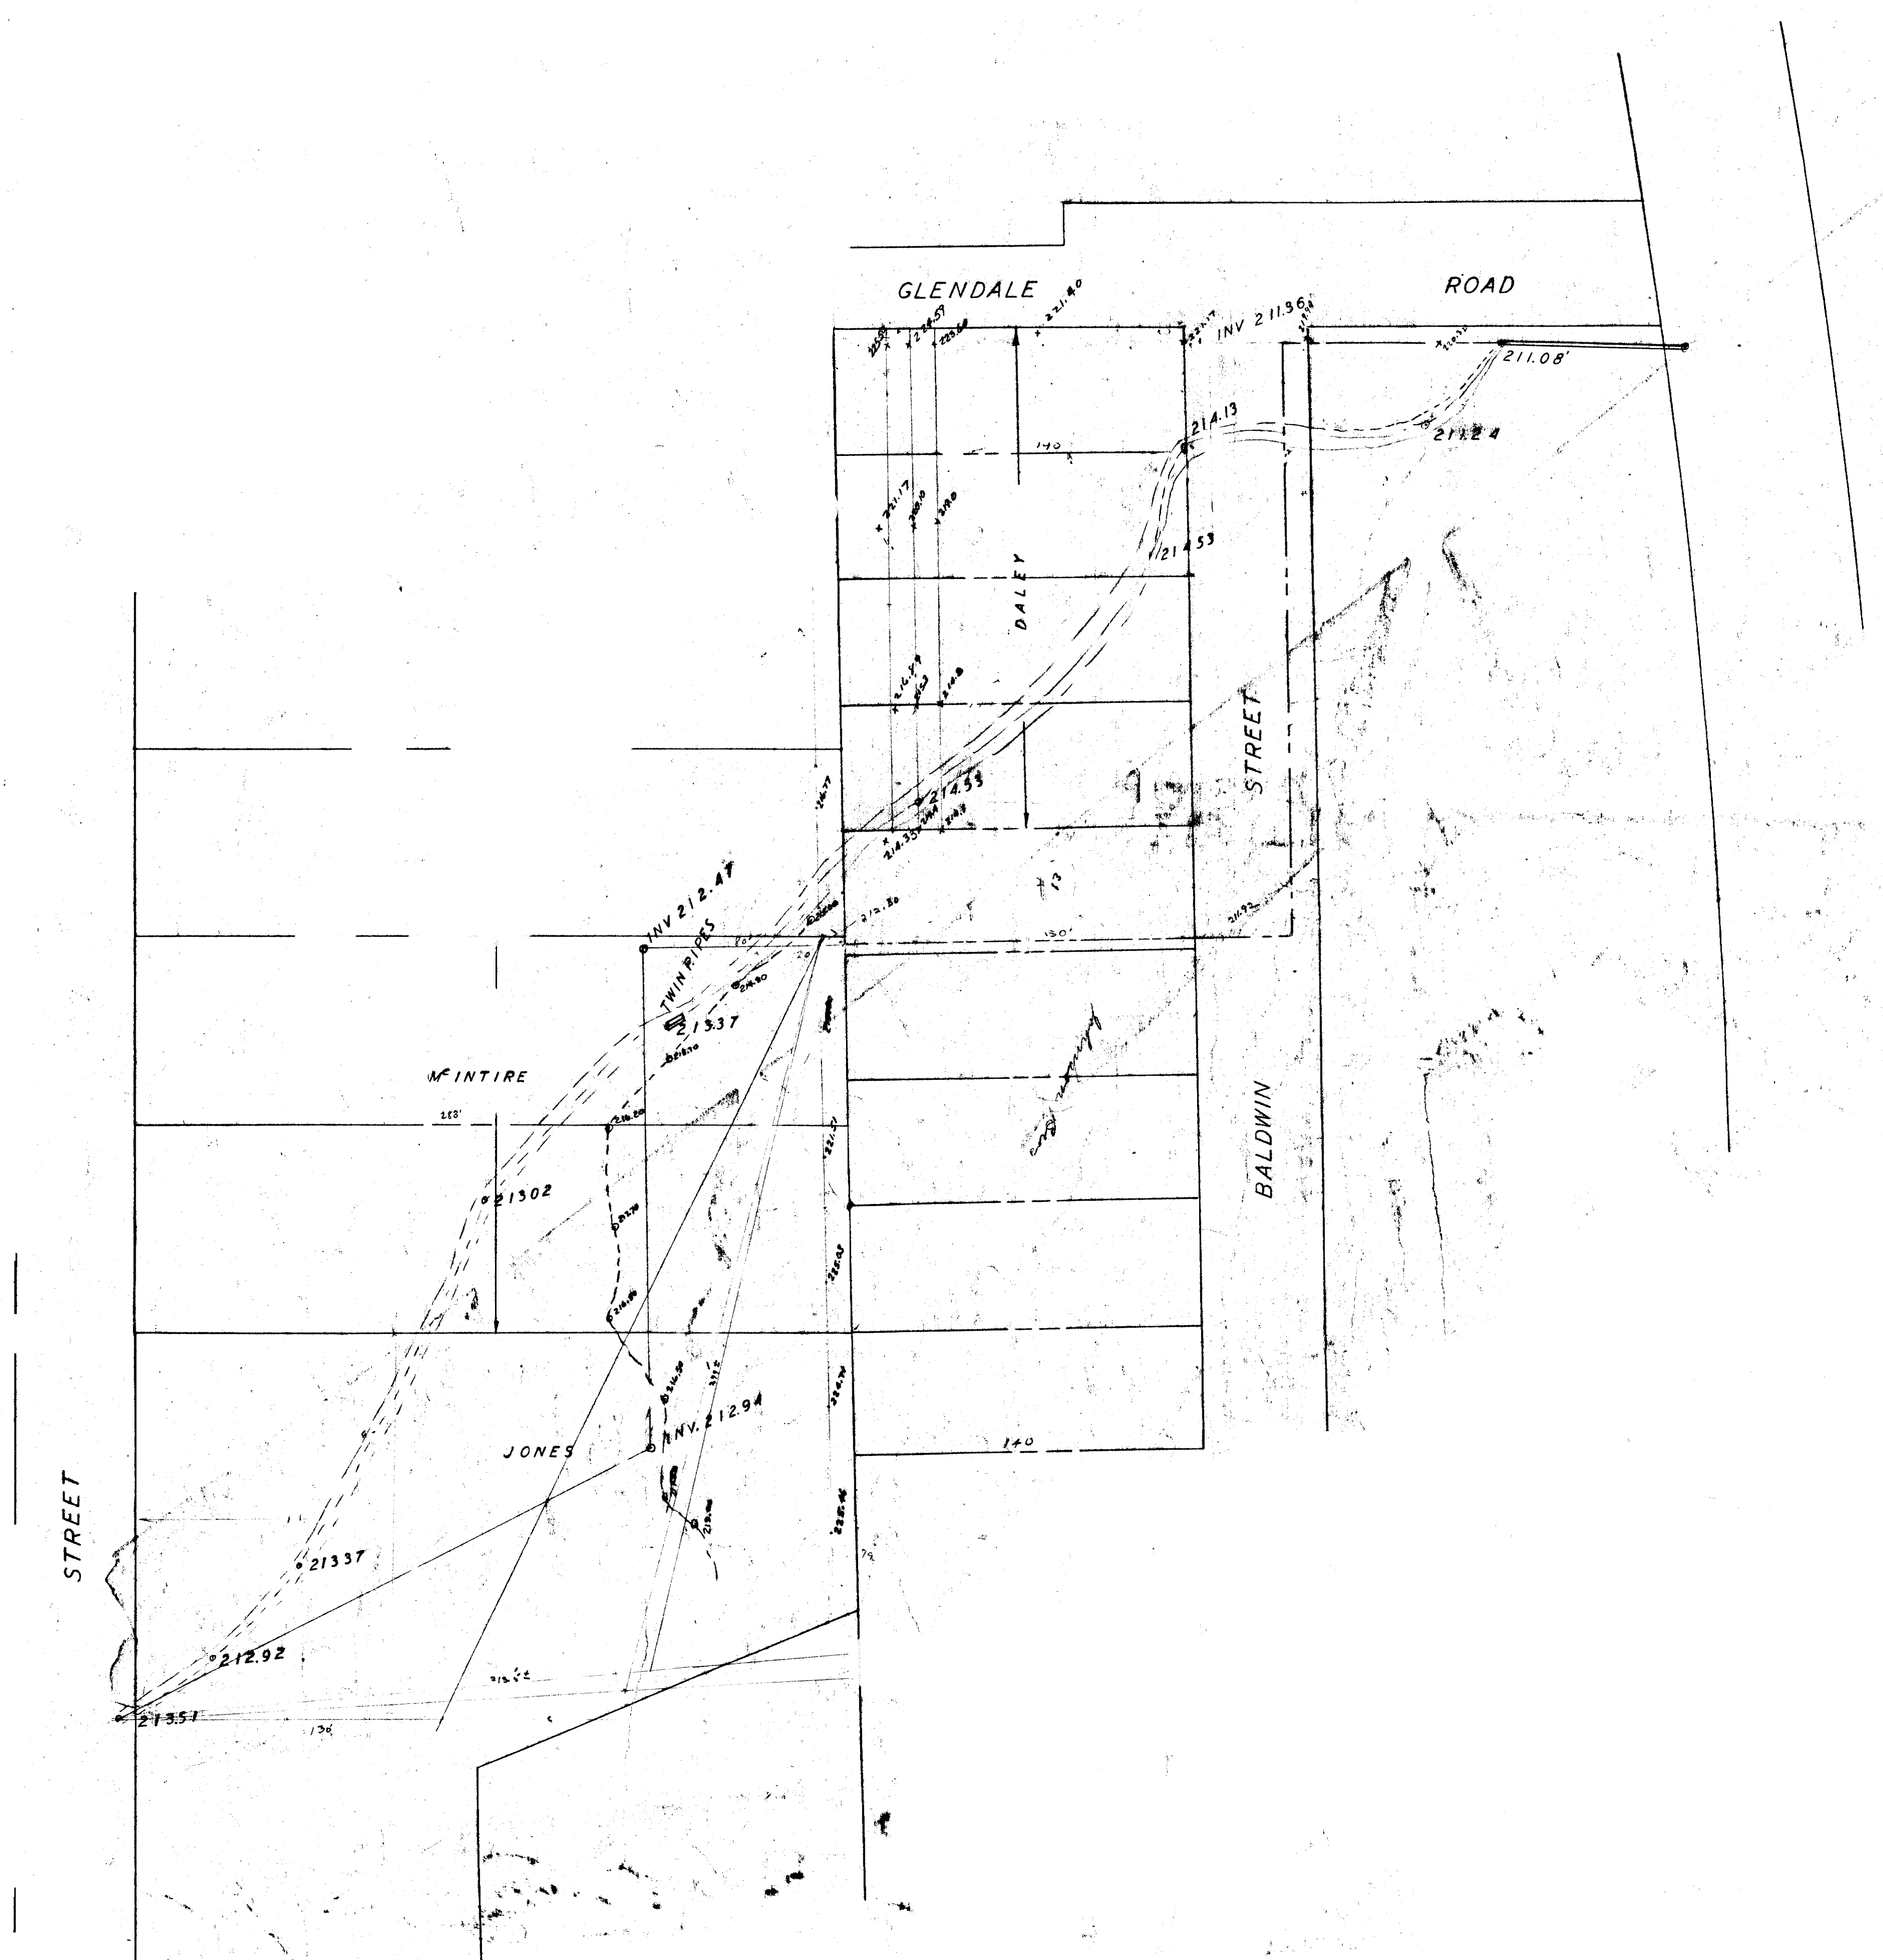

PLAN SHOWING DRAINAGE AREA AT
EDMUND STREET & BALDWIN STREET
TOWN OF EAST LONGMEADOW, MASS.
SCALE: 1" = 40' NOV. 1964