


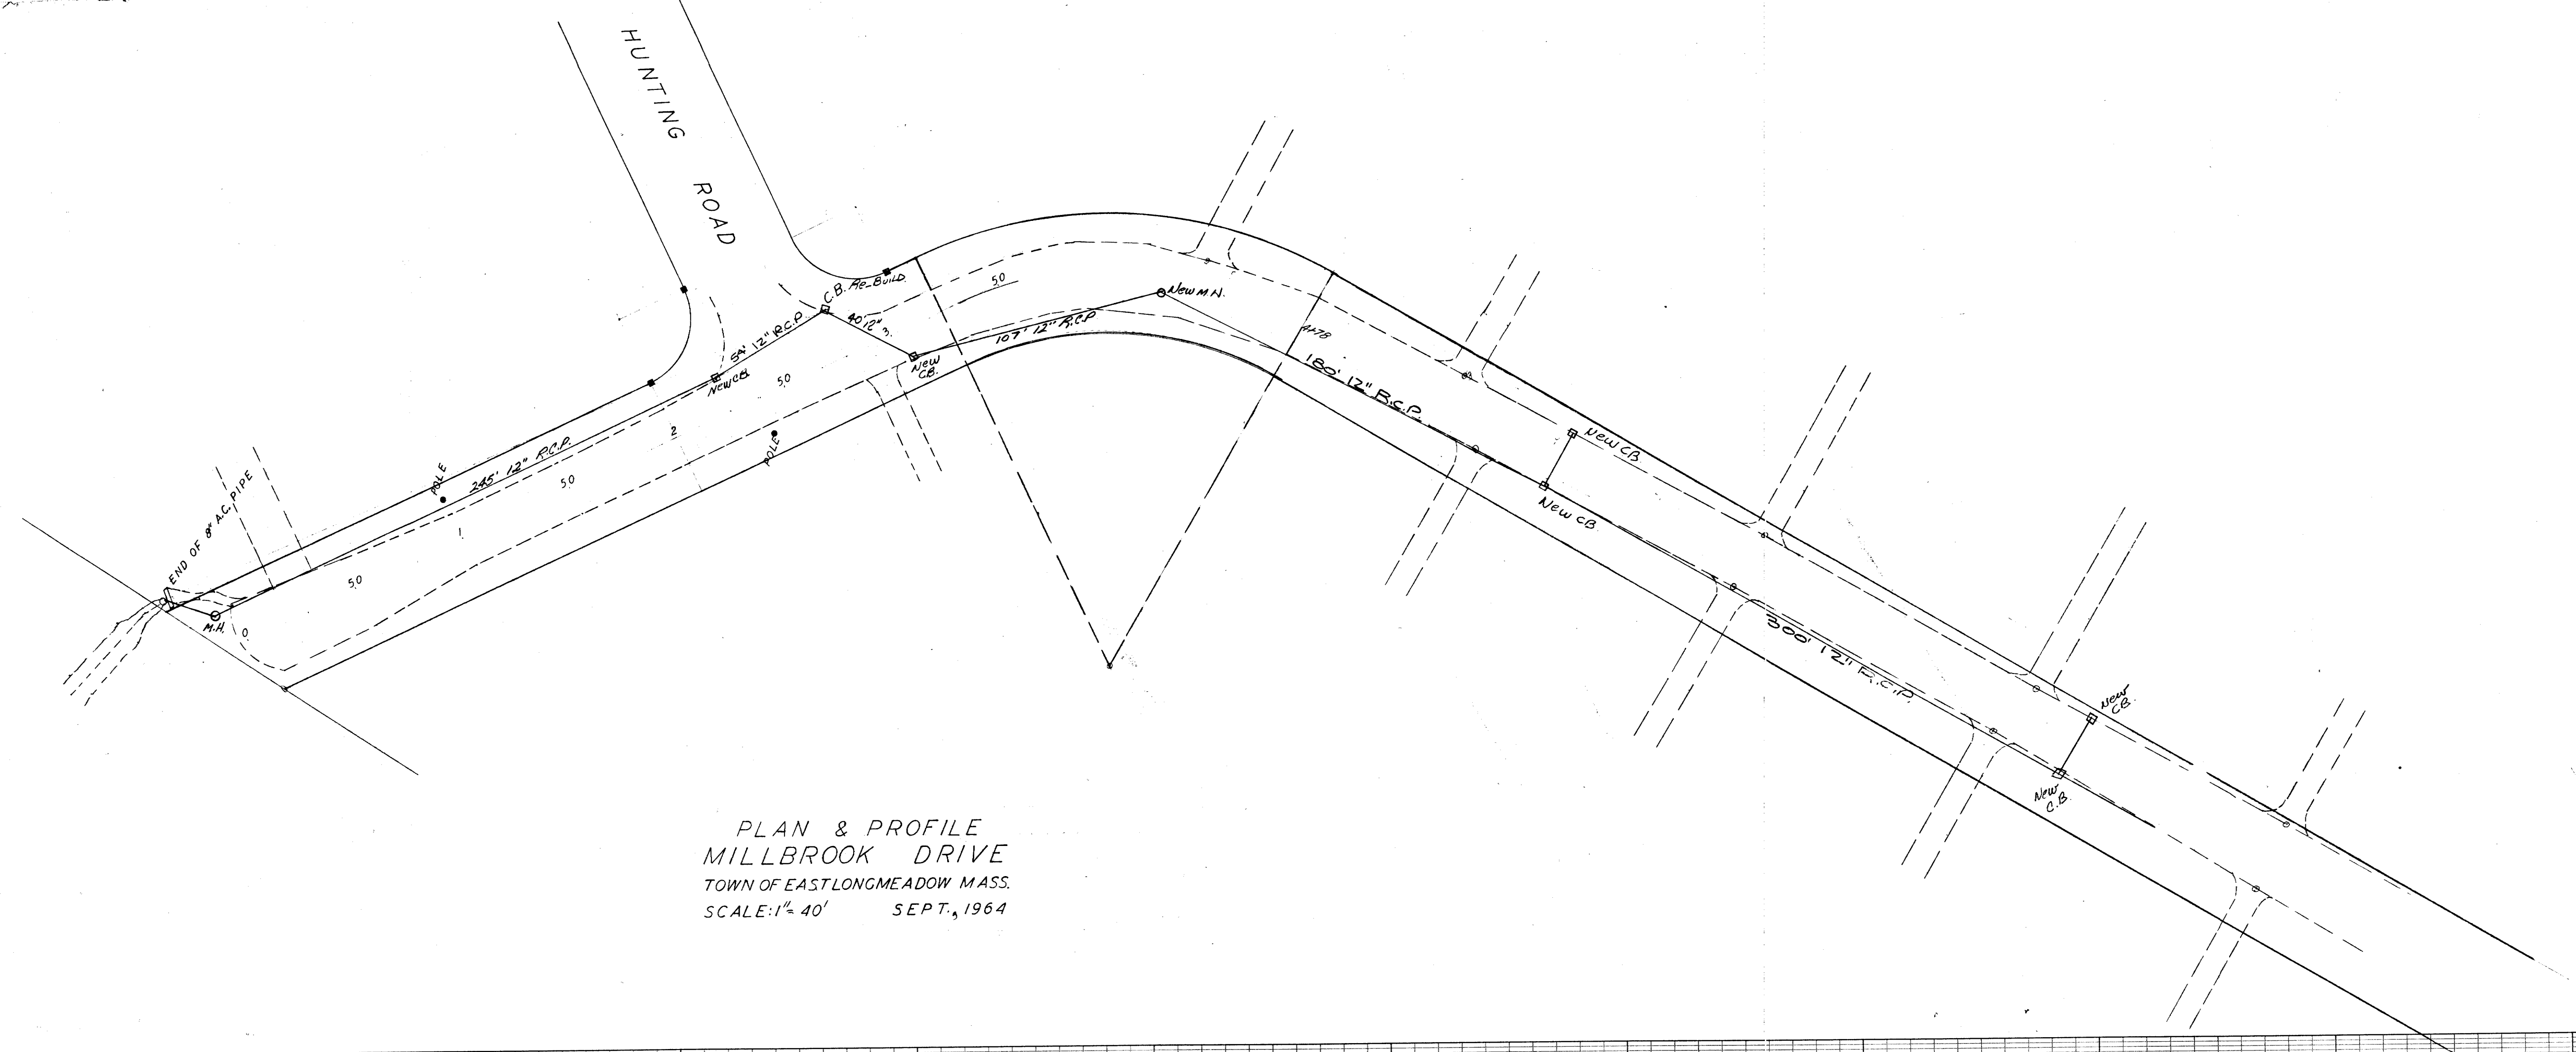

PLAN & PROFILE
MILLBROOK DRIVE
TOWN OF EAST LONGMEADOW MASS.
SCALE: 1" = 40' SEPT., 1964

