




SCALE 1" = 40' HOR

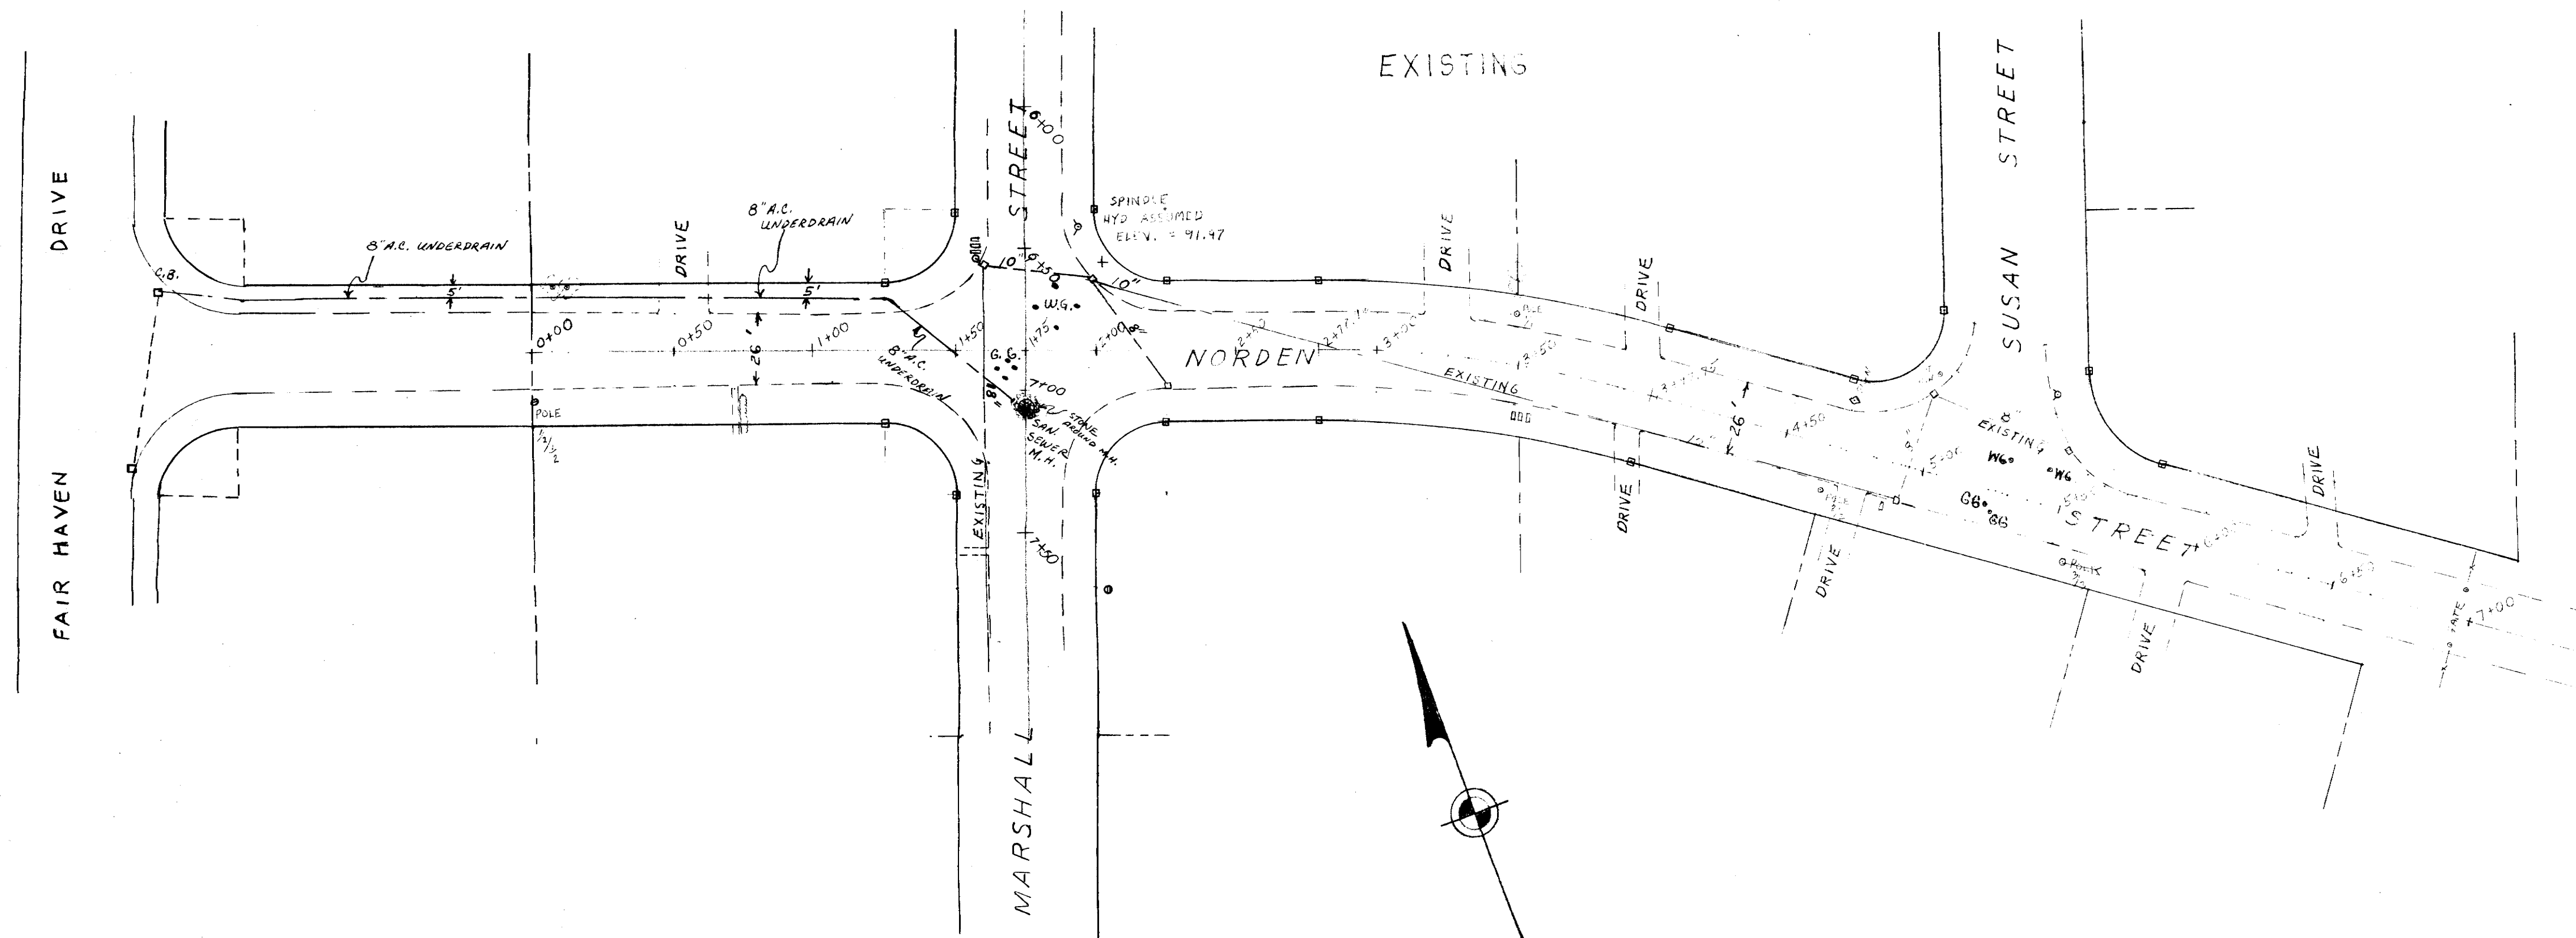