



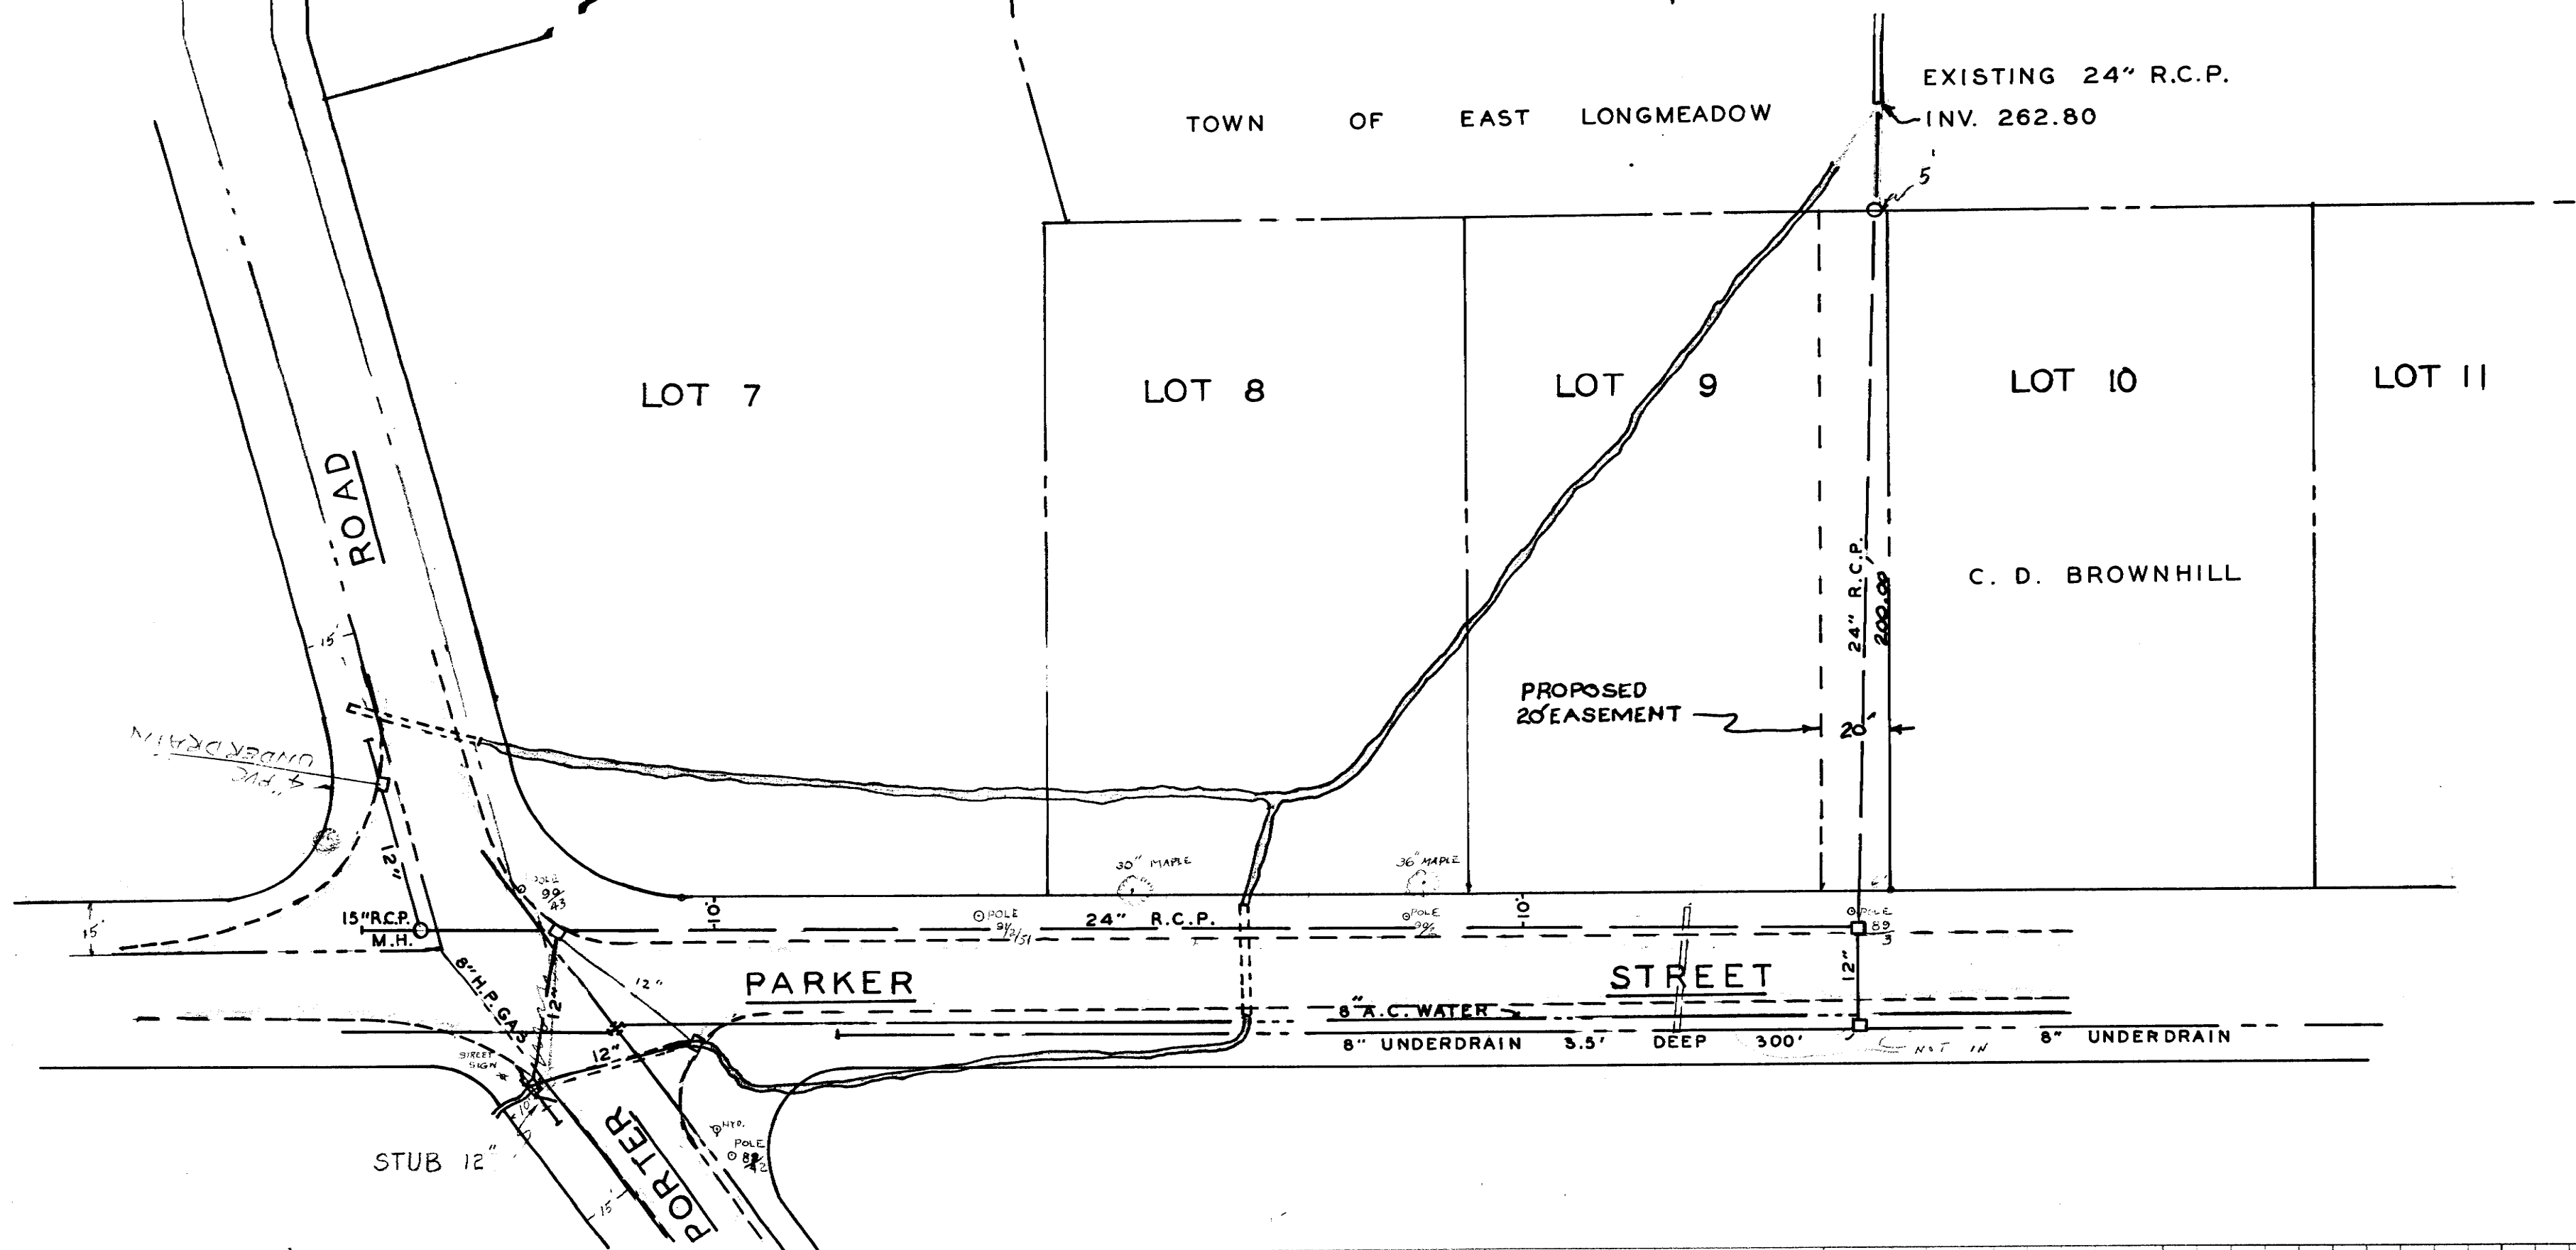

PLAN SHOWING PROPOSED EASEMENT
FOR STORM DRAINAGE PURPOSES
PROPERTY OF
HOLLY REALTY CORP
DEPT. OF PUBLIC WORKS AAMELIEN ENG.
TOWN OF EAST LONGMEADOW, MASS.
SCALE: HOR. 1"=40'
VER. 1"=40'

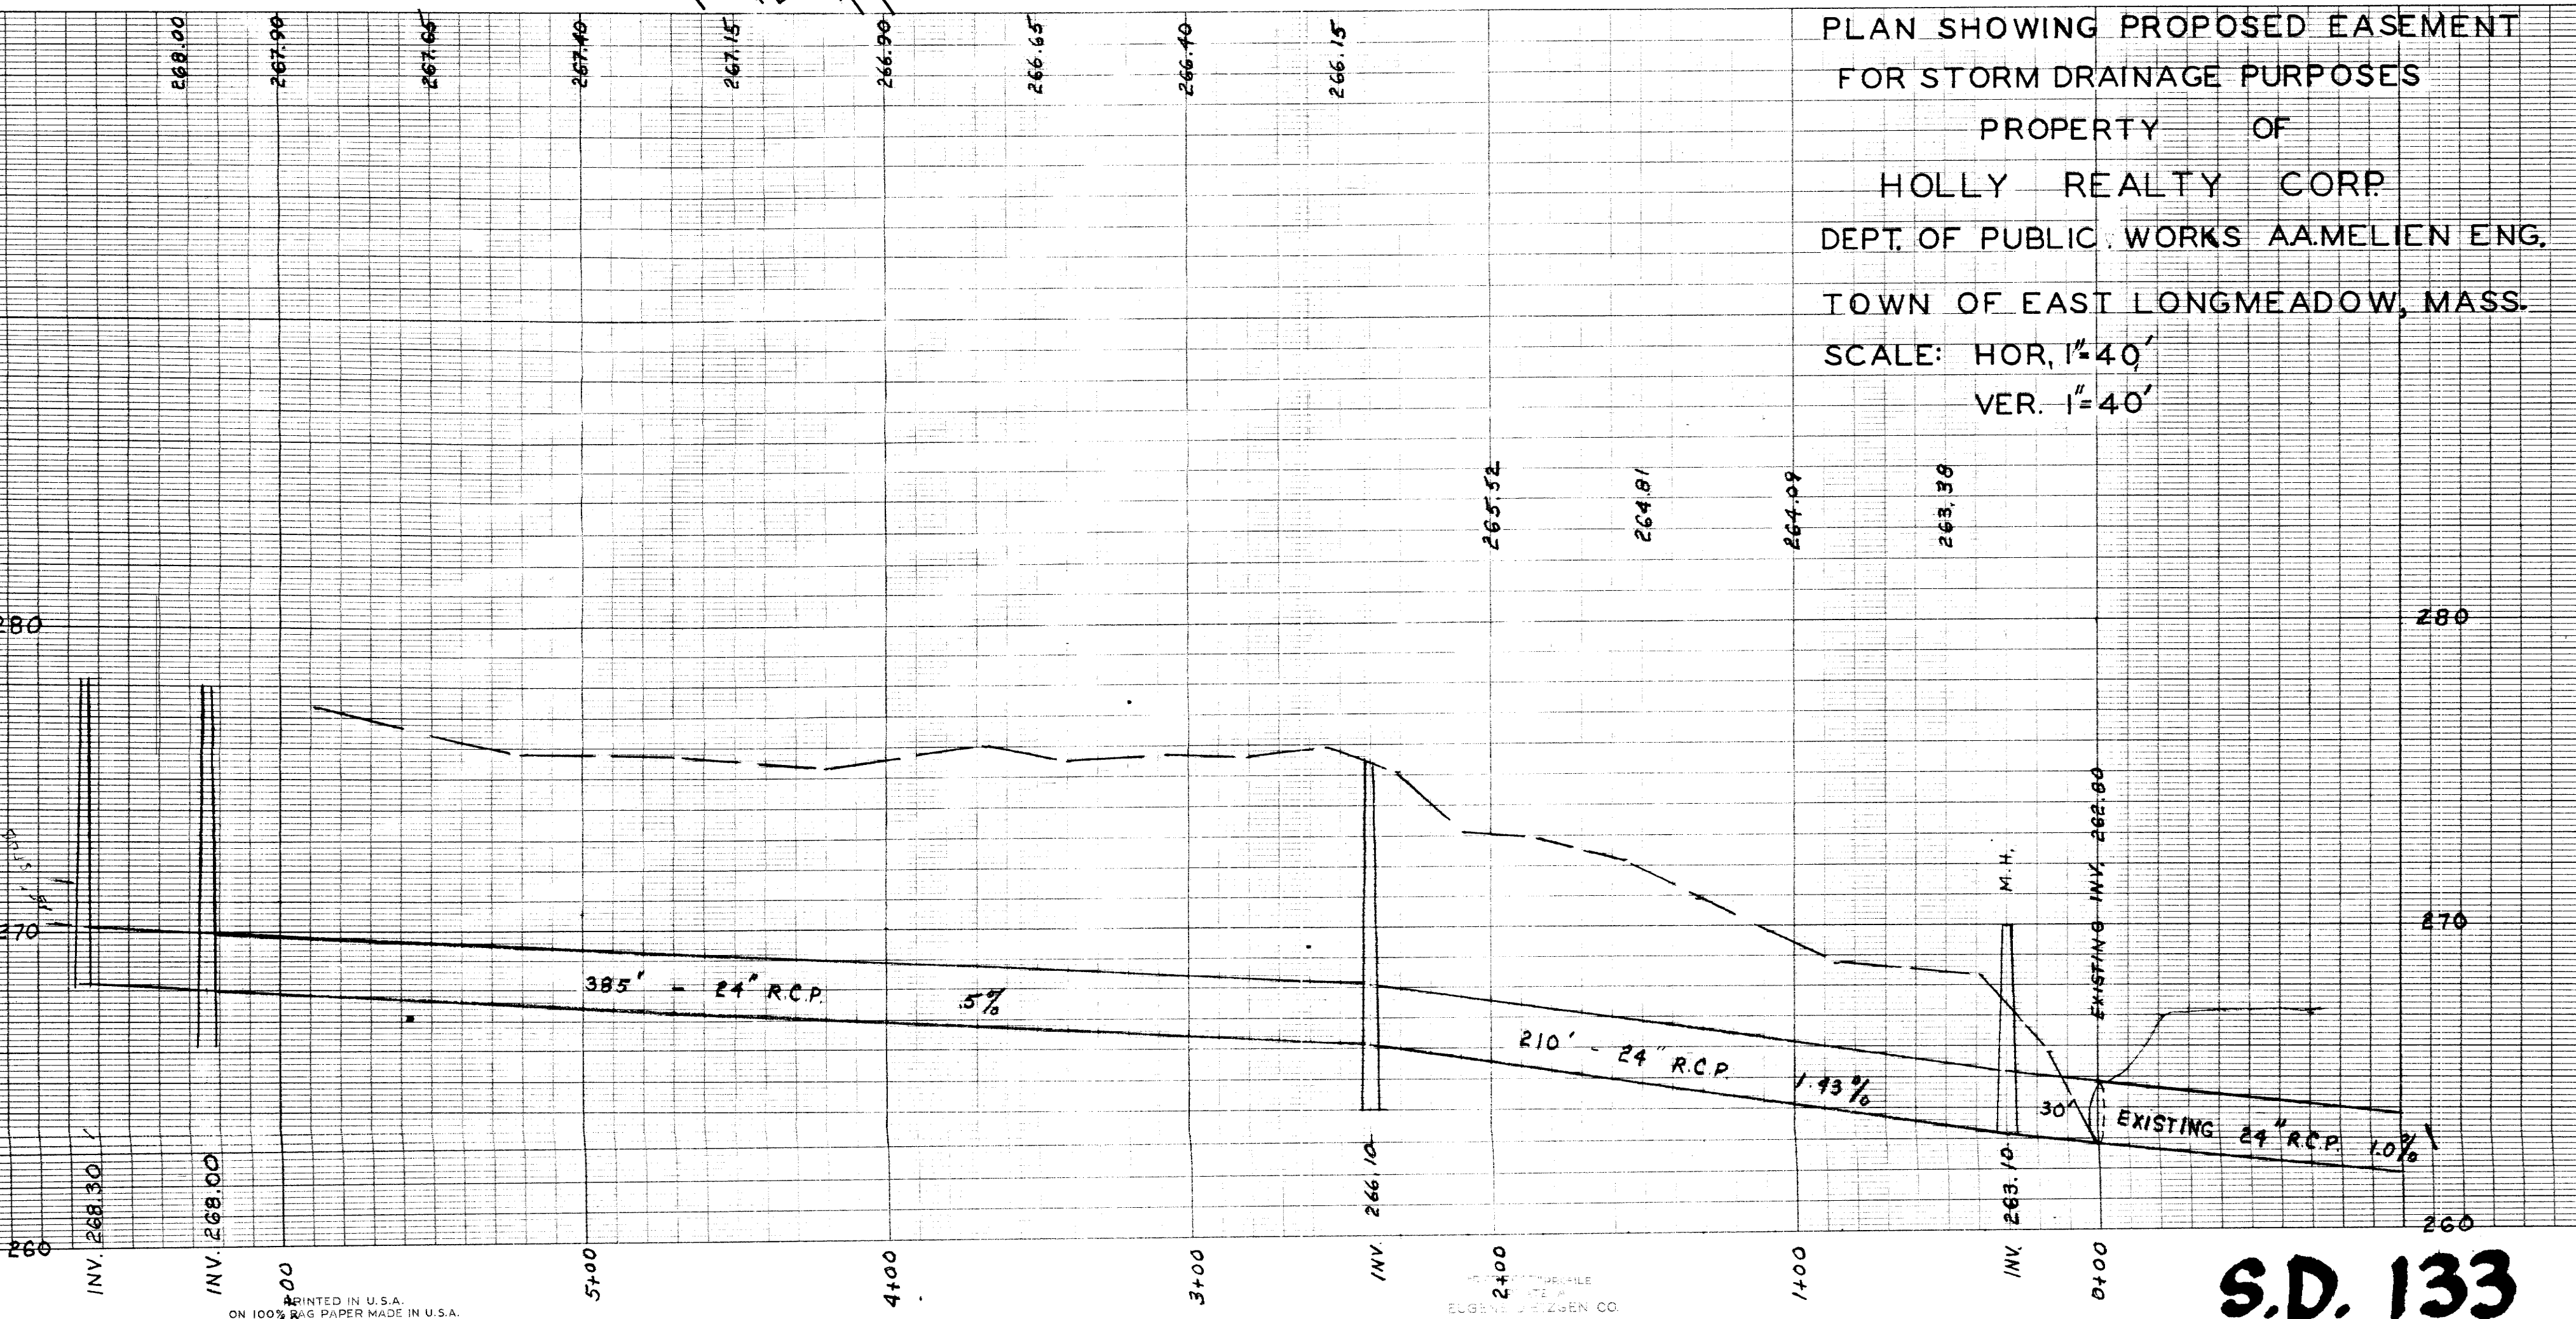

S.D. 133