


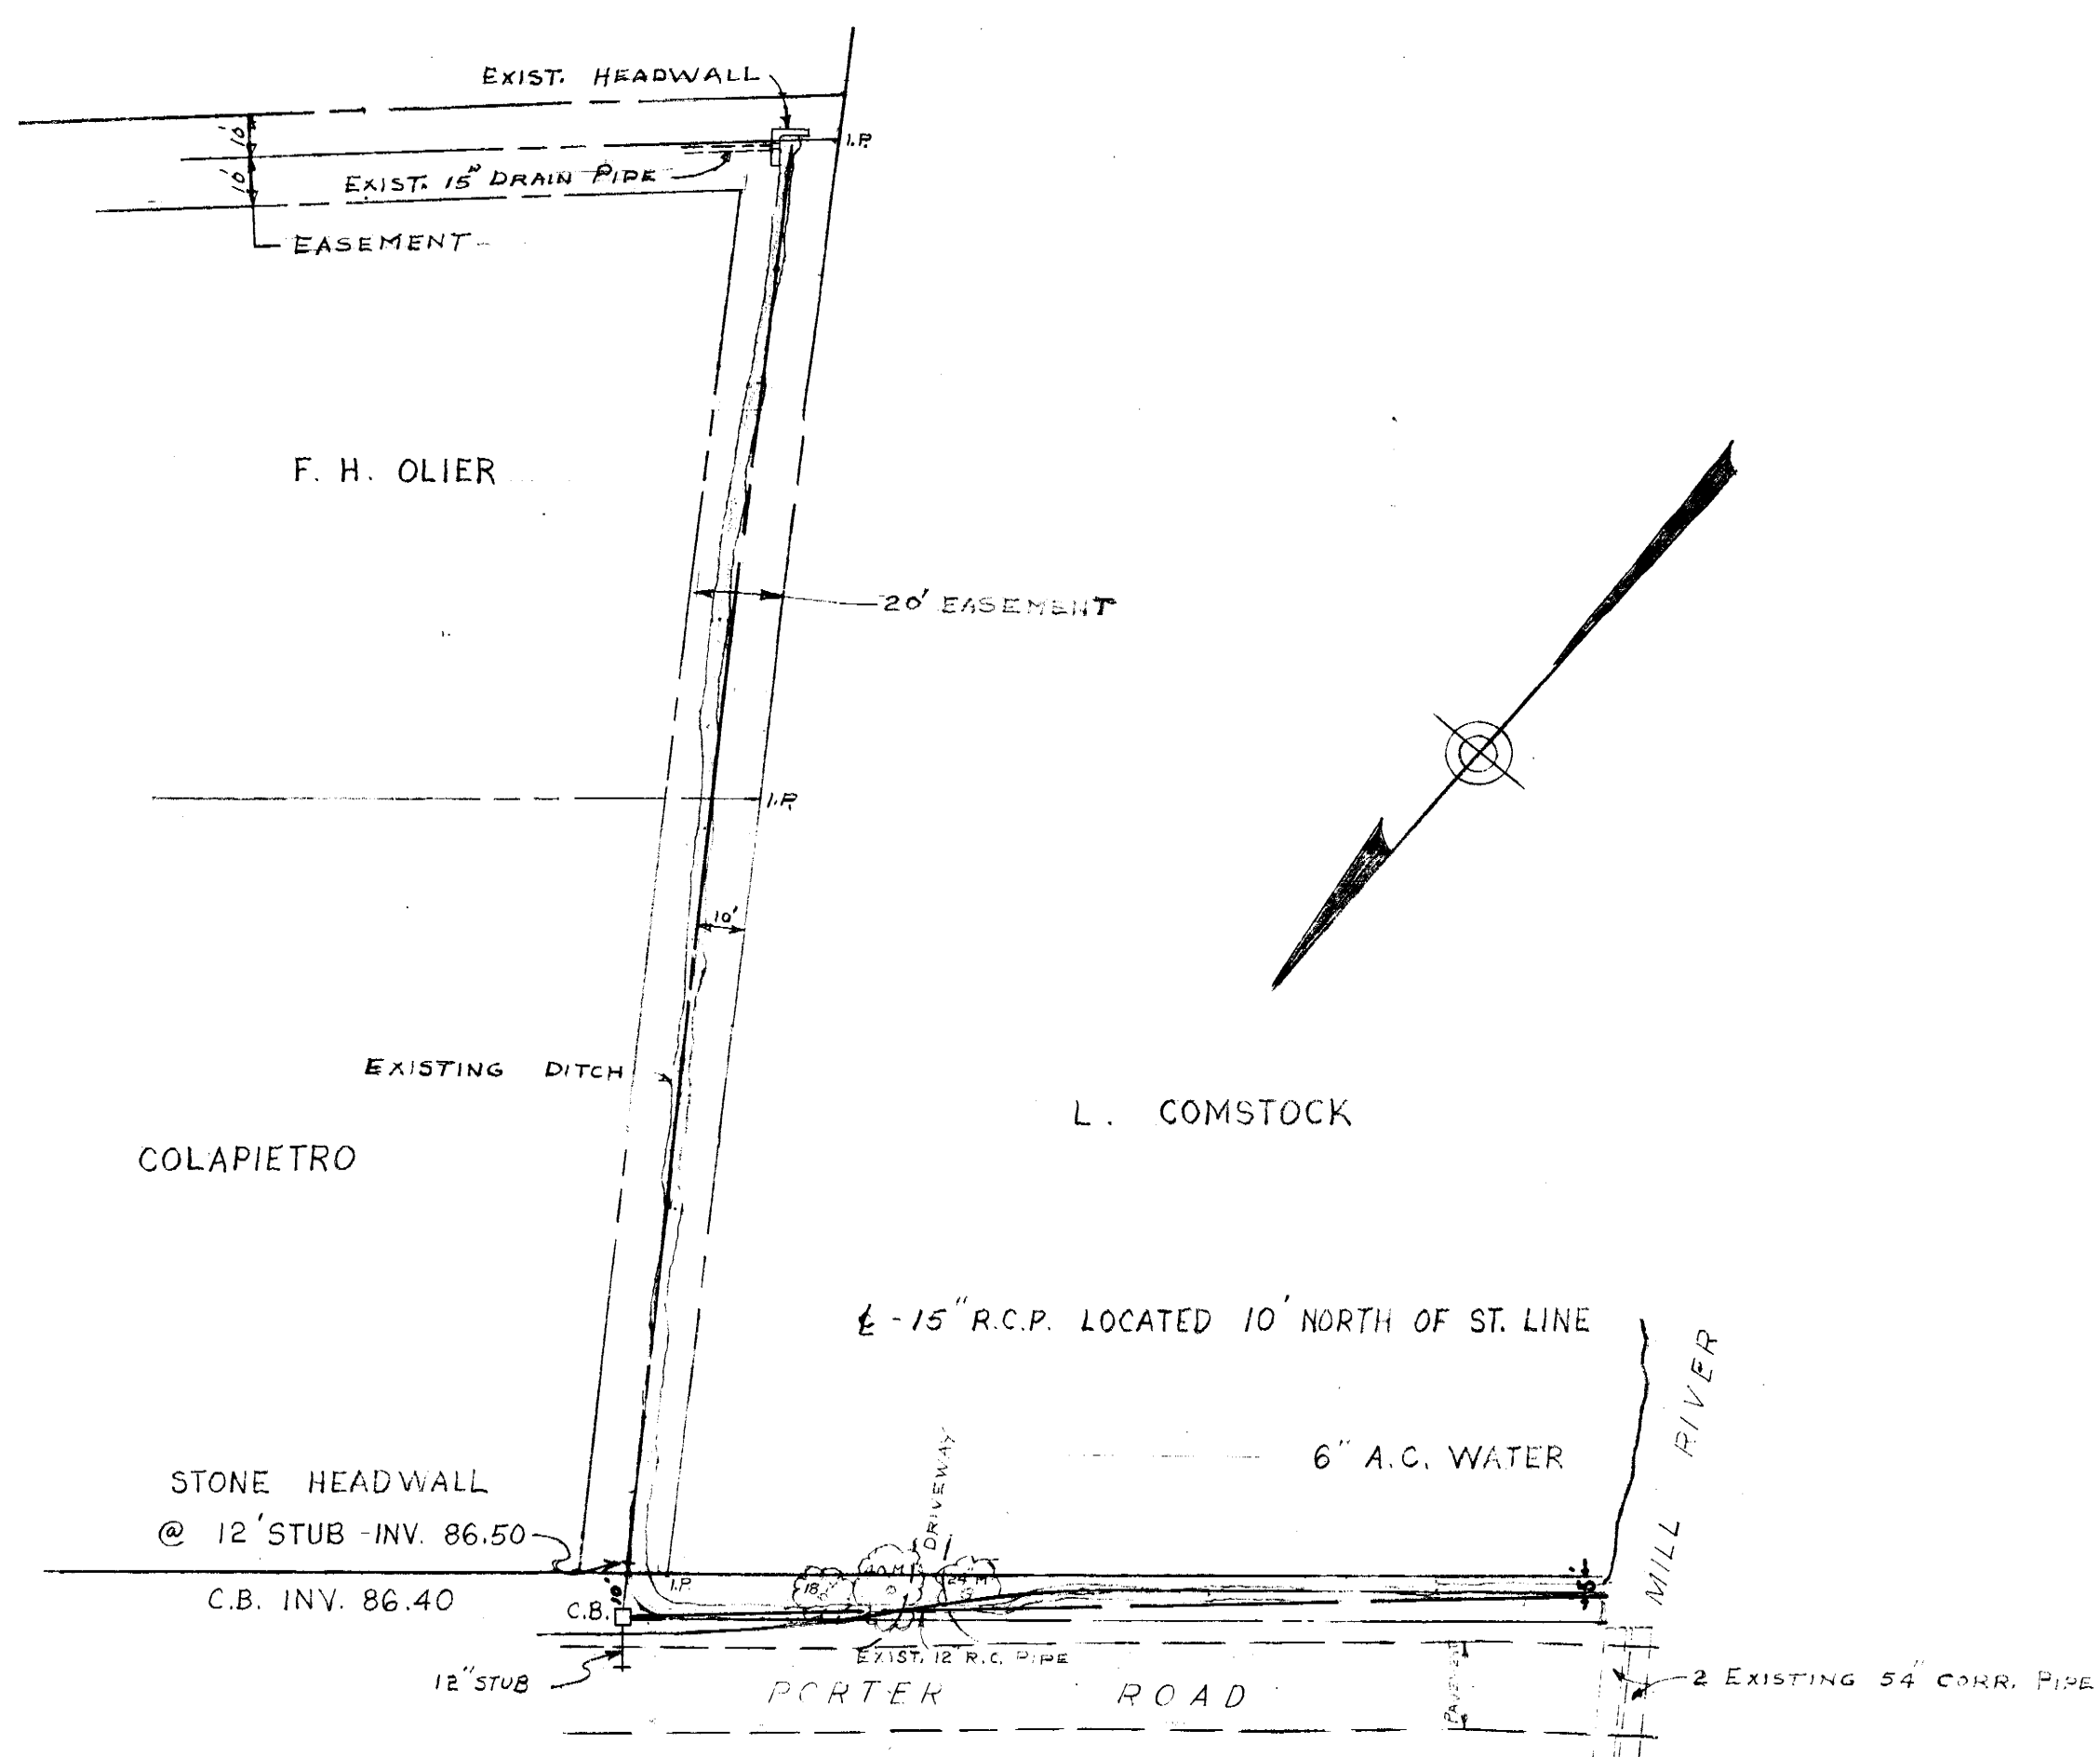

PLAN & PROFILE
 PROPOSED STORM DRAINAGE
 FROM
 BROOKHAVEN DRIVE TO MILL RIVER
 SCALE: HORIZ. 1"=40' VERT. 1"=4'
 DATE: 11-22-67

