


17' 4" UNDER DRAIN  
3.0' BELOW GROUND  
57002 TO 57200 GROUND

KIBBE RD

SHEET 3 OF 7

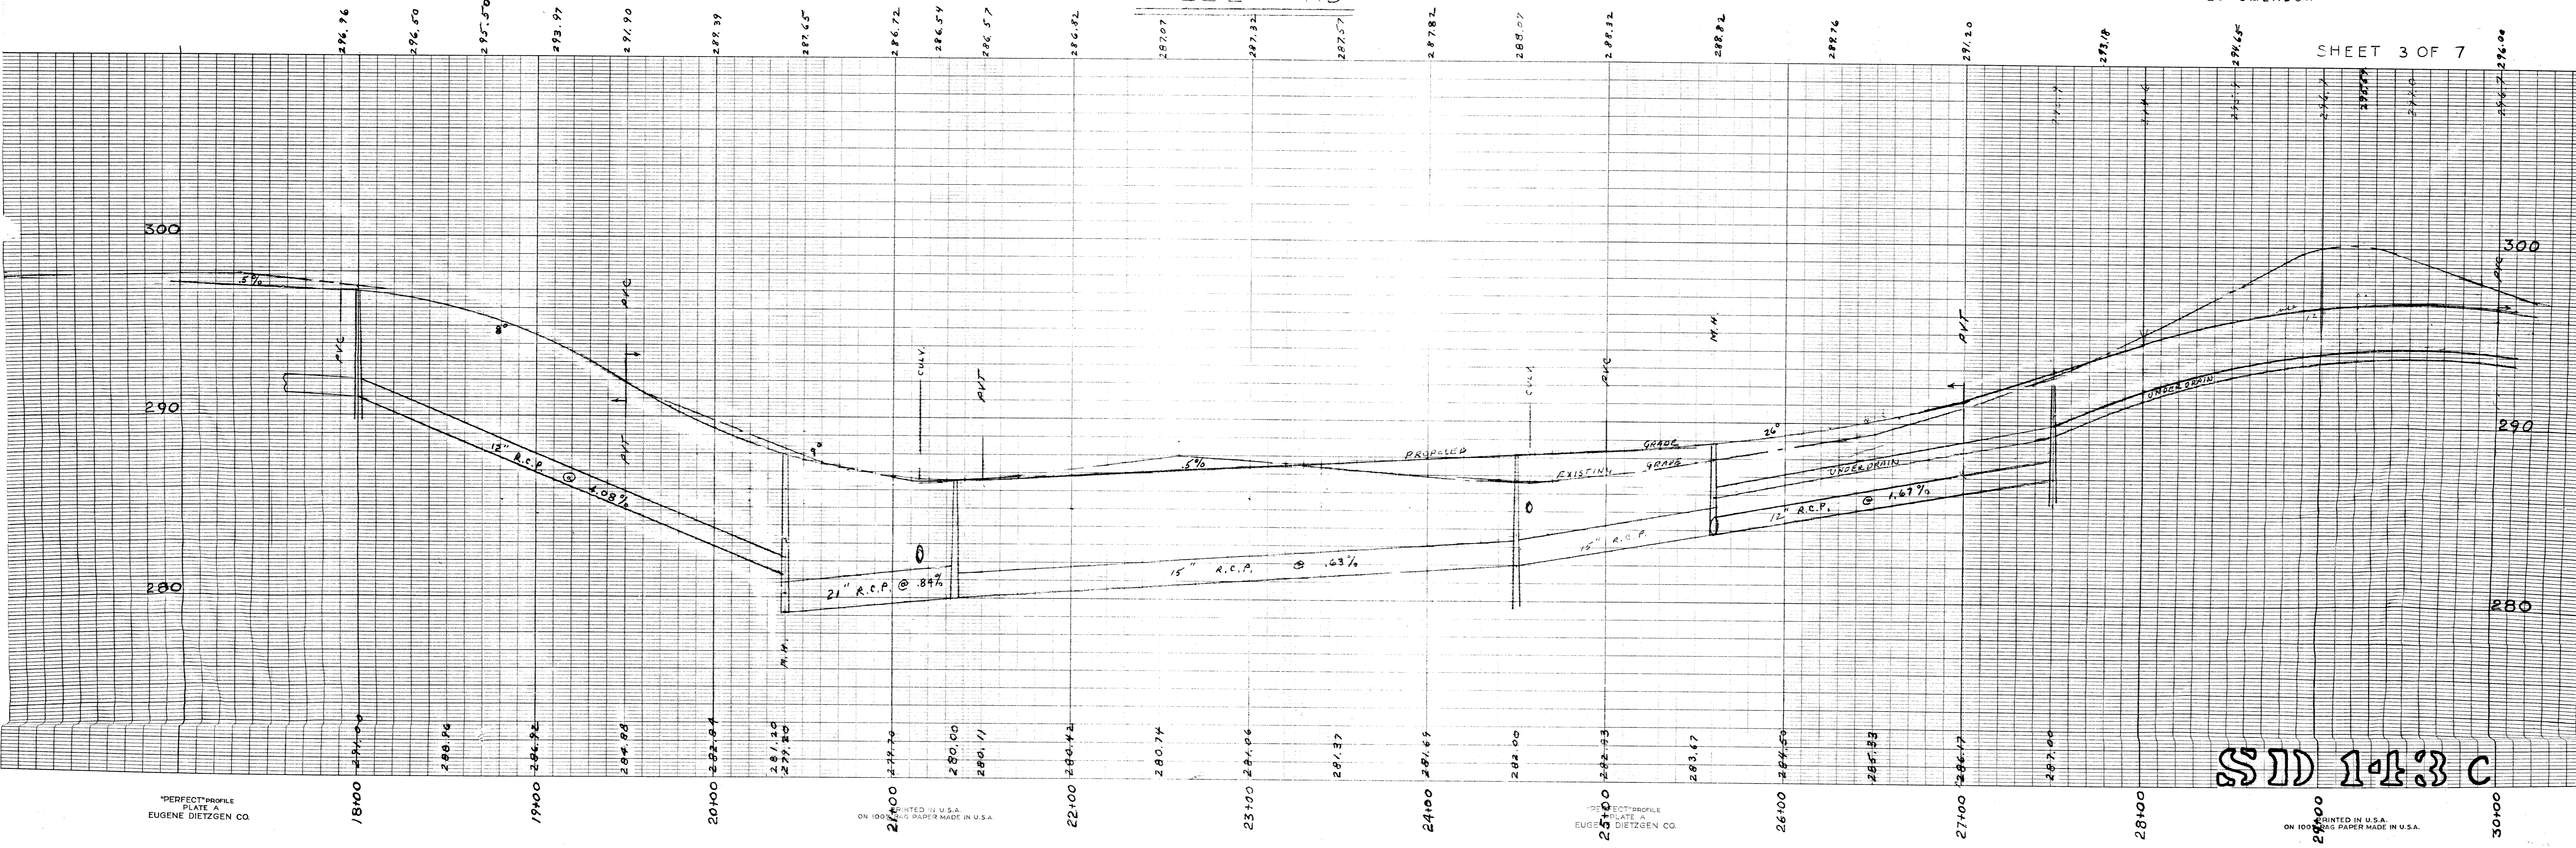

SD 1-A-3 C