


PLAN AND PROFILE
ROAD RECONSTRUCTION
KIBBE ROAD
SCALE: 1" = 4' VERT. 1" = 40' HORIZ.
A. A. MELIEN, ENG.
TOWN OF EAST LONGMEADOW

SHEET 6 OF 7

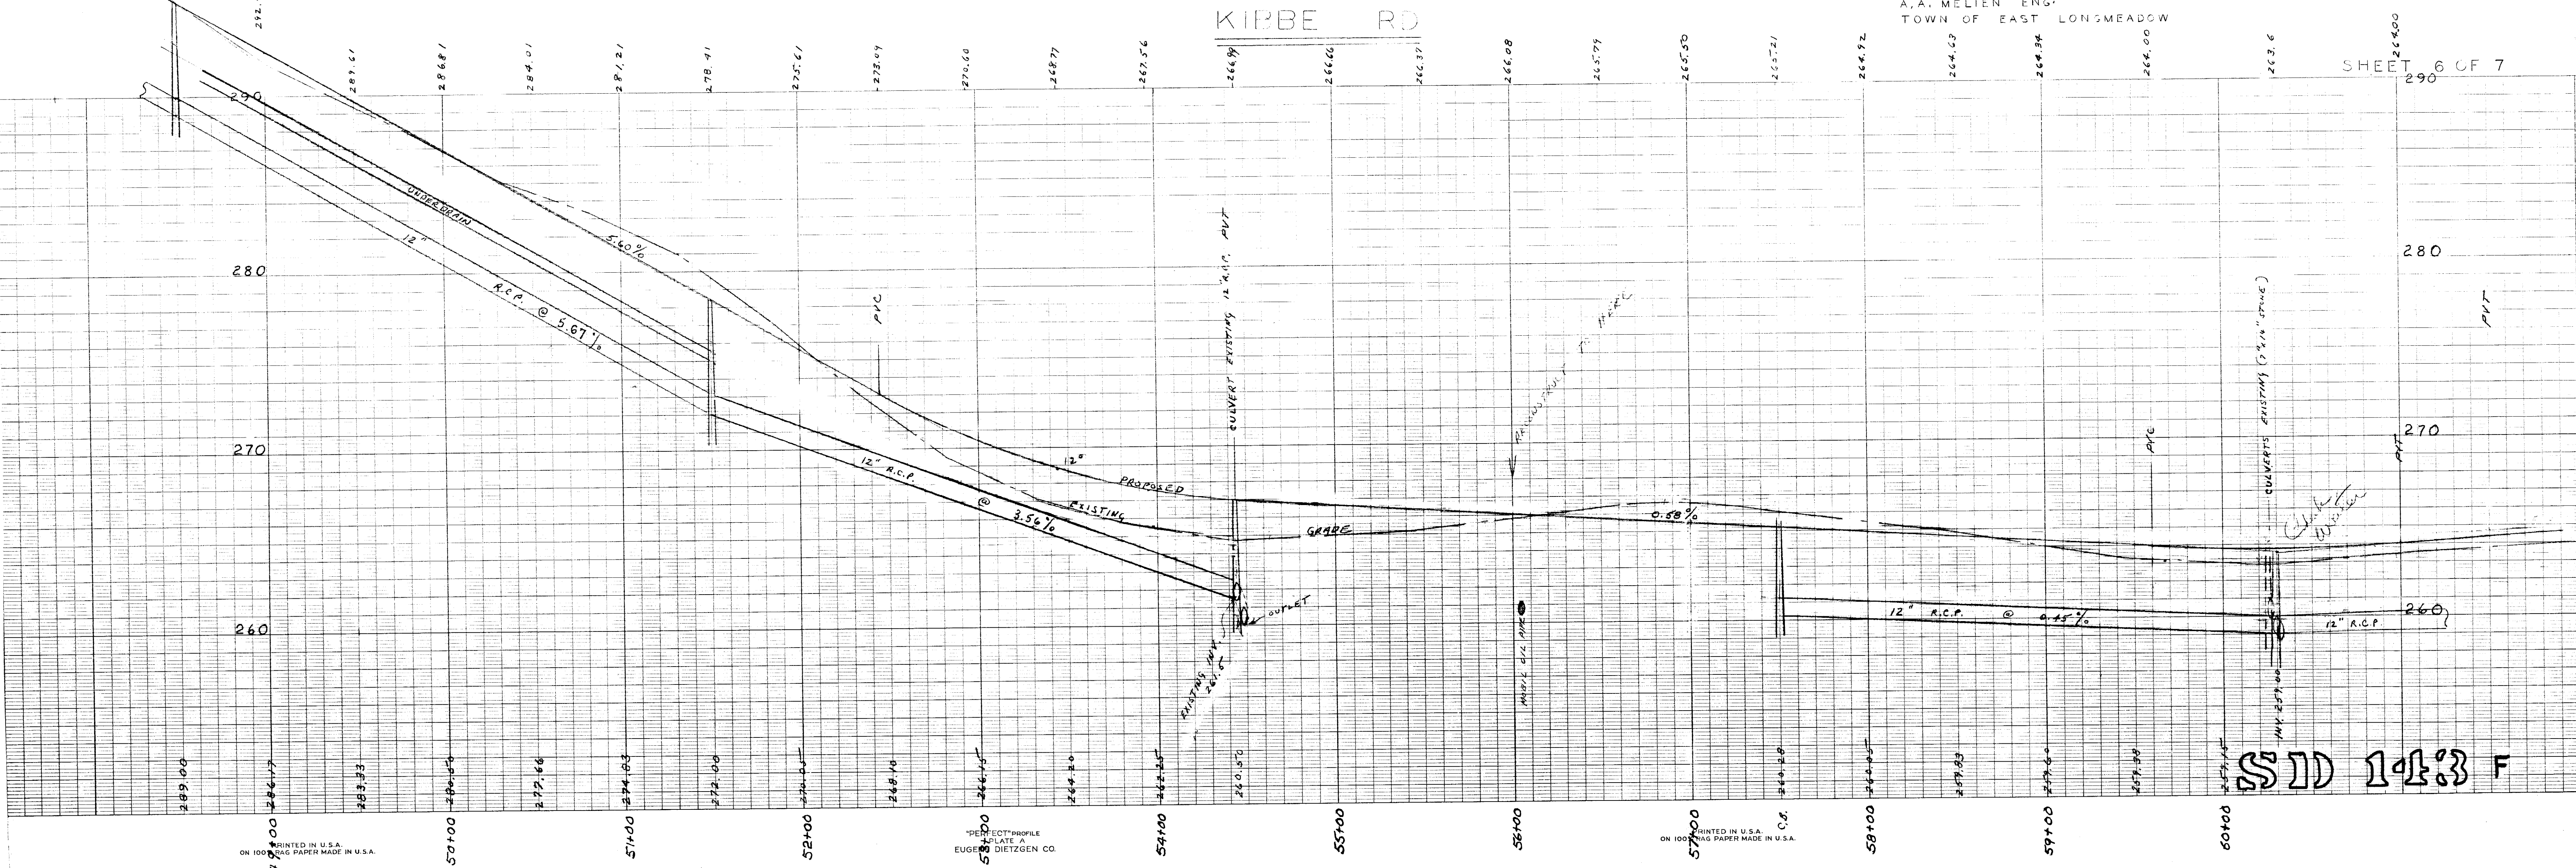

SS DD 1-1-33 F