




PLAN & PROFILE FOR
ANTHONY DRIVE
DEVELOPED BY
VINCENT A. FERRERO
EAST LONGMEADOW - MASSACHUSETTS

SCALE: HOR. 1" = 40 FT. MAR., 1957.
VERT. 1" = 4 FT.

C. E. ANDERSON
ASSOCIATES
Civil Engineers Land Surveyors
Land Planning Consultants
Springfield - Massachusetts

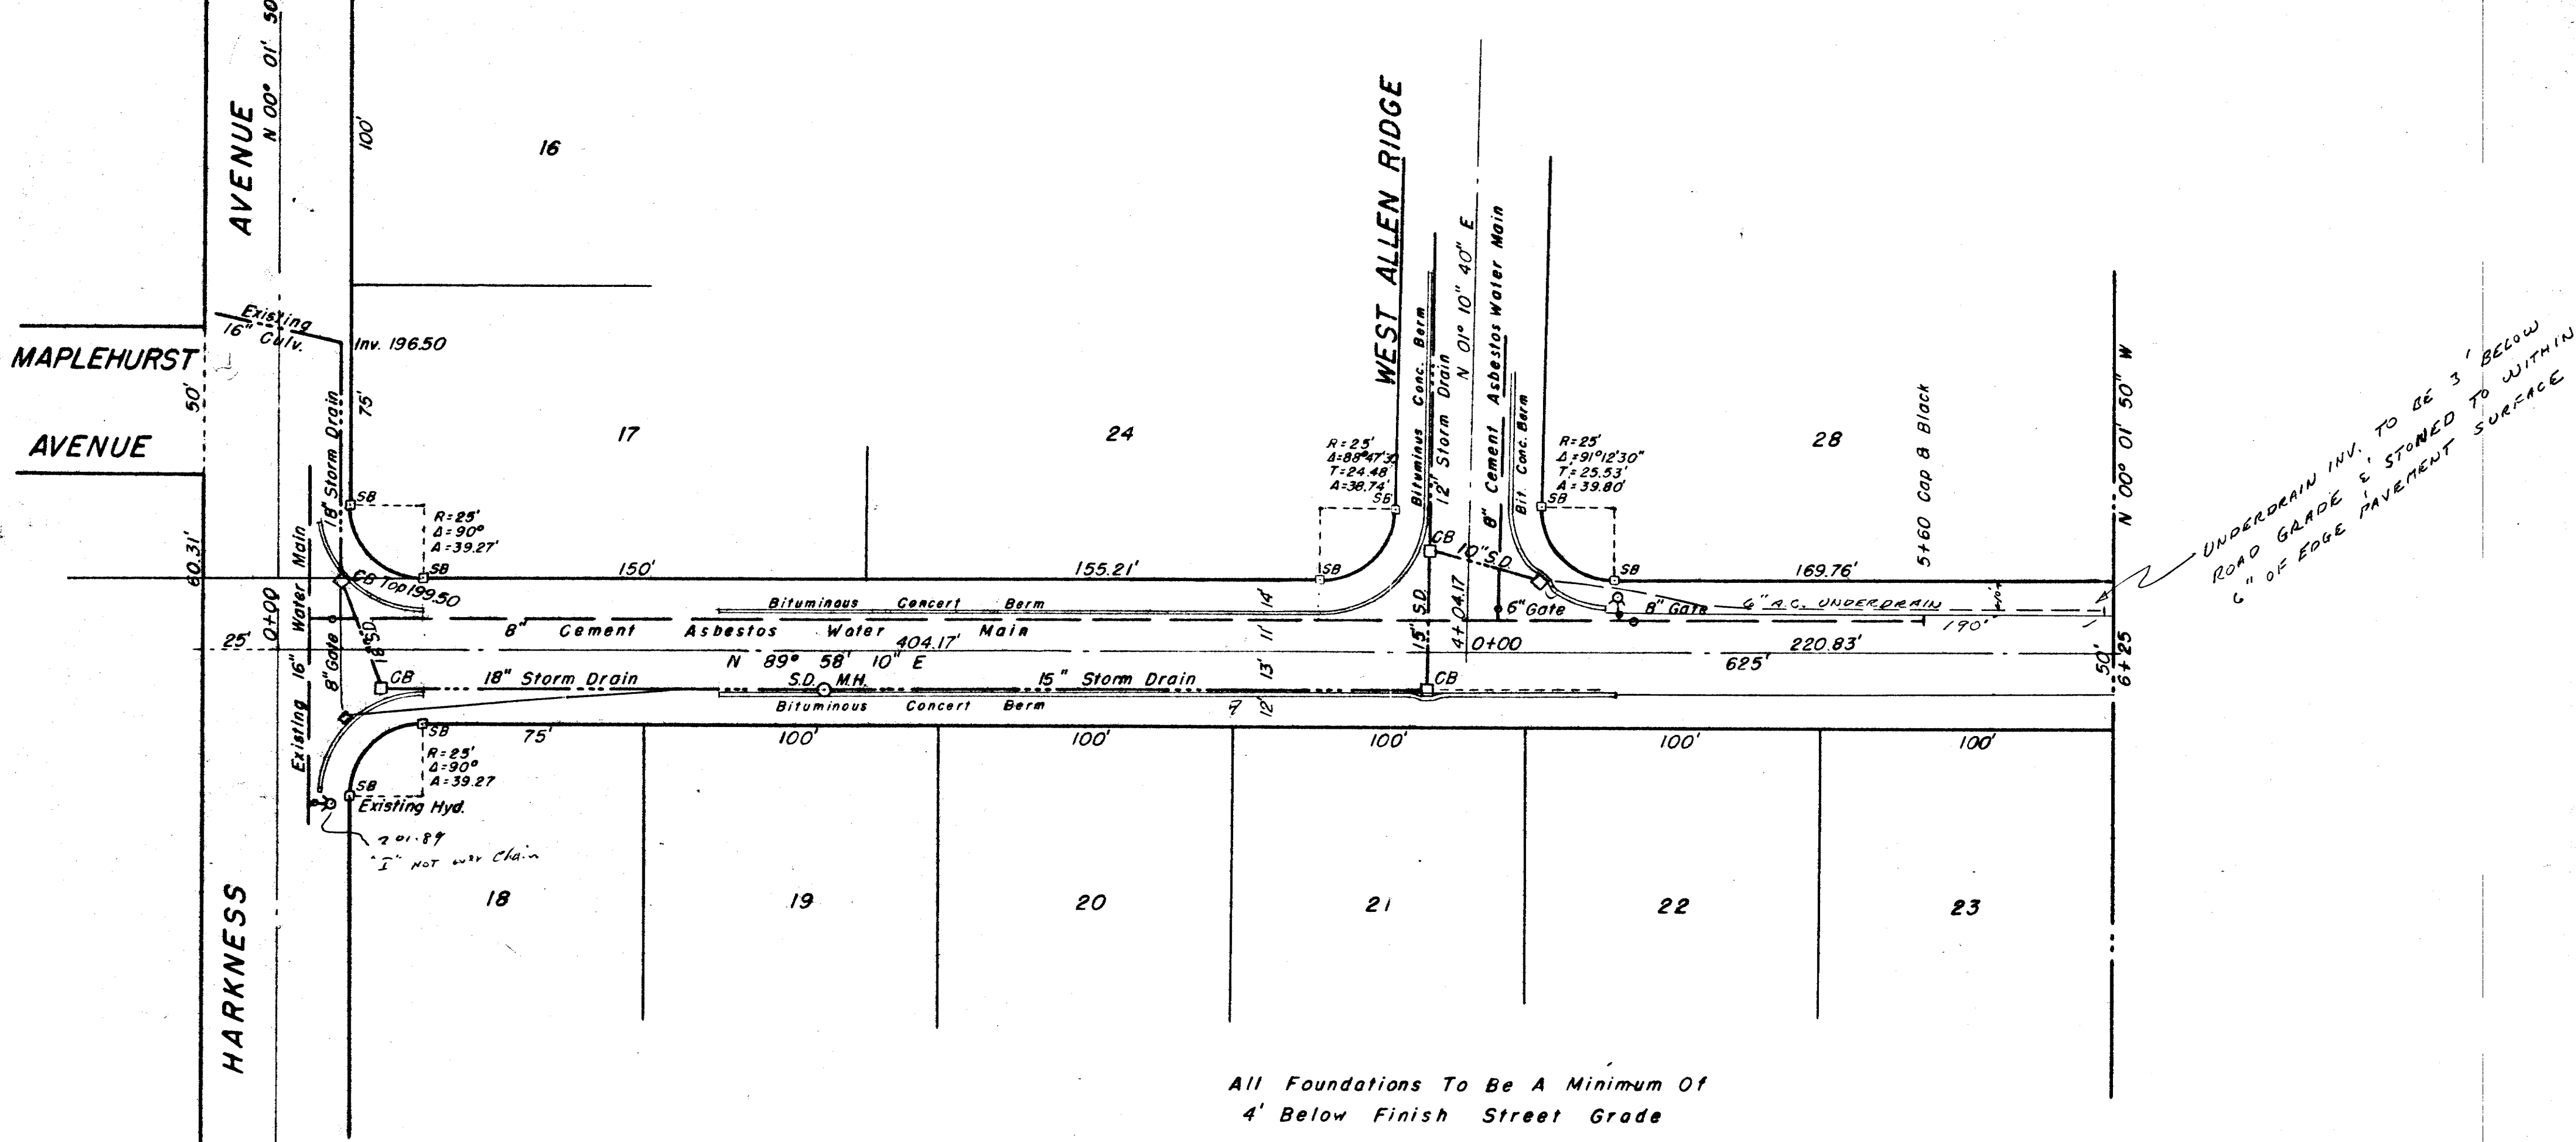