


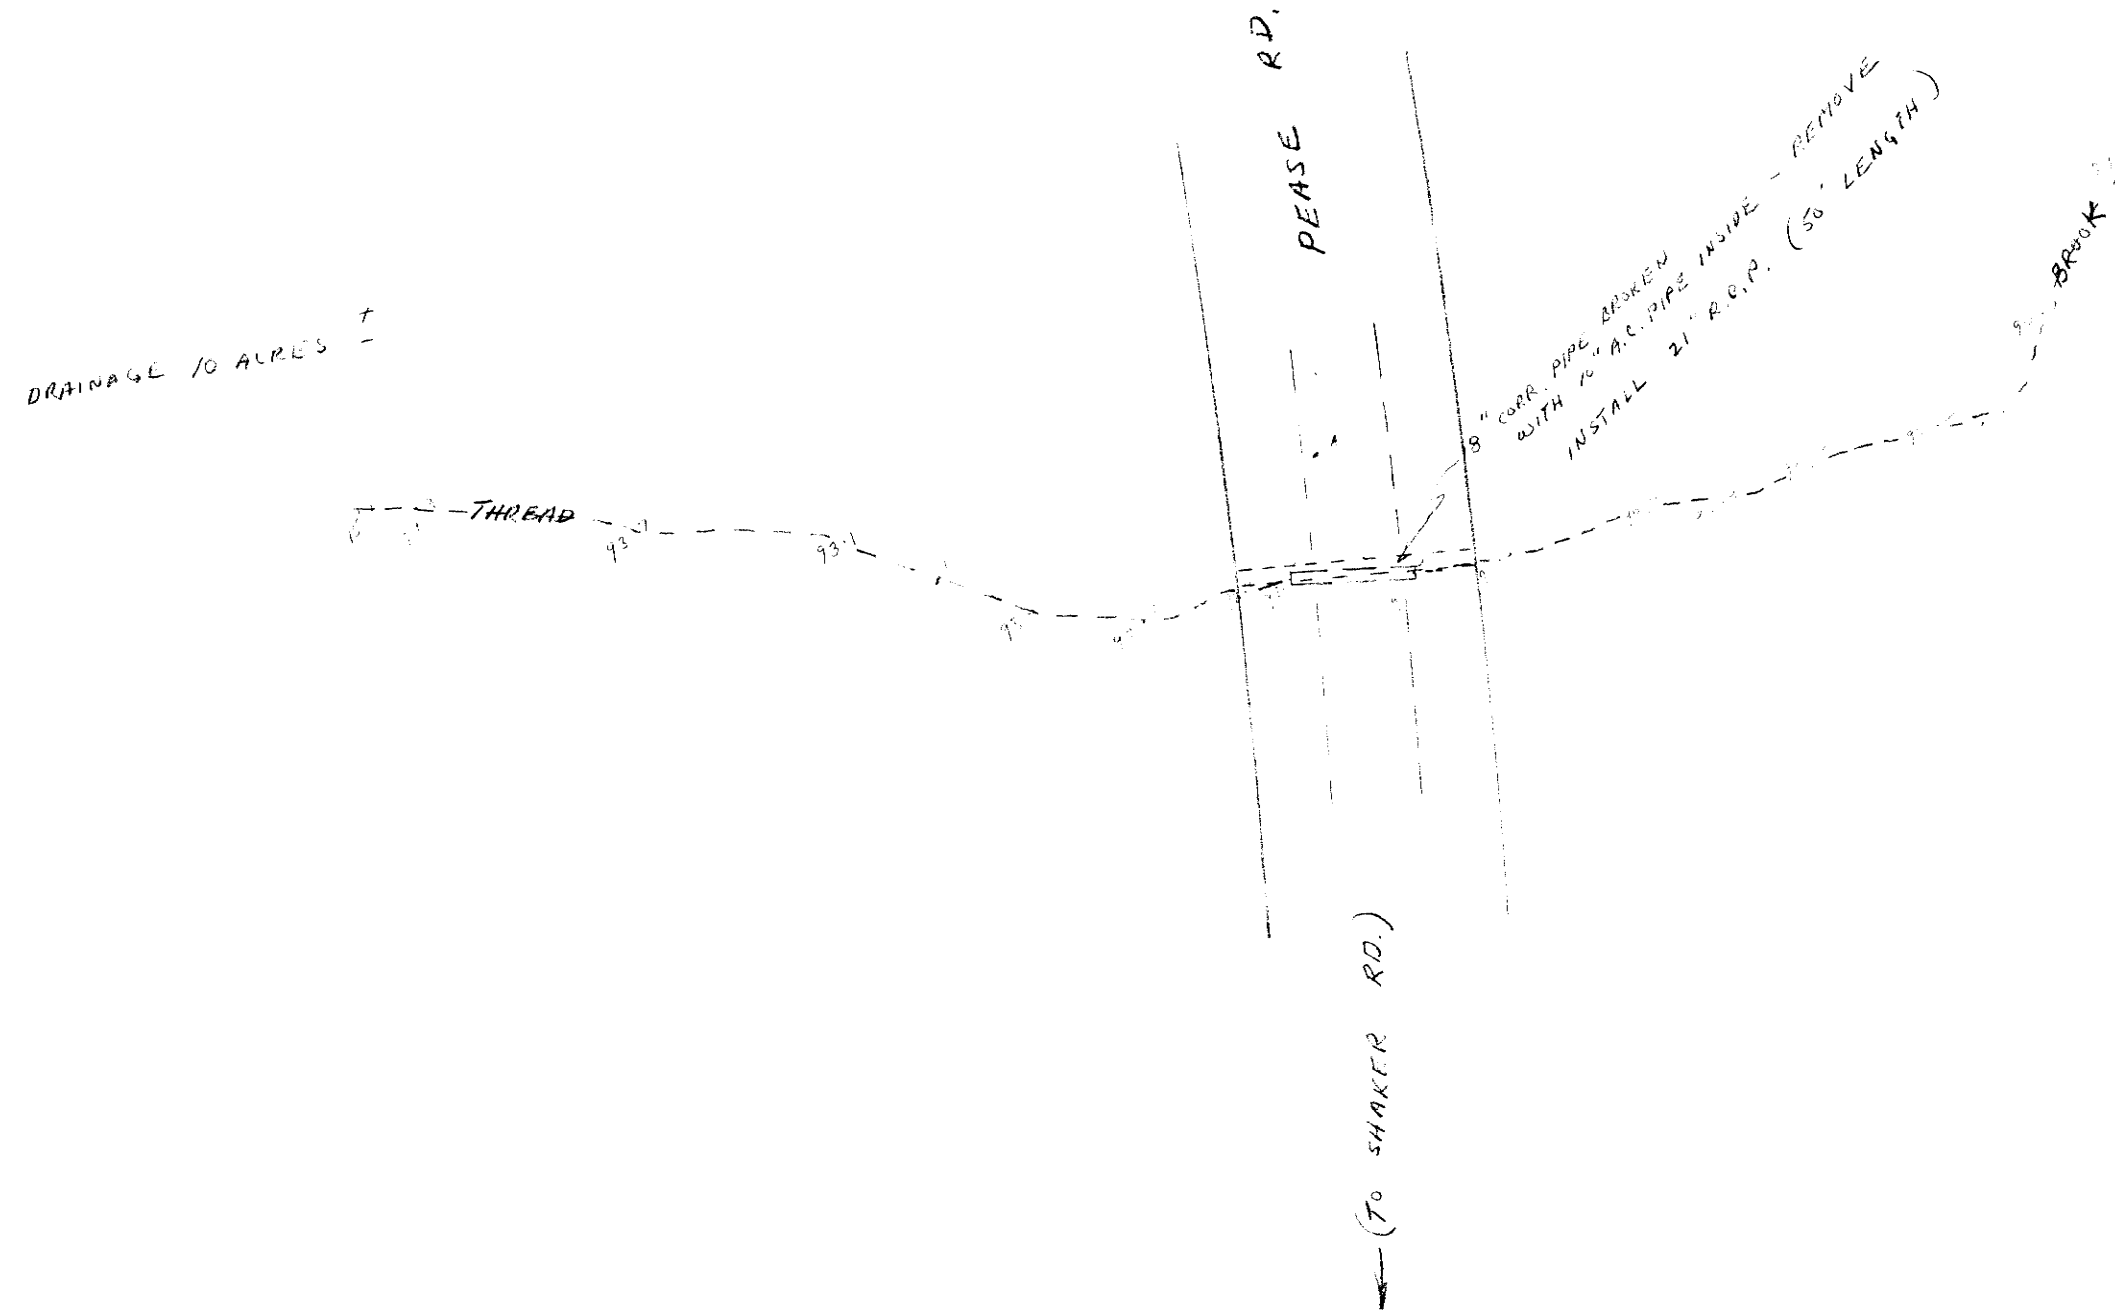

PLAN & PROFILE
 BROOK (PEASE RD. BETWEEN SHAKER & PROSPECT)
 1" = 40' HOR.
 SCALE: 1" = 4' VERT.

