
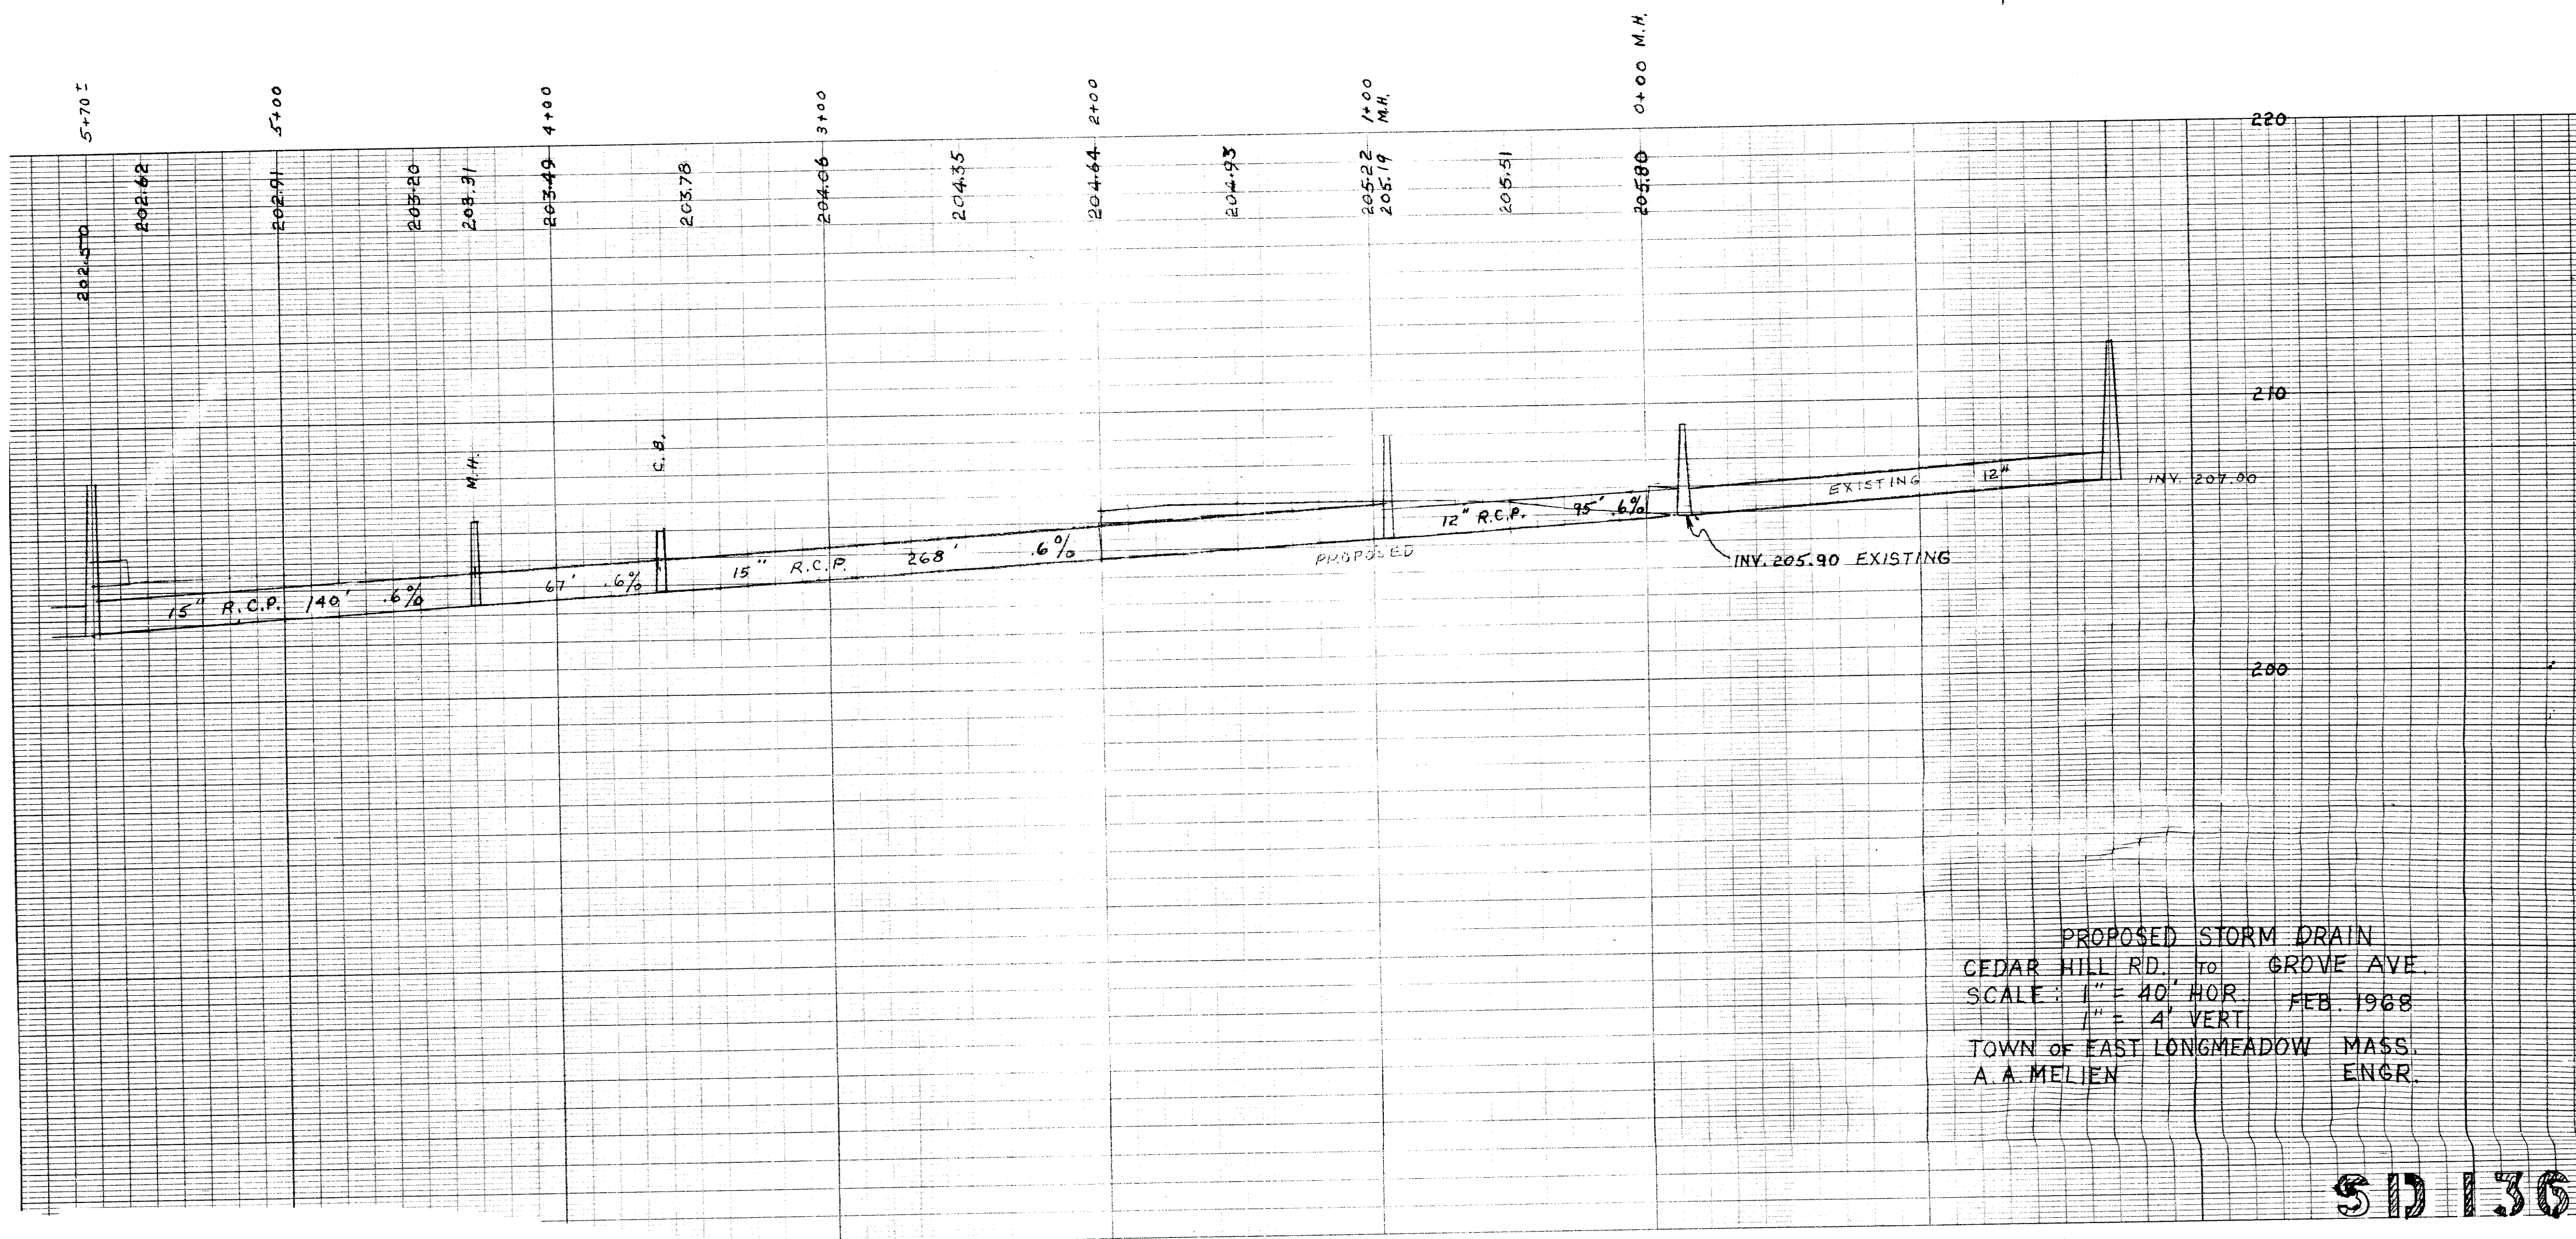


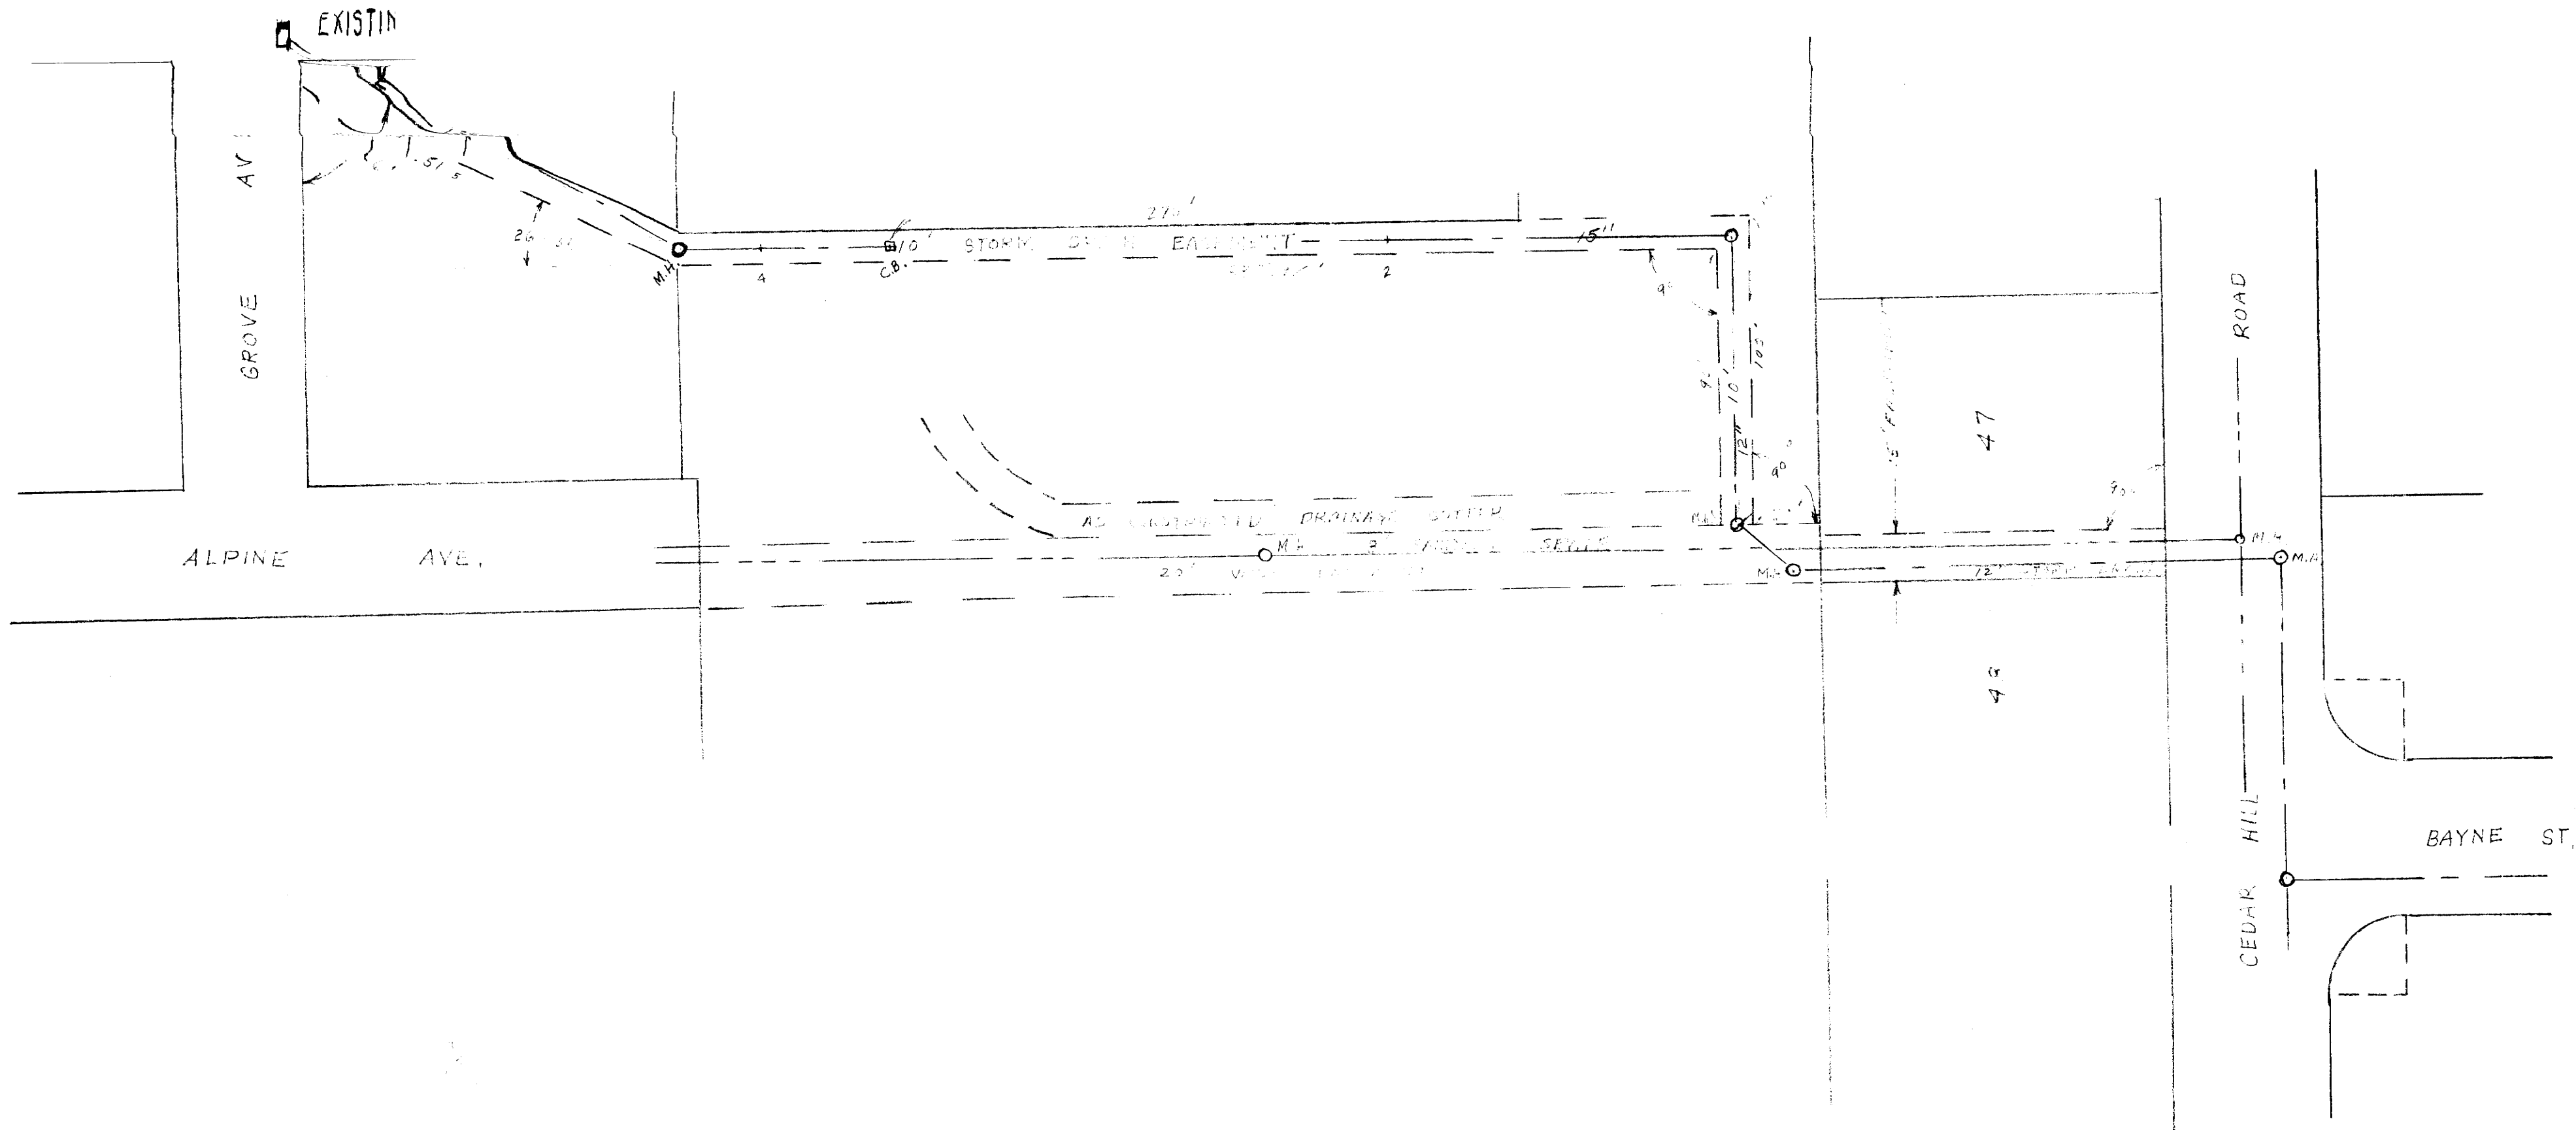

PROPOSED STORM DRAIN
 CEDAR HILL RD. to GROVE AVE.
 SCALE: 1" = 40' HOR. FEB. 1968
 1" = 4' VERT
 TOWN OF EAST LONGMEADOW MASS.
 A. A. MELIEN ENGR.