



RIDGE RD.

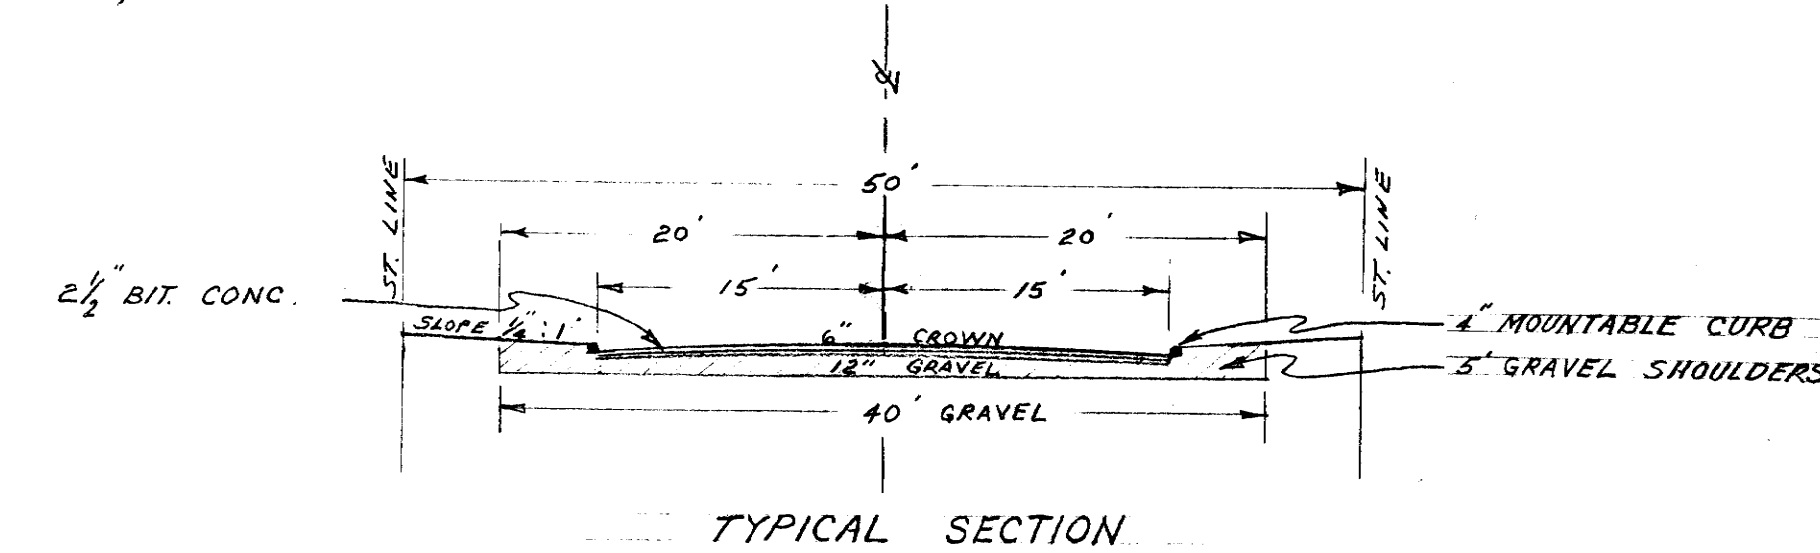

PLAN & PROFILE  
FOR  
PROPOSED RECONSTRUCTION  
PORTER ROAD  
DARTMOUTH, MASS.  
SCALE 1" = 40' H.P. 1" = 10' V.P. 1971  
A.A. MELLON ENGINEER

SHEET 1 OF 3

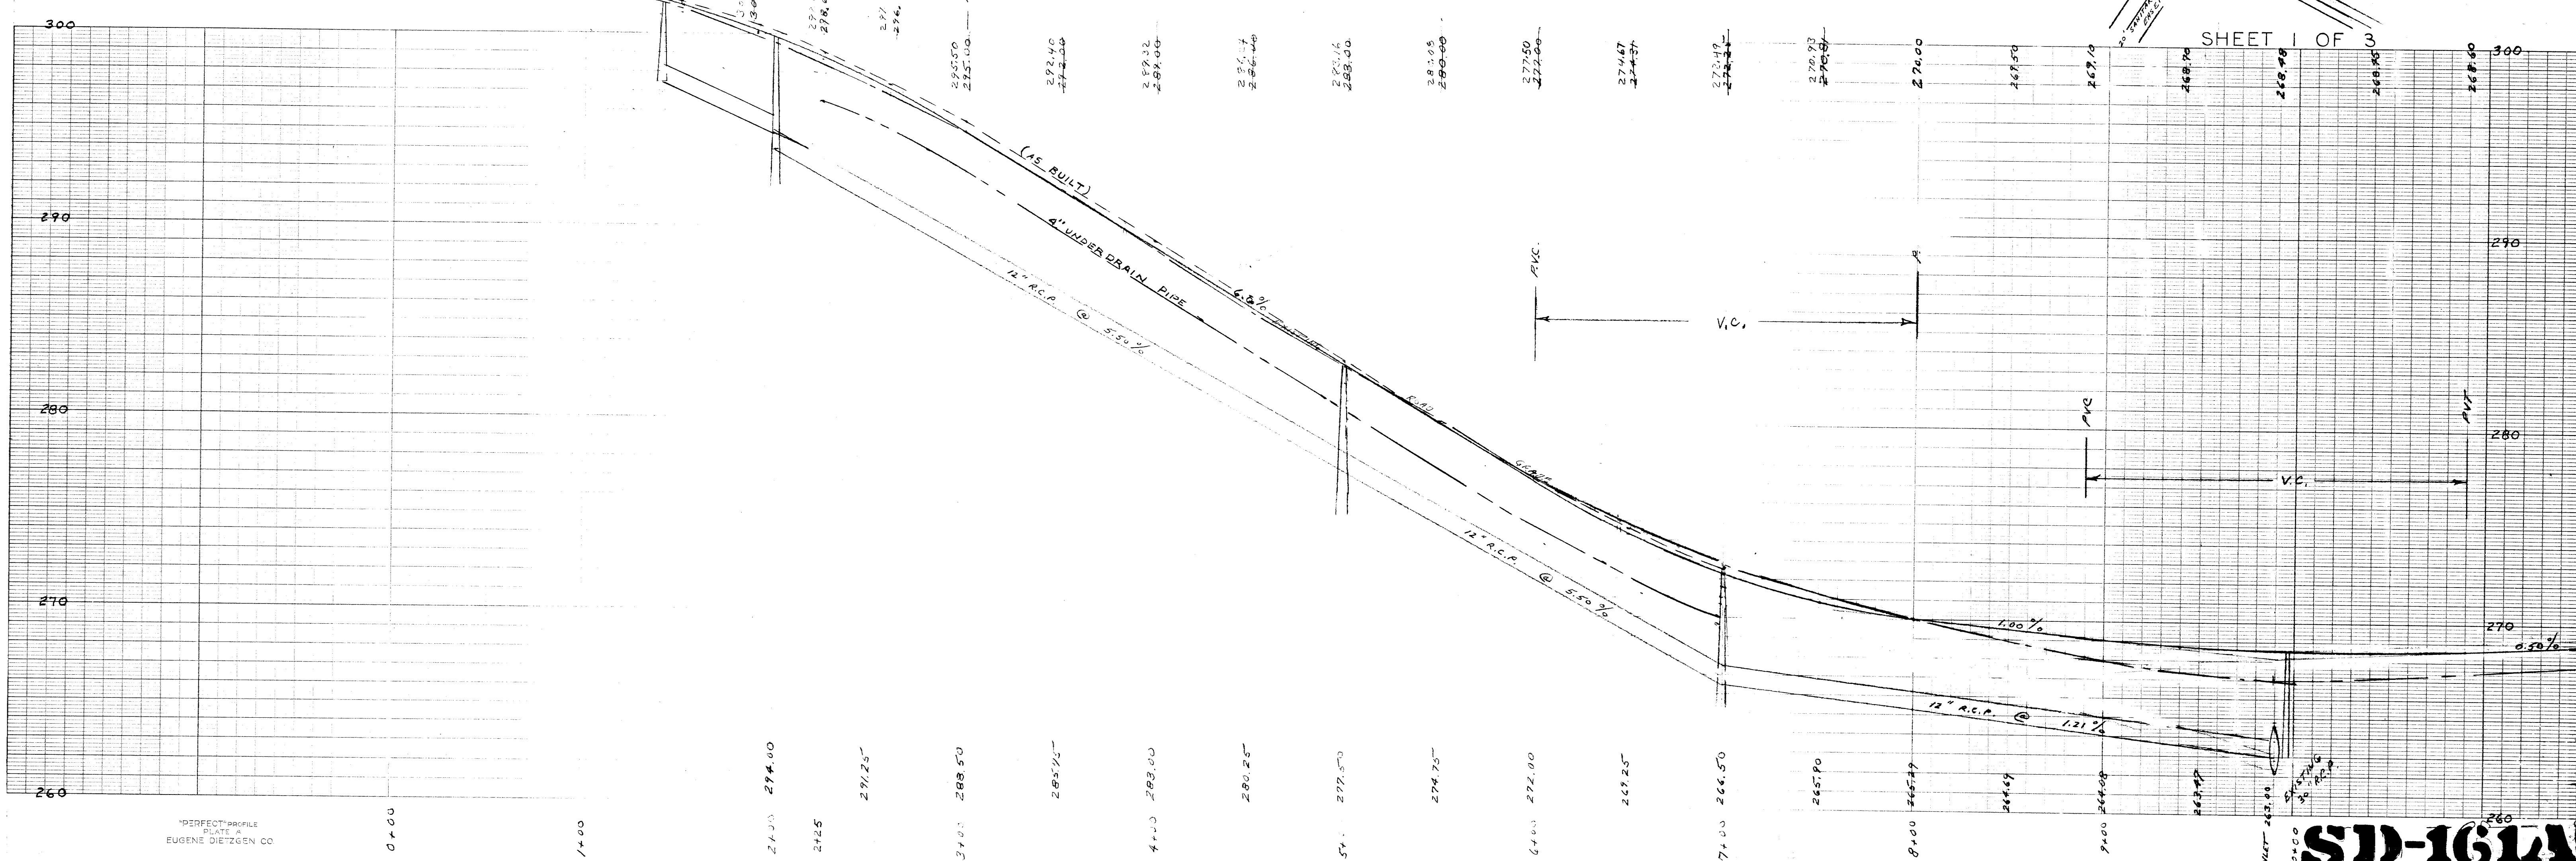

"PERFECT" PROFILE  
PLATE A  
EUGENE DIEZGEN CO.

SD-161A