



STORM DRAIN LAYOUT

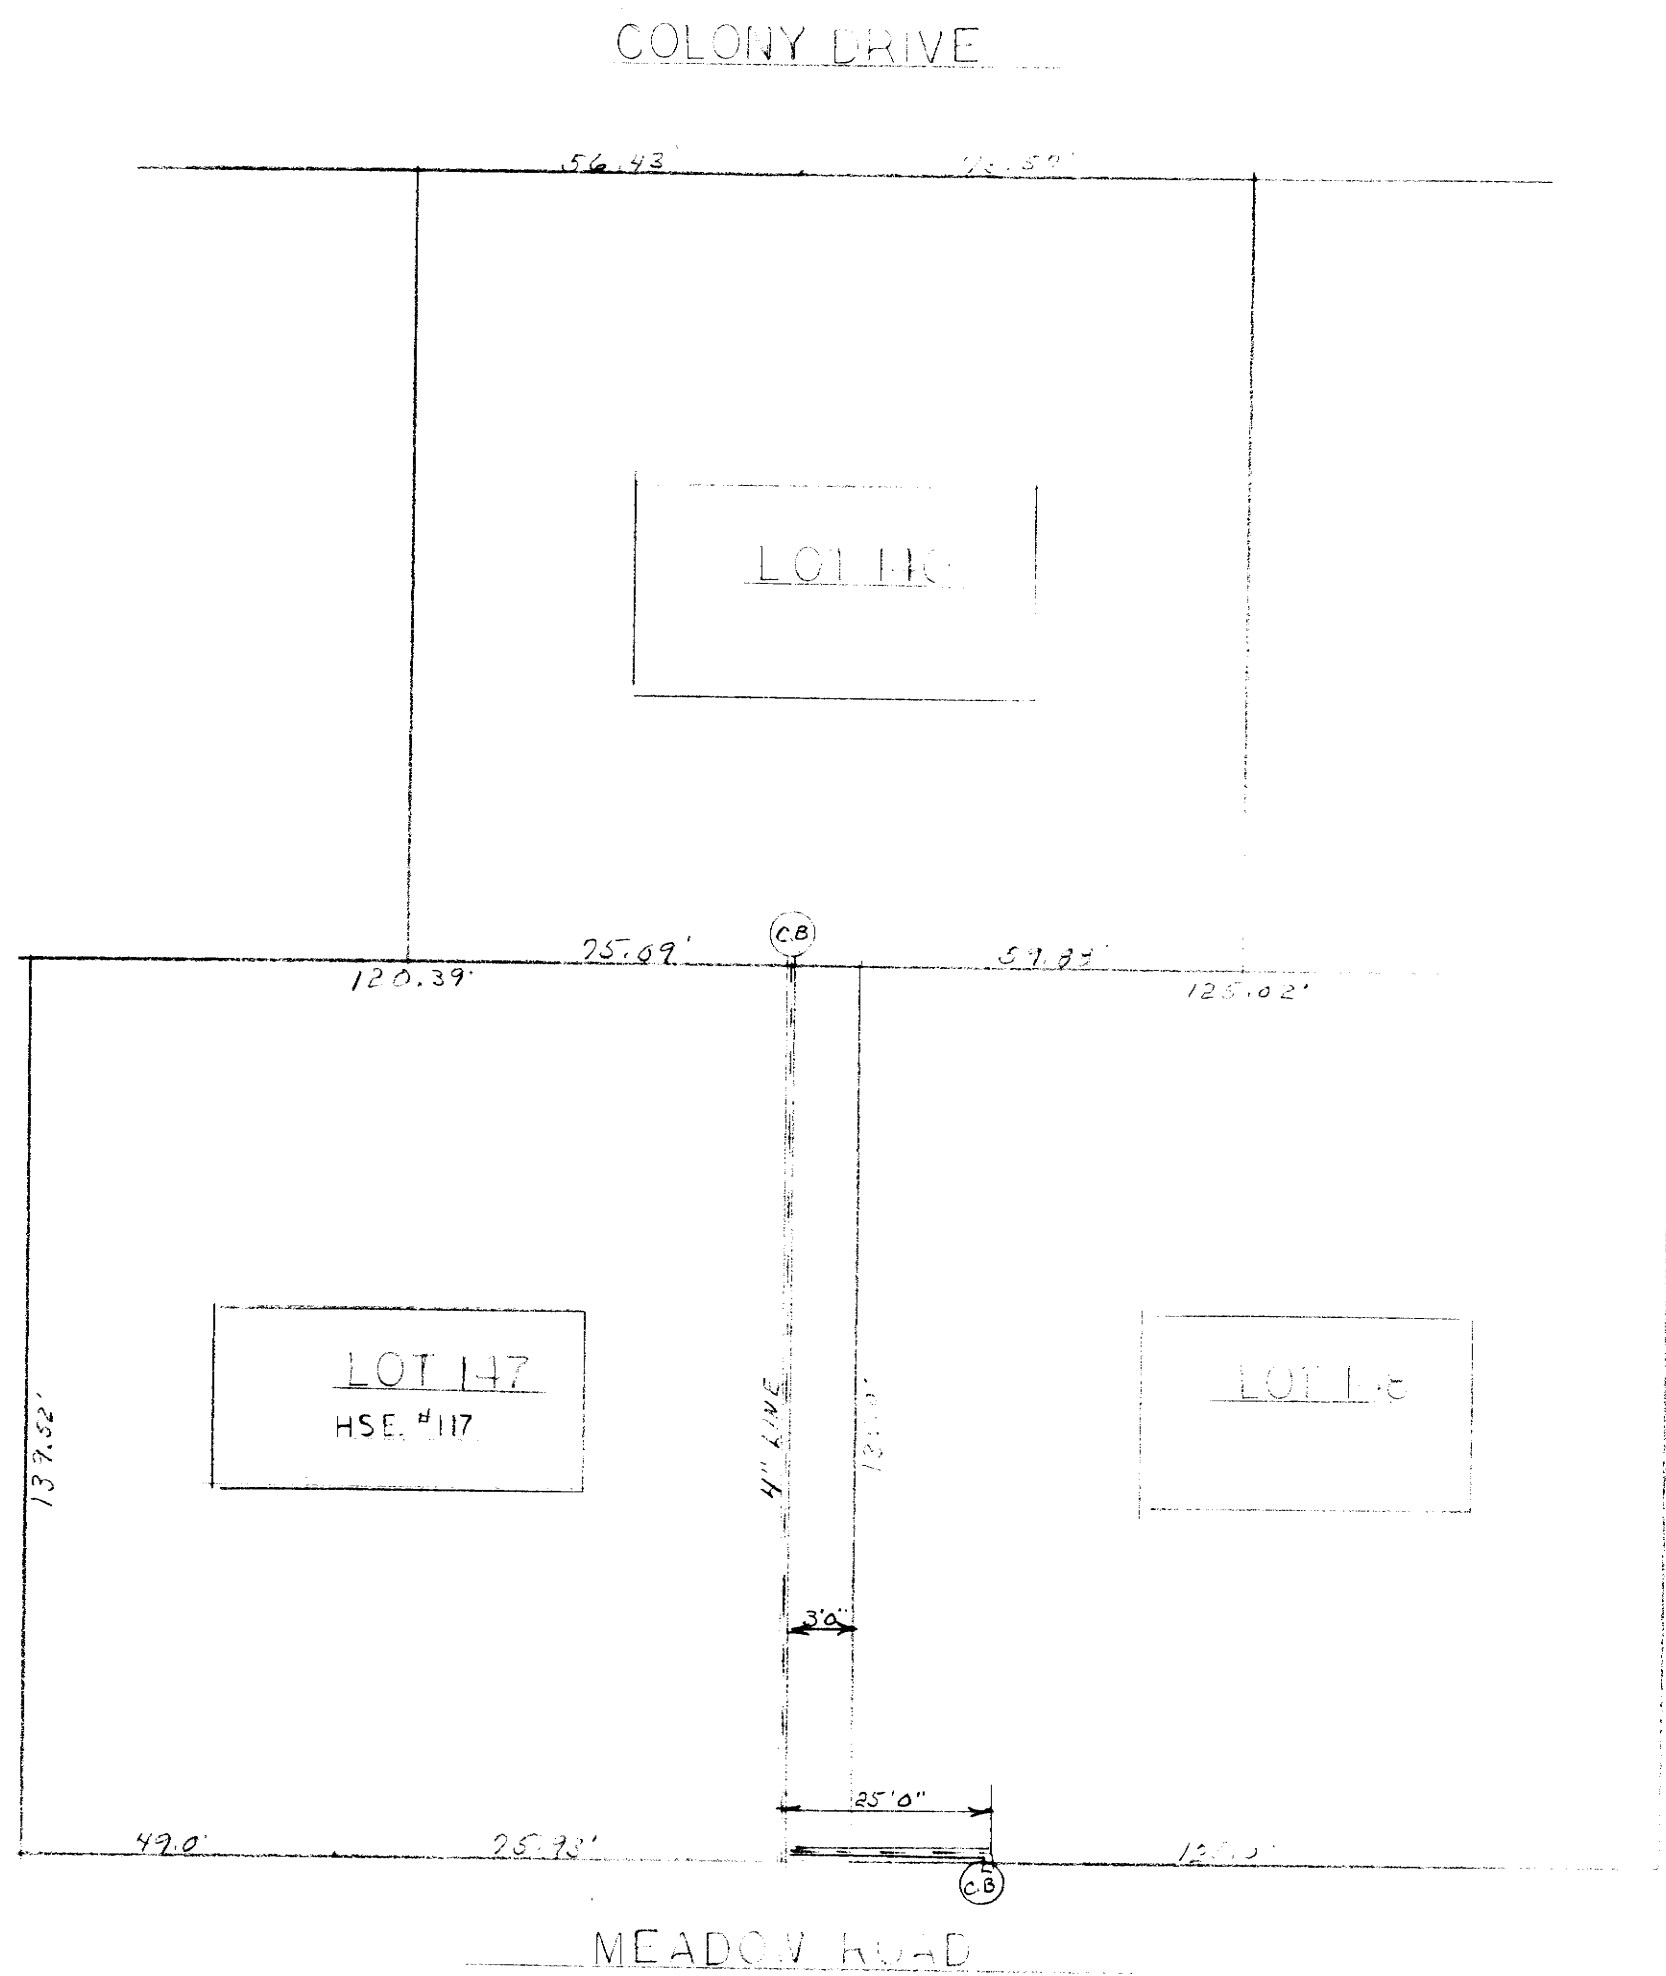

SCALE 1" = 30' 0"

STORM DRAIN LAYOUT

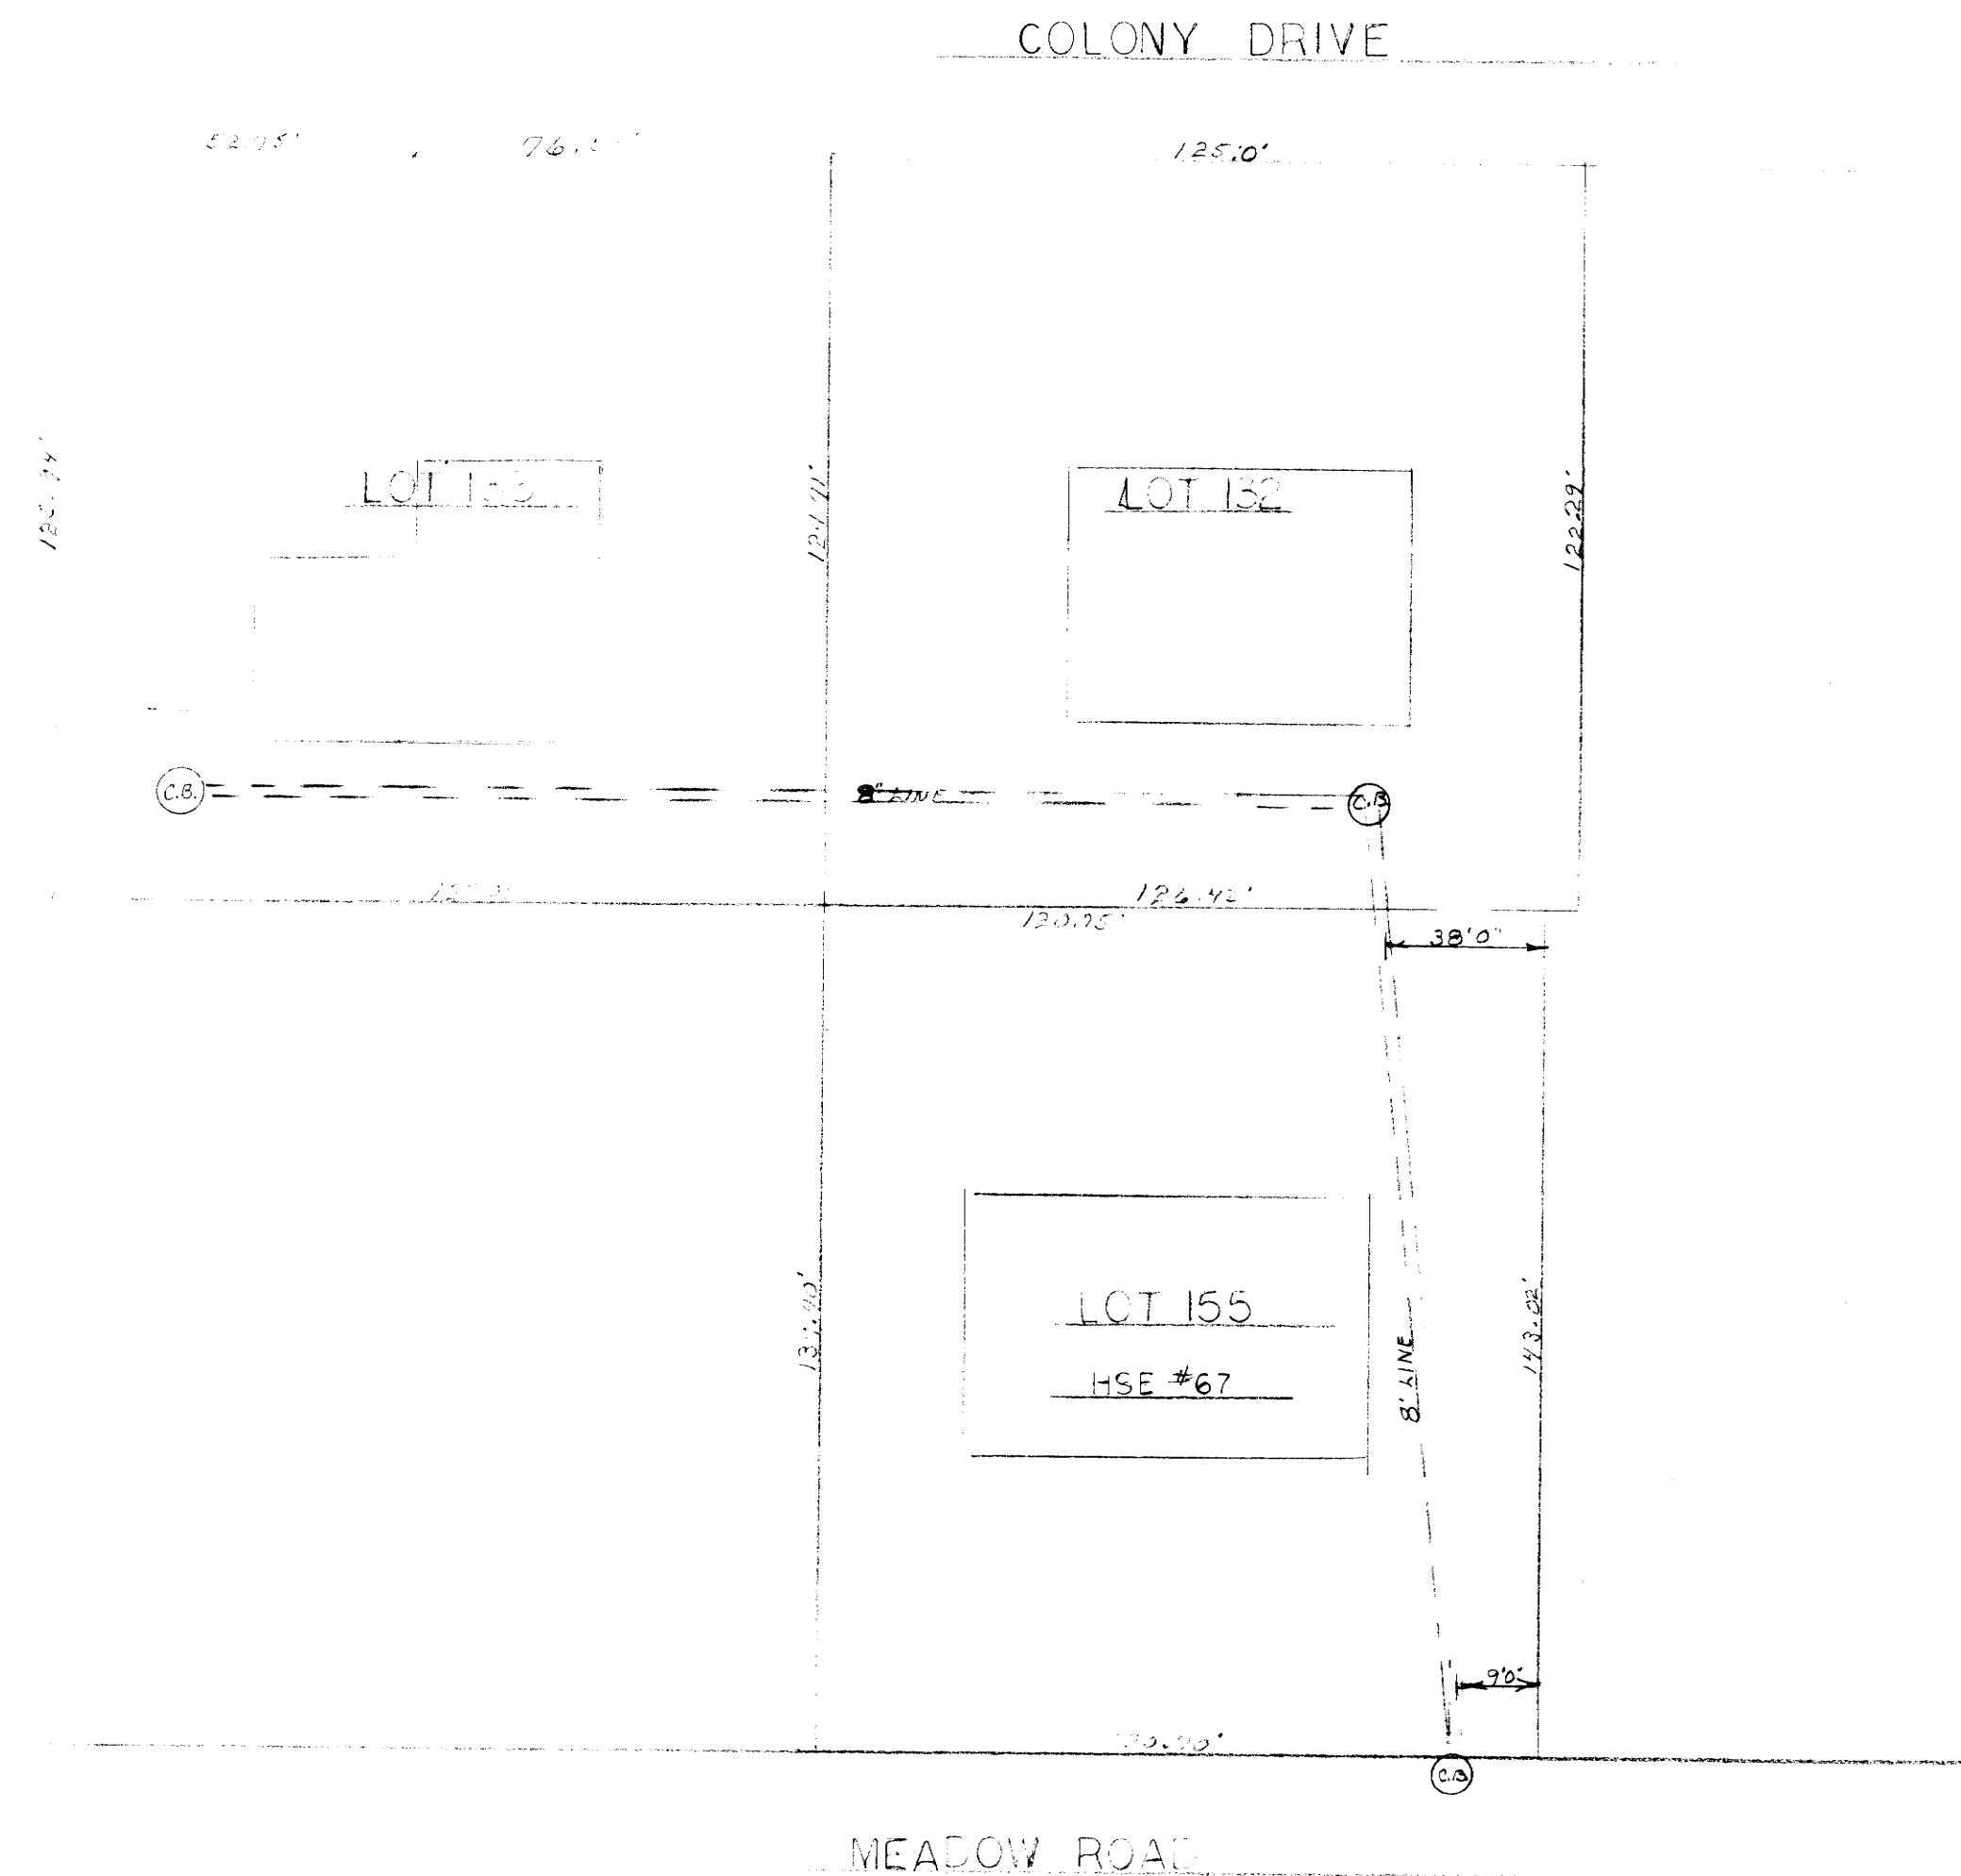

SCALE 1" = 30' 0"

(PRIVATE DRAINS)

SD 167