



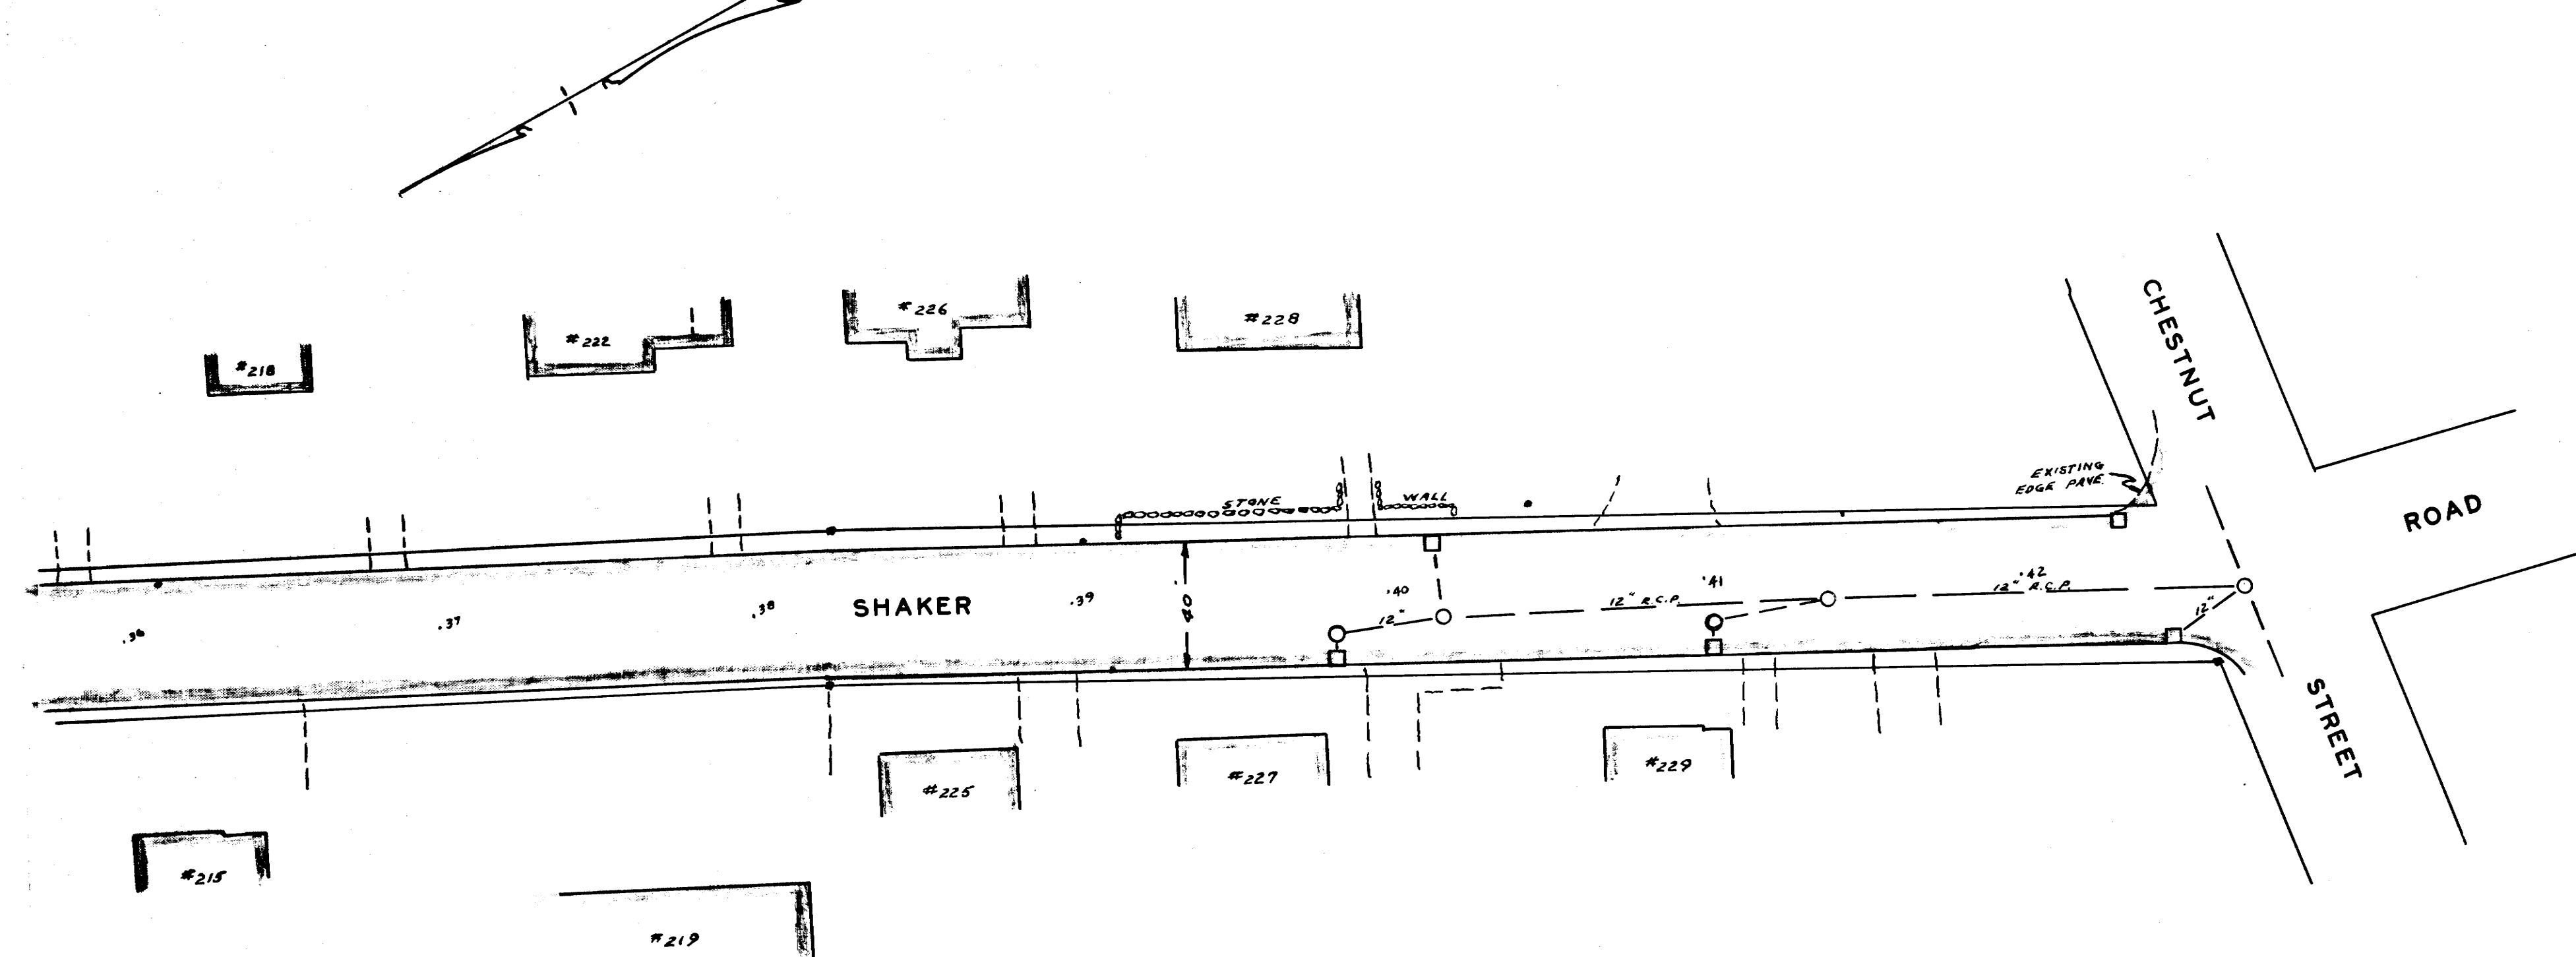

PLAN & PROFILE
SHAKER ROAD
EAST LONGMEADOW MASS.
SCALE: 1" = 40' HOR. JAN. 1973
1" = 4' VERT.
A.A. MELIEN TOWN ENG'R.

SHEET 4 OF 4

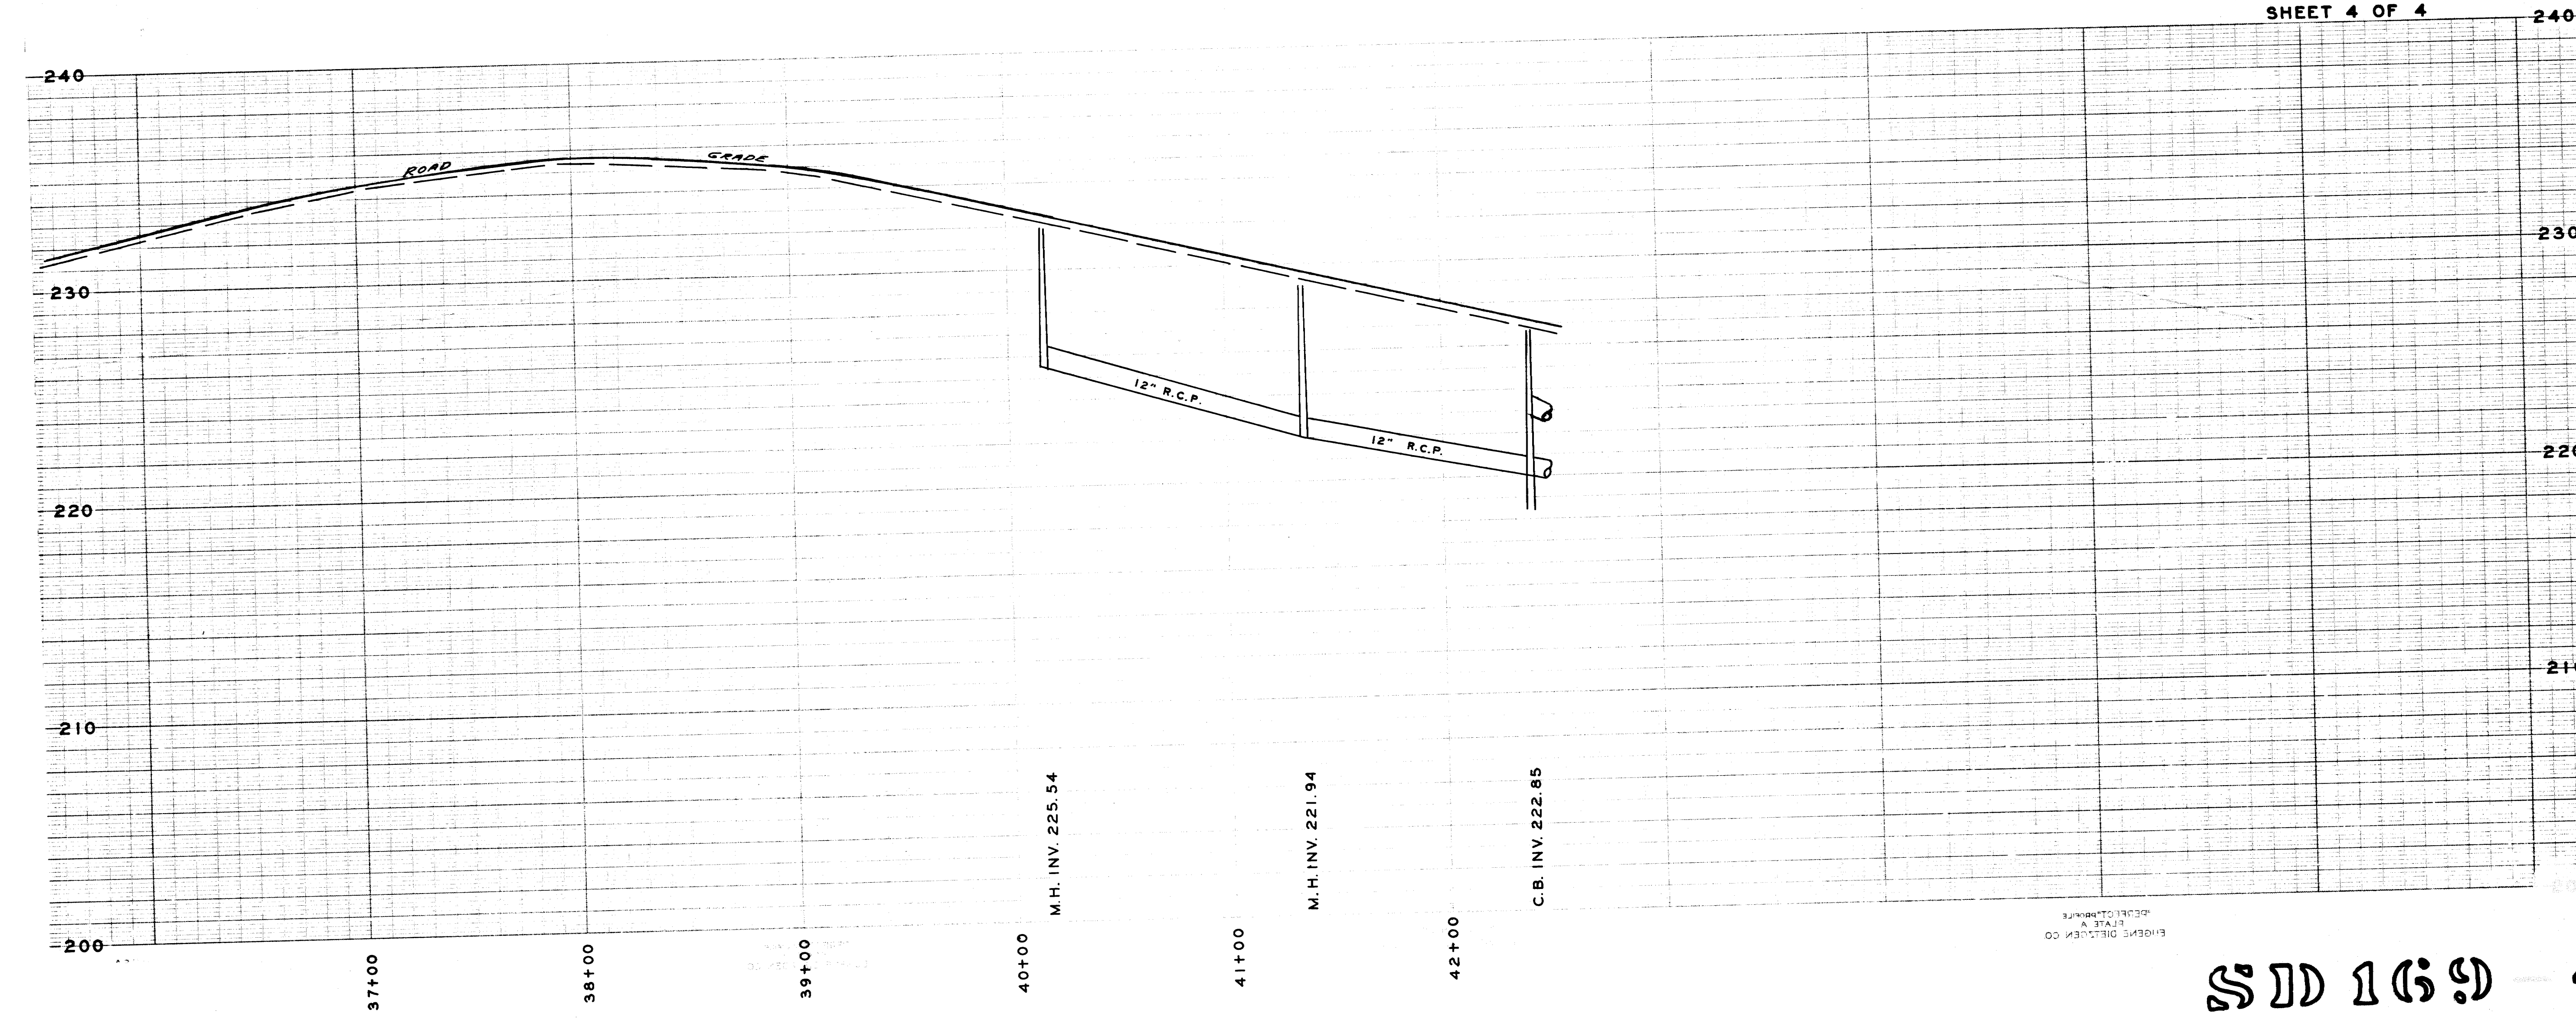

SD 169