



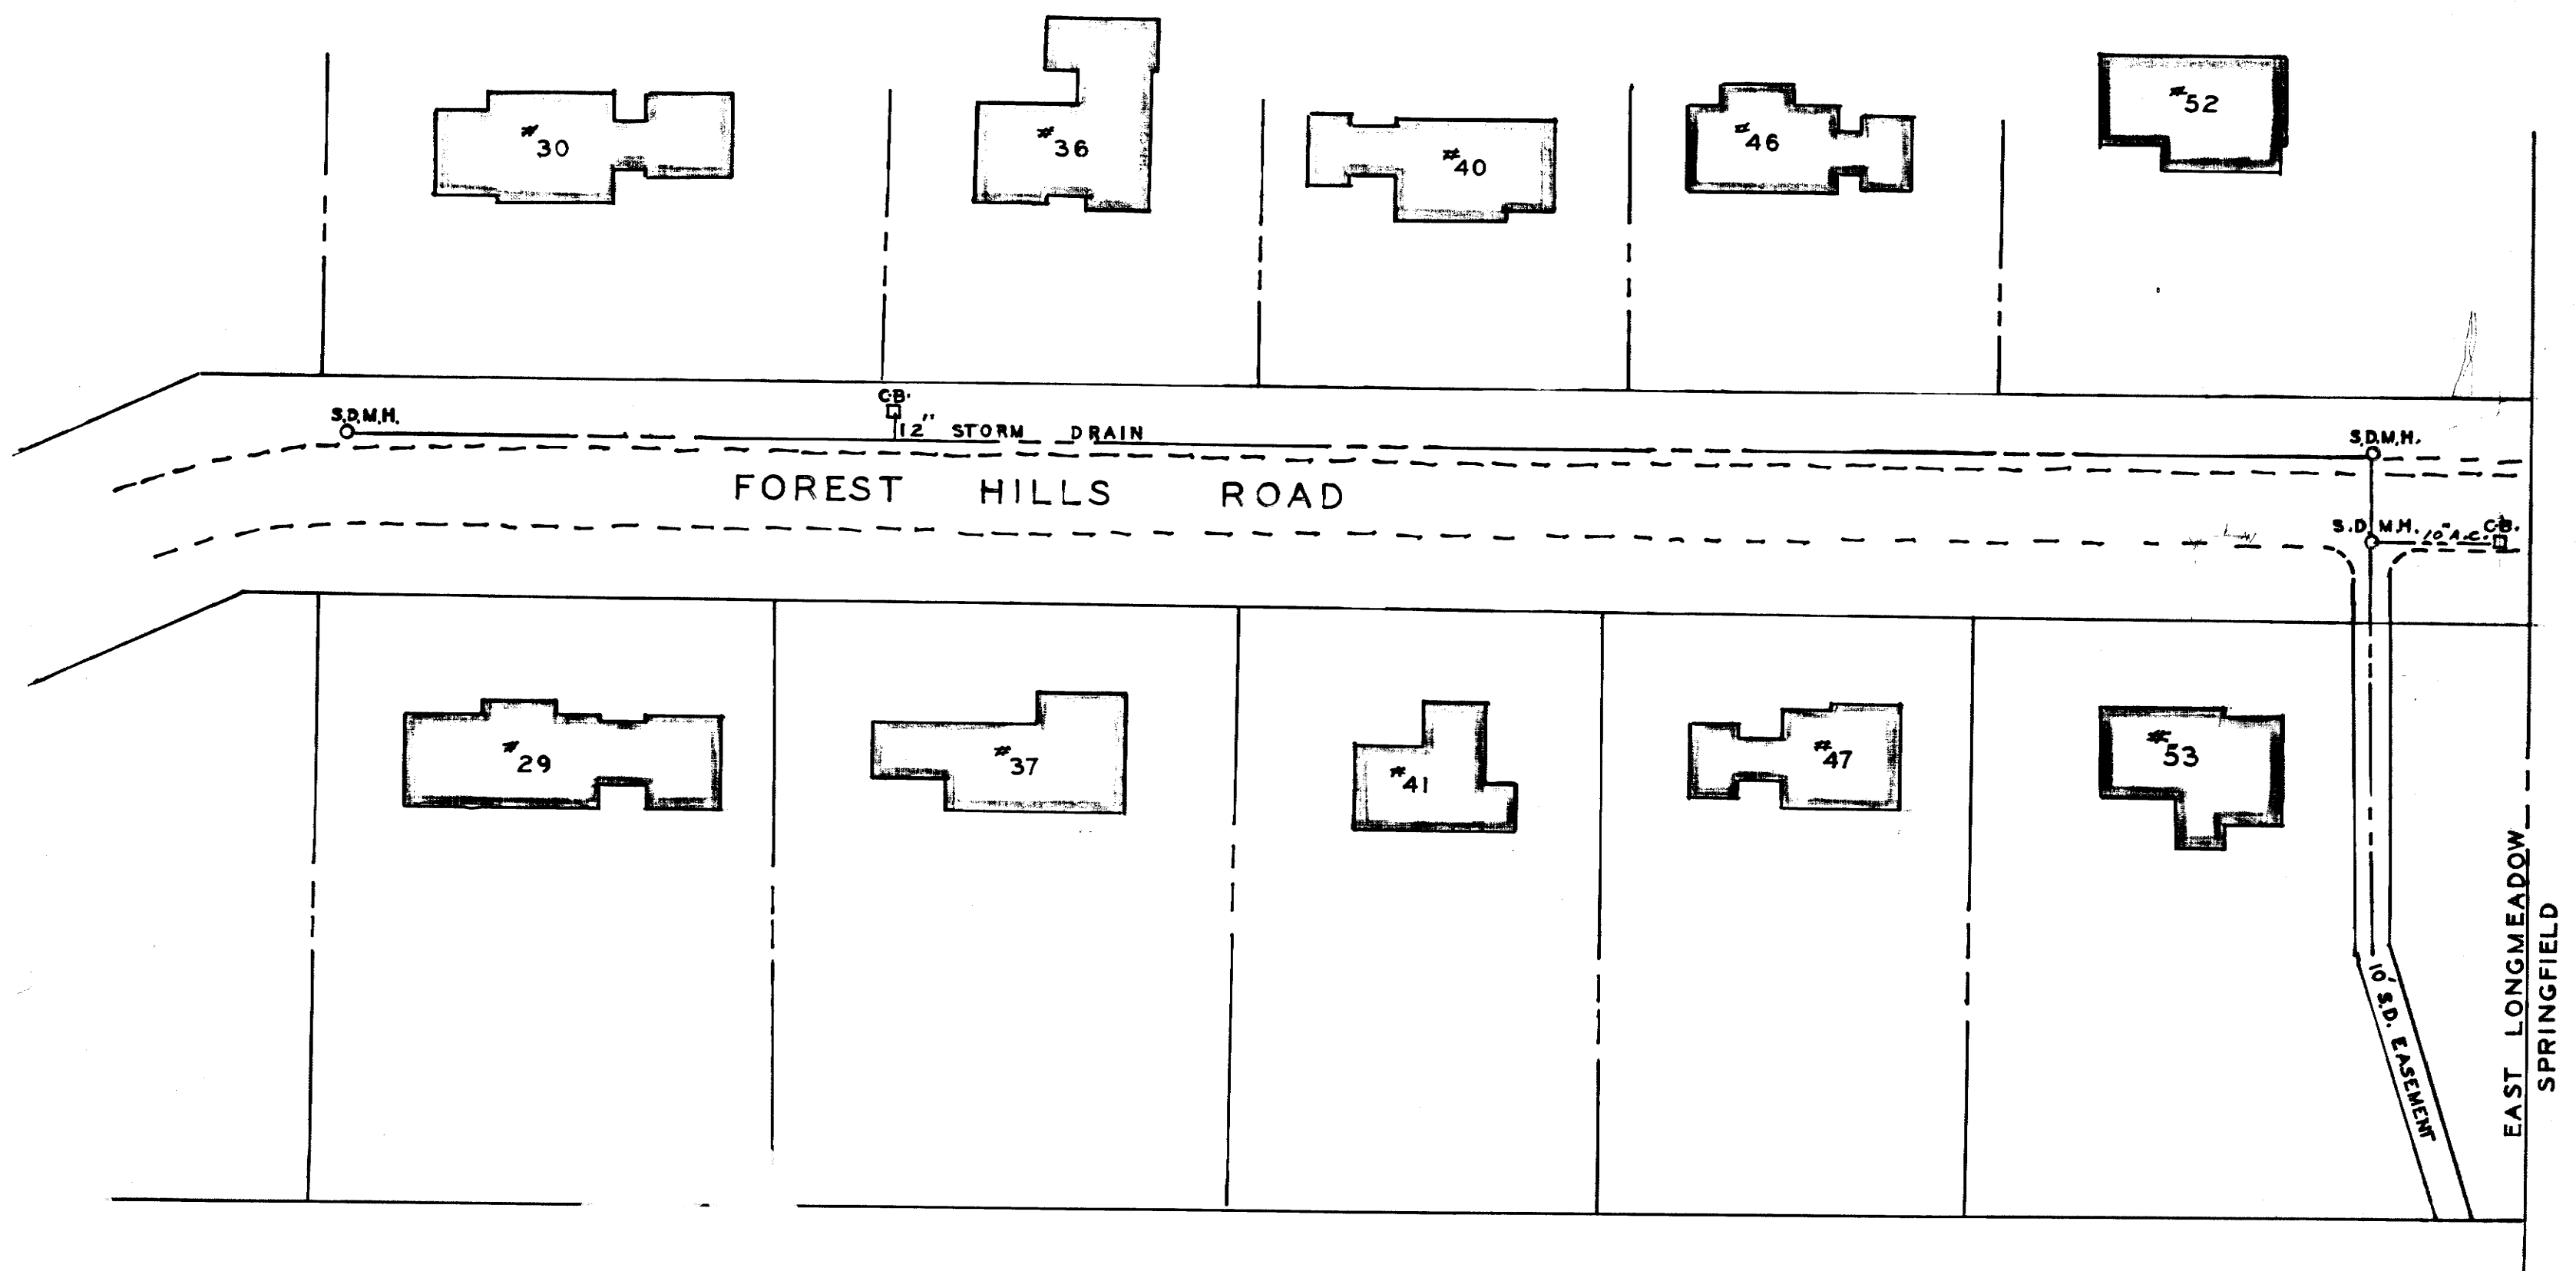

STORM DRAIN PLAN & PROFILE
FOREST HILLS ROAD
TOWN OF EAST LONGMEADOW

SCALE : 1" = 40' HOR.
1" = 4' VERT.
A. A. MELIEN.

JULY, 1975.
ENGINEER.

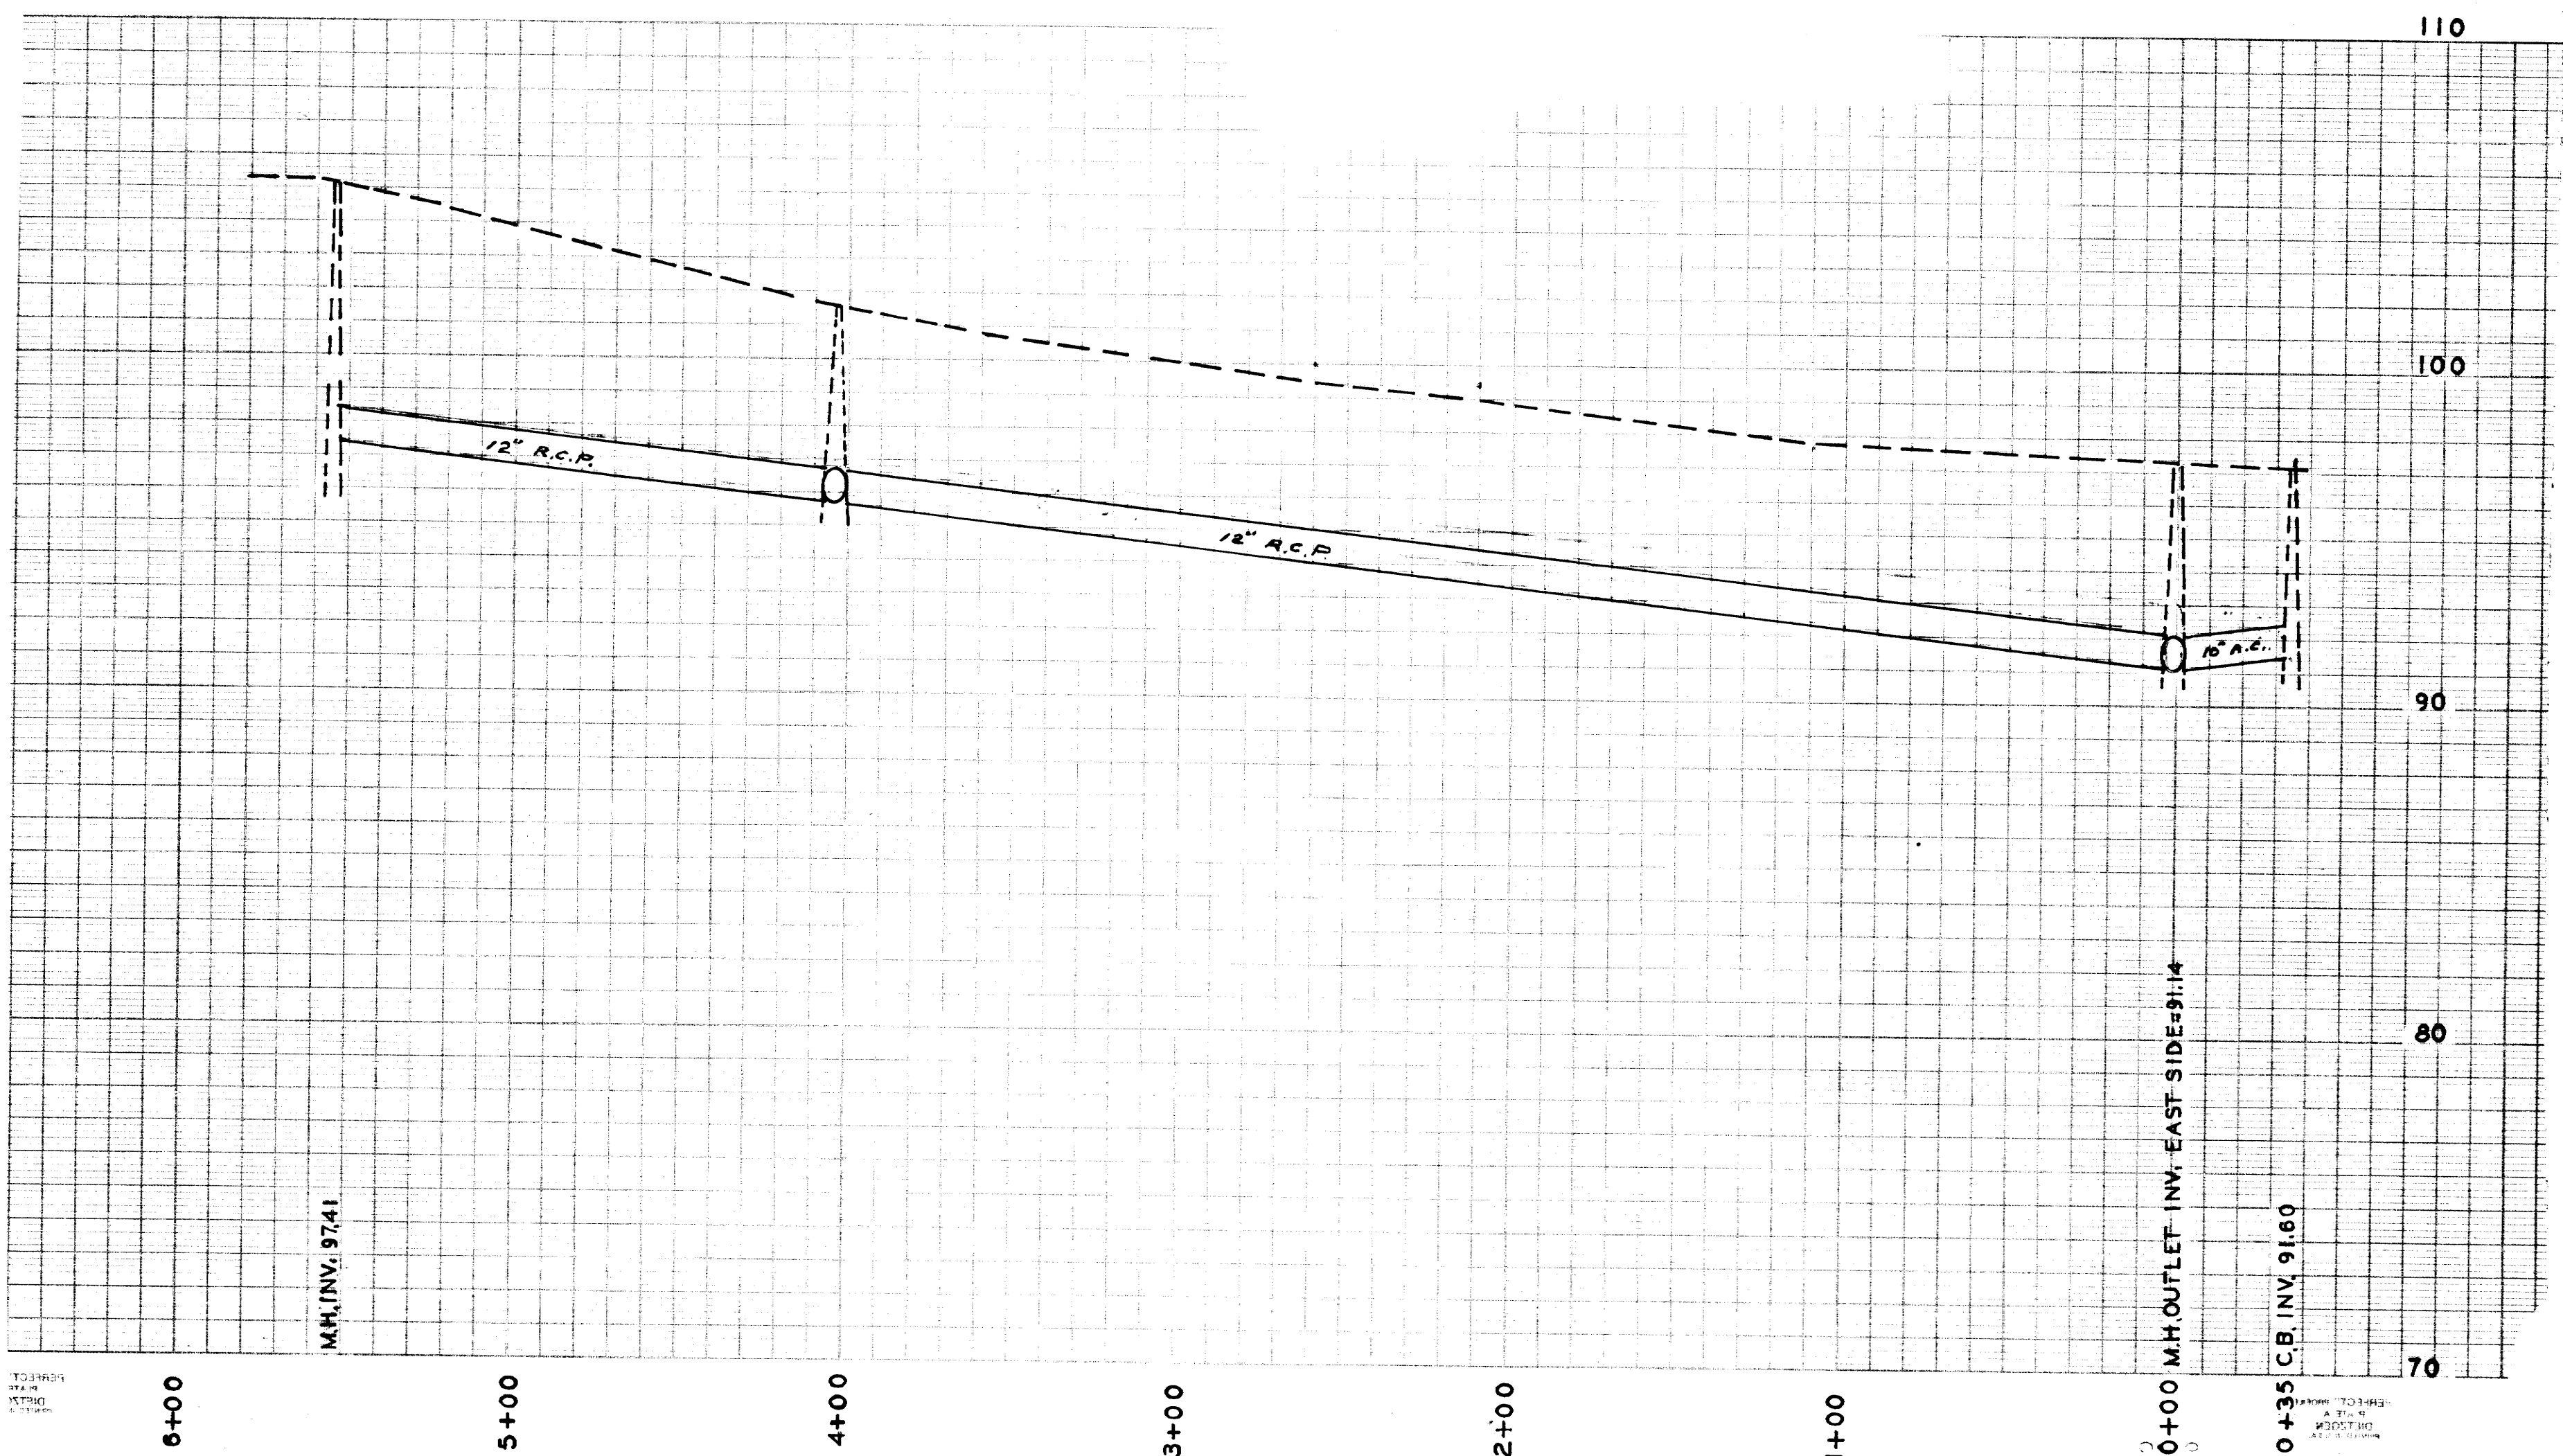

S D-176