



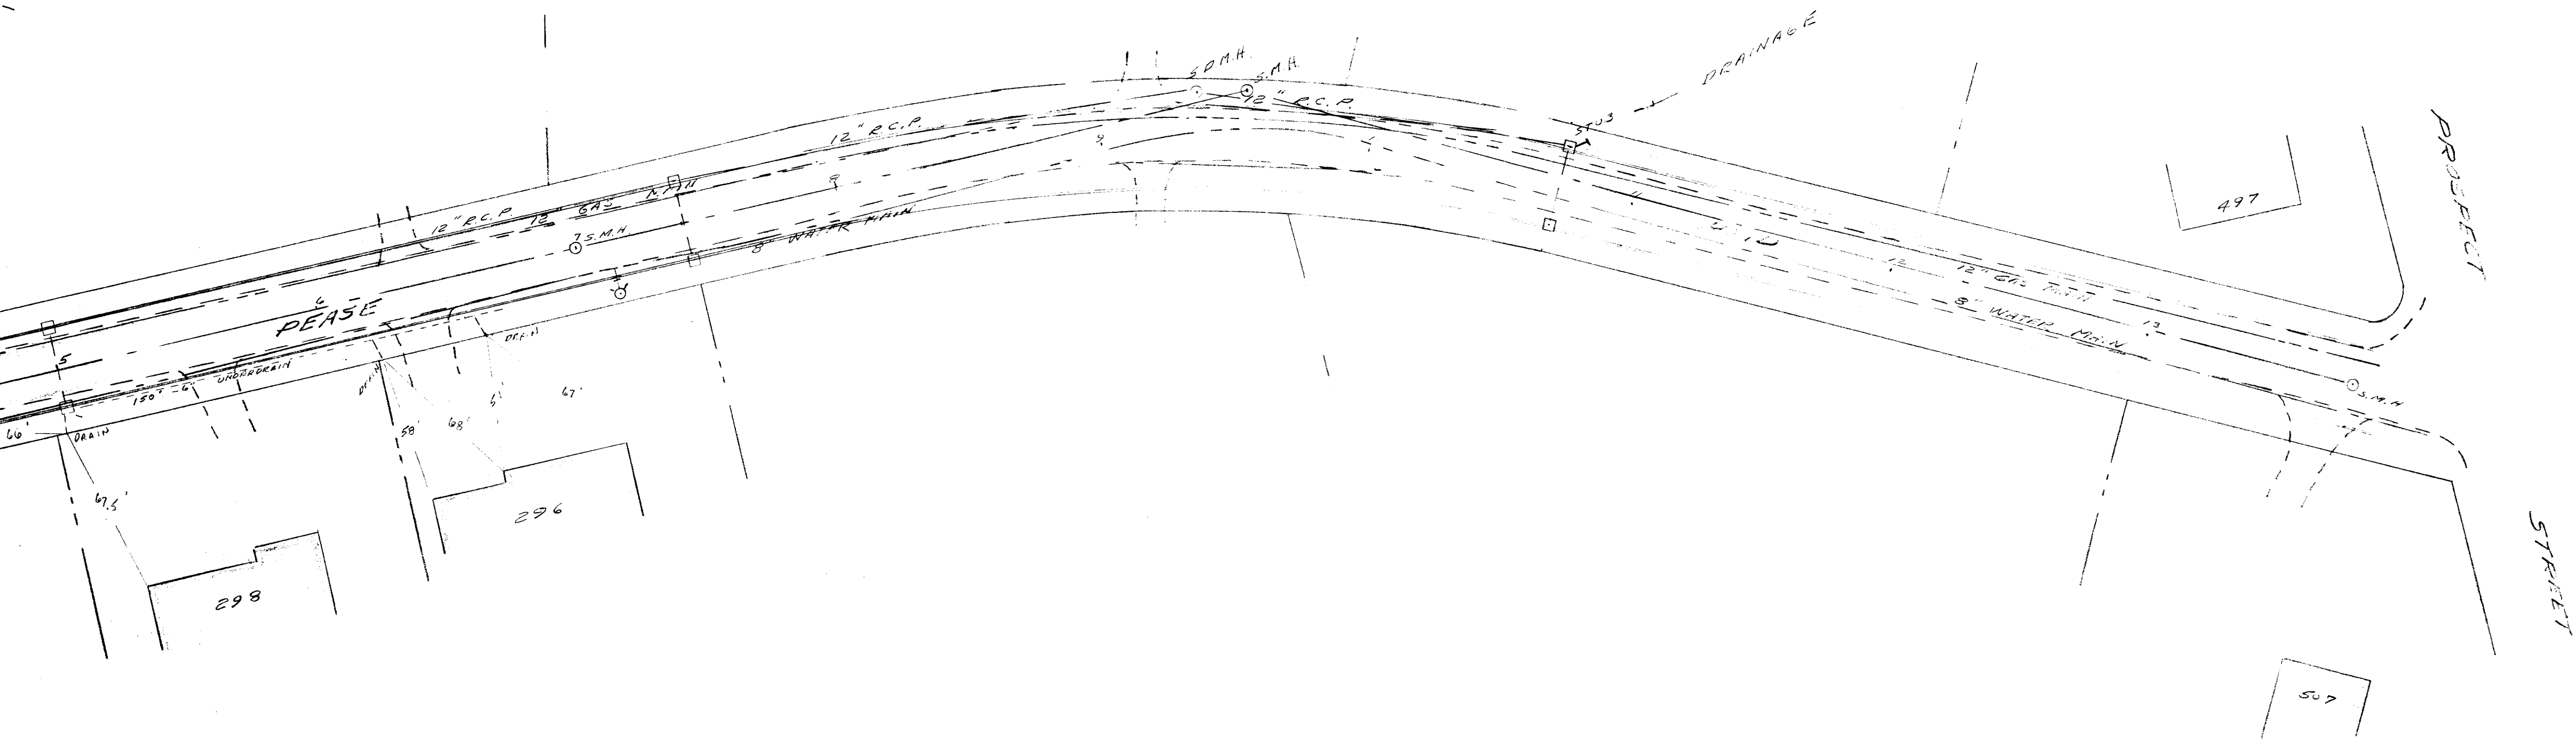

PLAN & PROFILE FOR ST.
PEASE ROAD
EAST LONGMEADOW
SCALE: 1" = 40' HORIZ.
1" = 4' VERT.
A. A. MELIEN TOWN

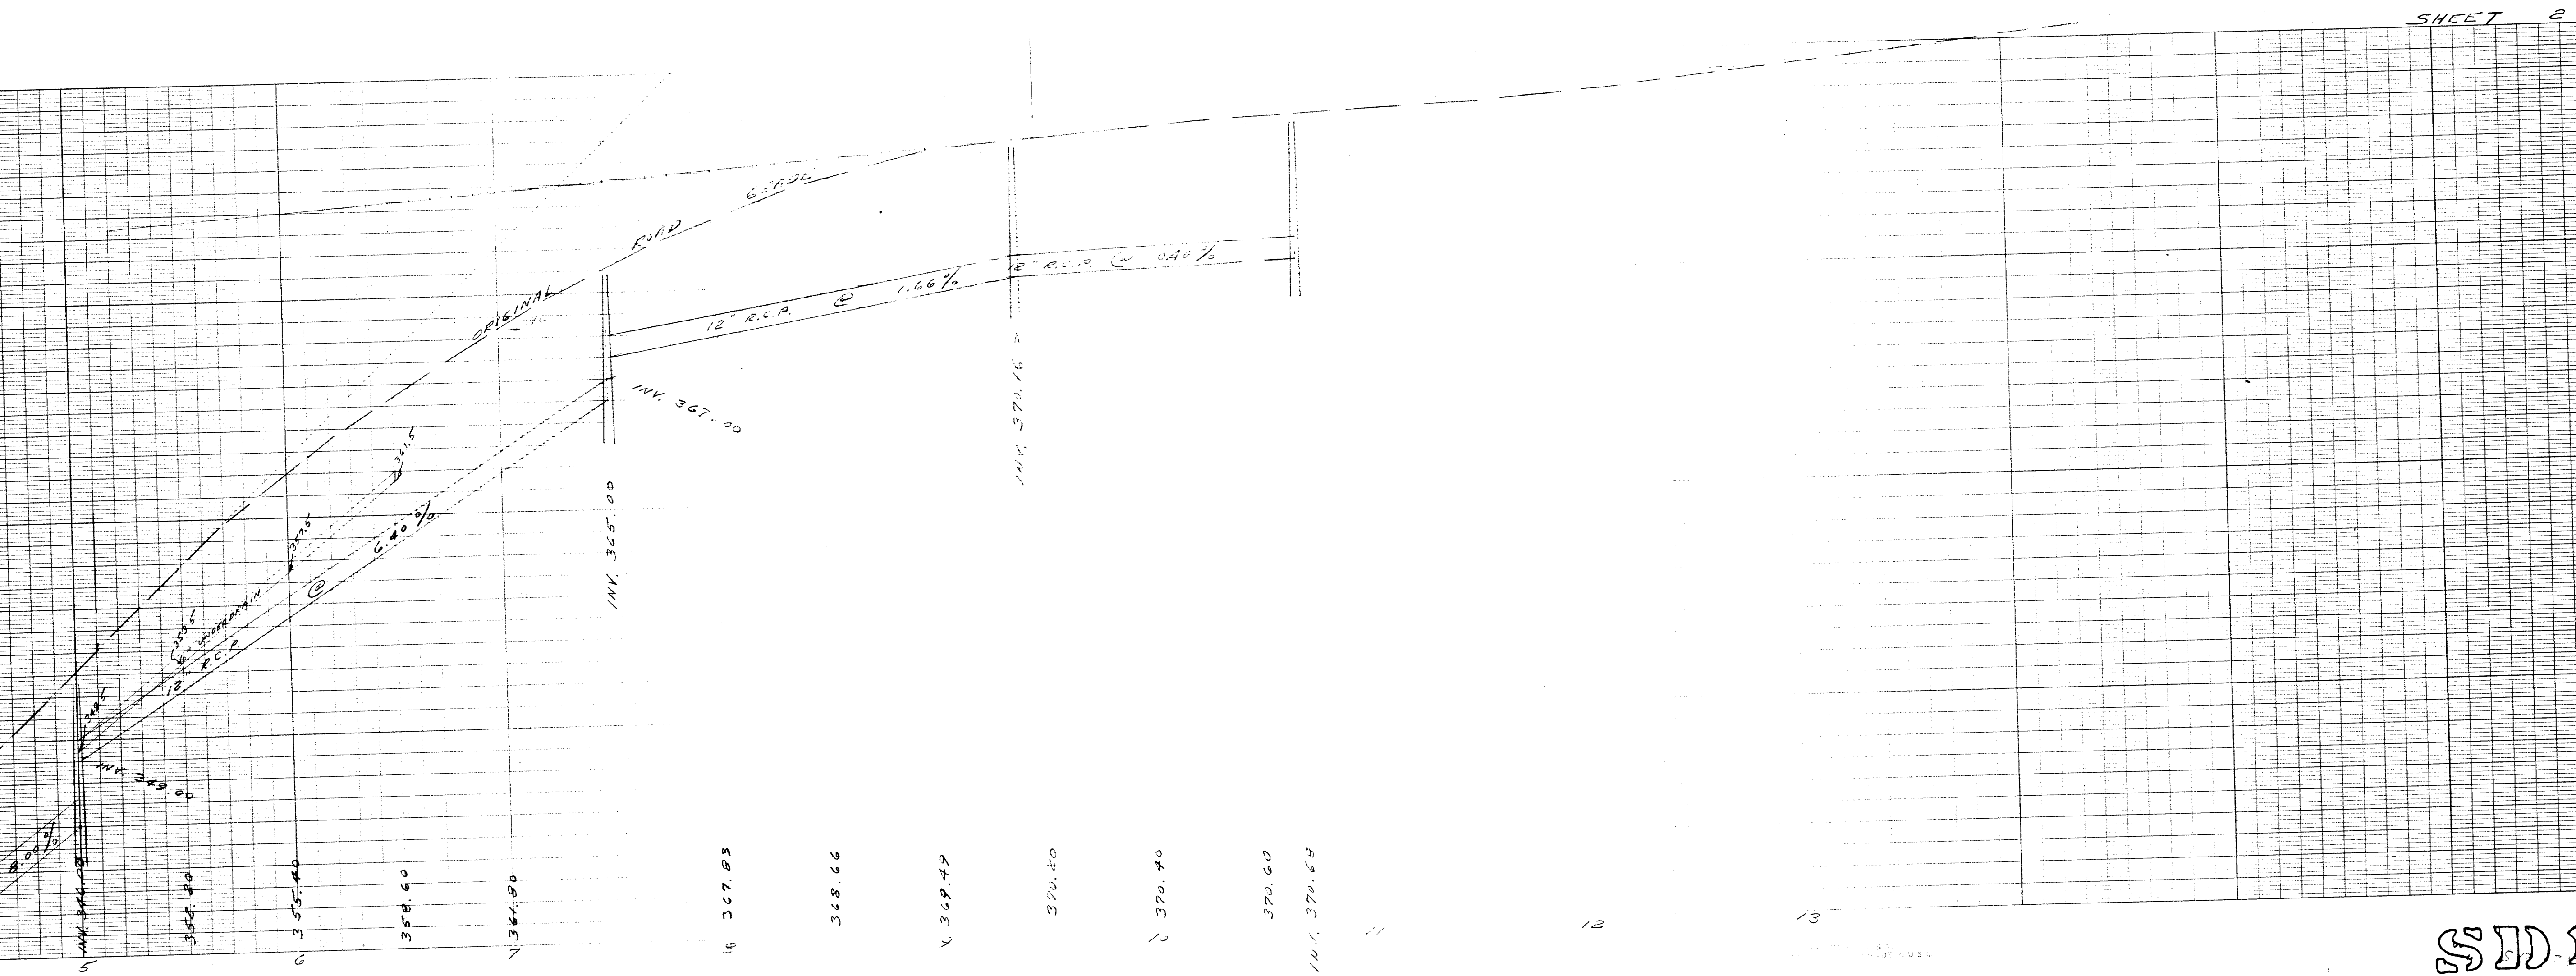

SHEET 2

SD