



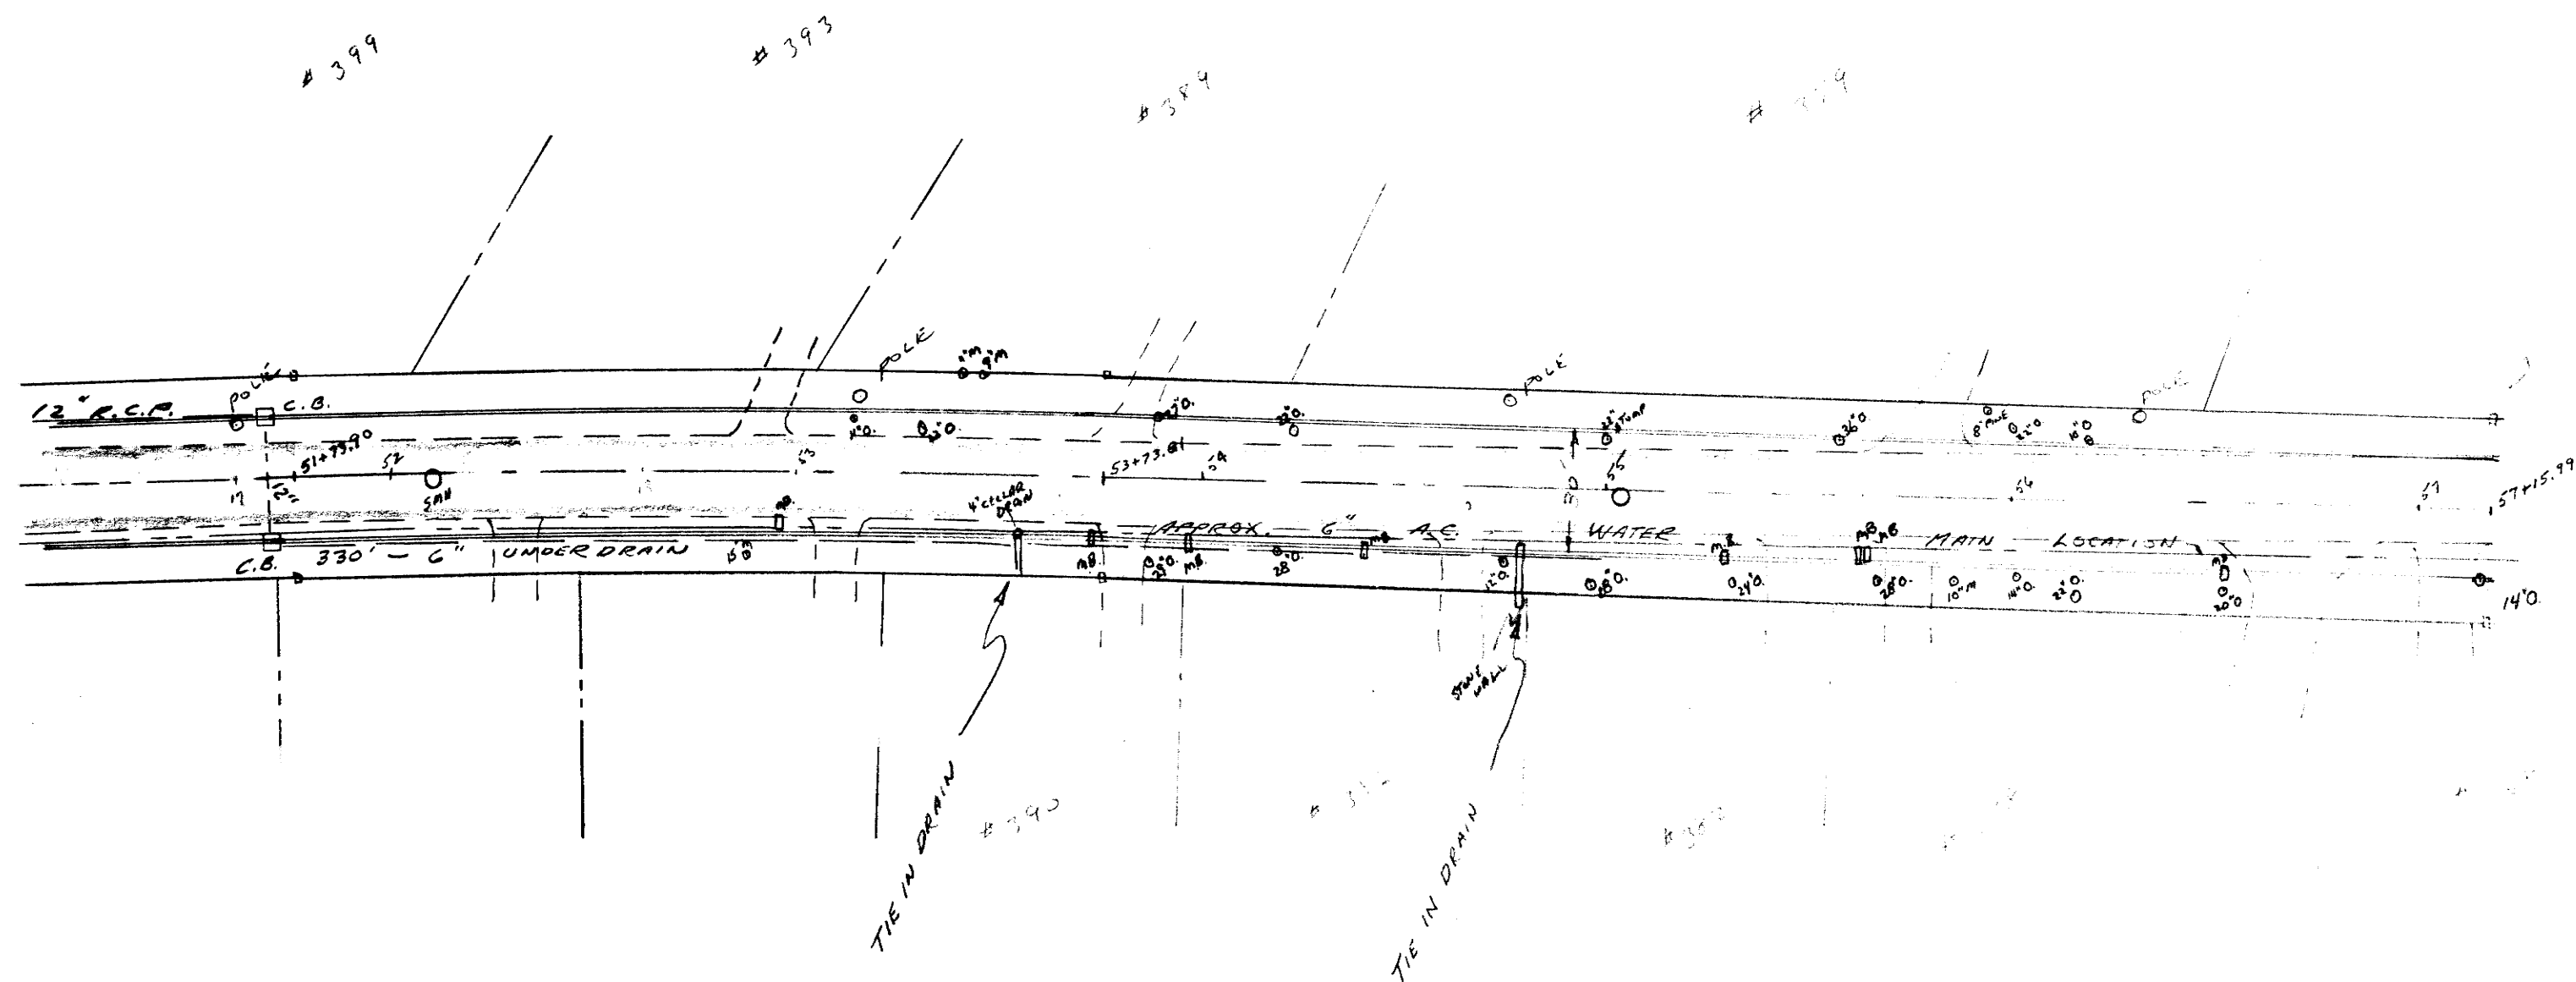

PLAN & PROFILE FOR STORM DRAIN
PARKER STREET
EAST LONGMEADOW MASS.
SCALE: 1" = 40' HORIZ. 1" = 4' VERT.
A. R. MELIEN TOWN ENGR. 1976

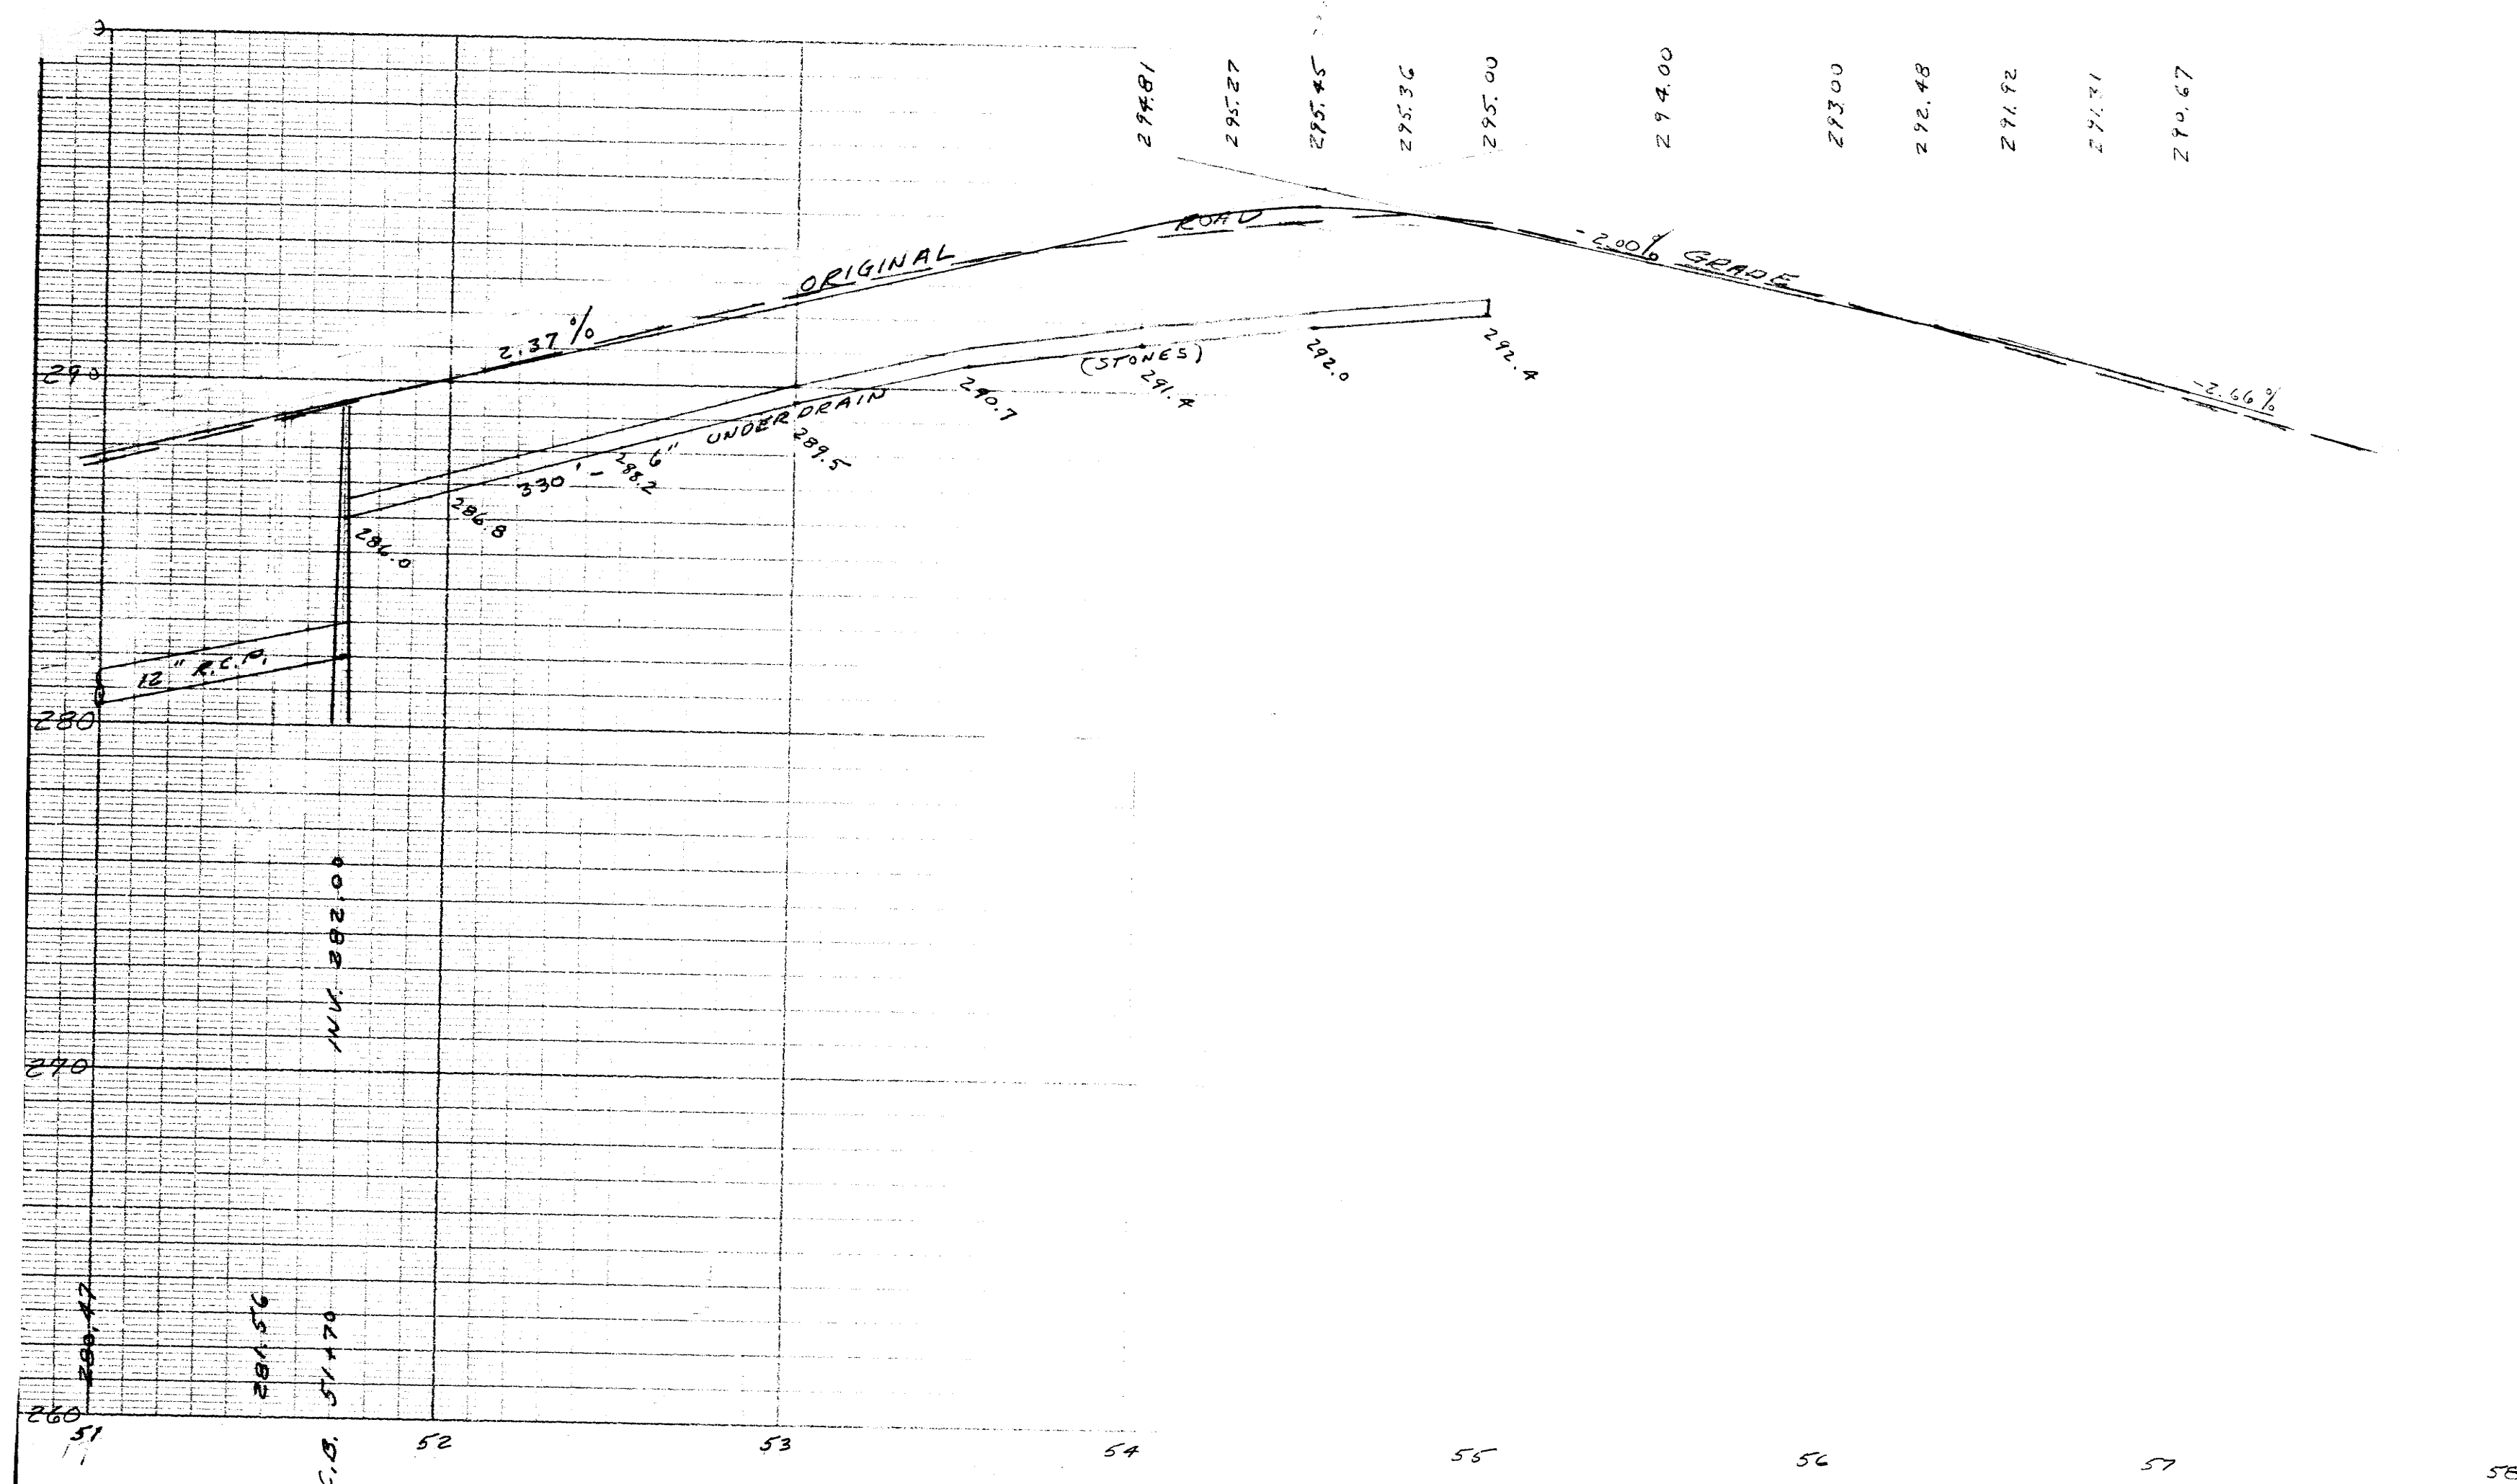

SHEET 6 OF 6

SD 187B