



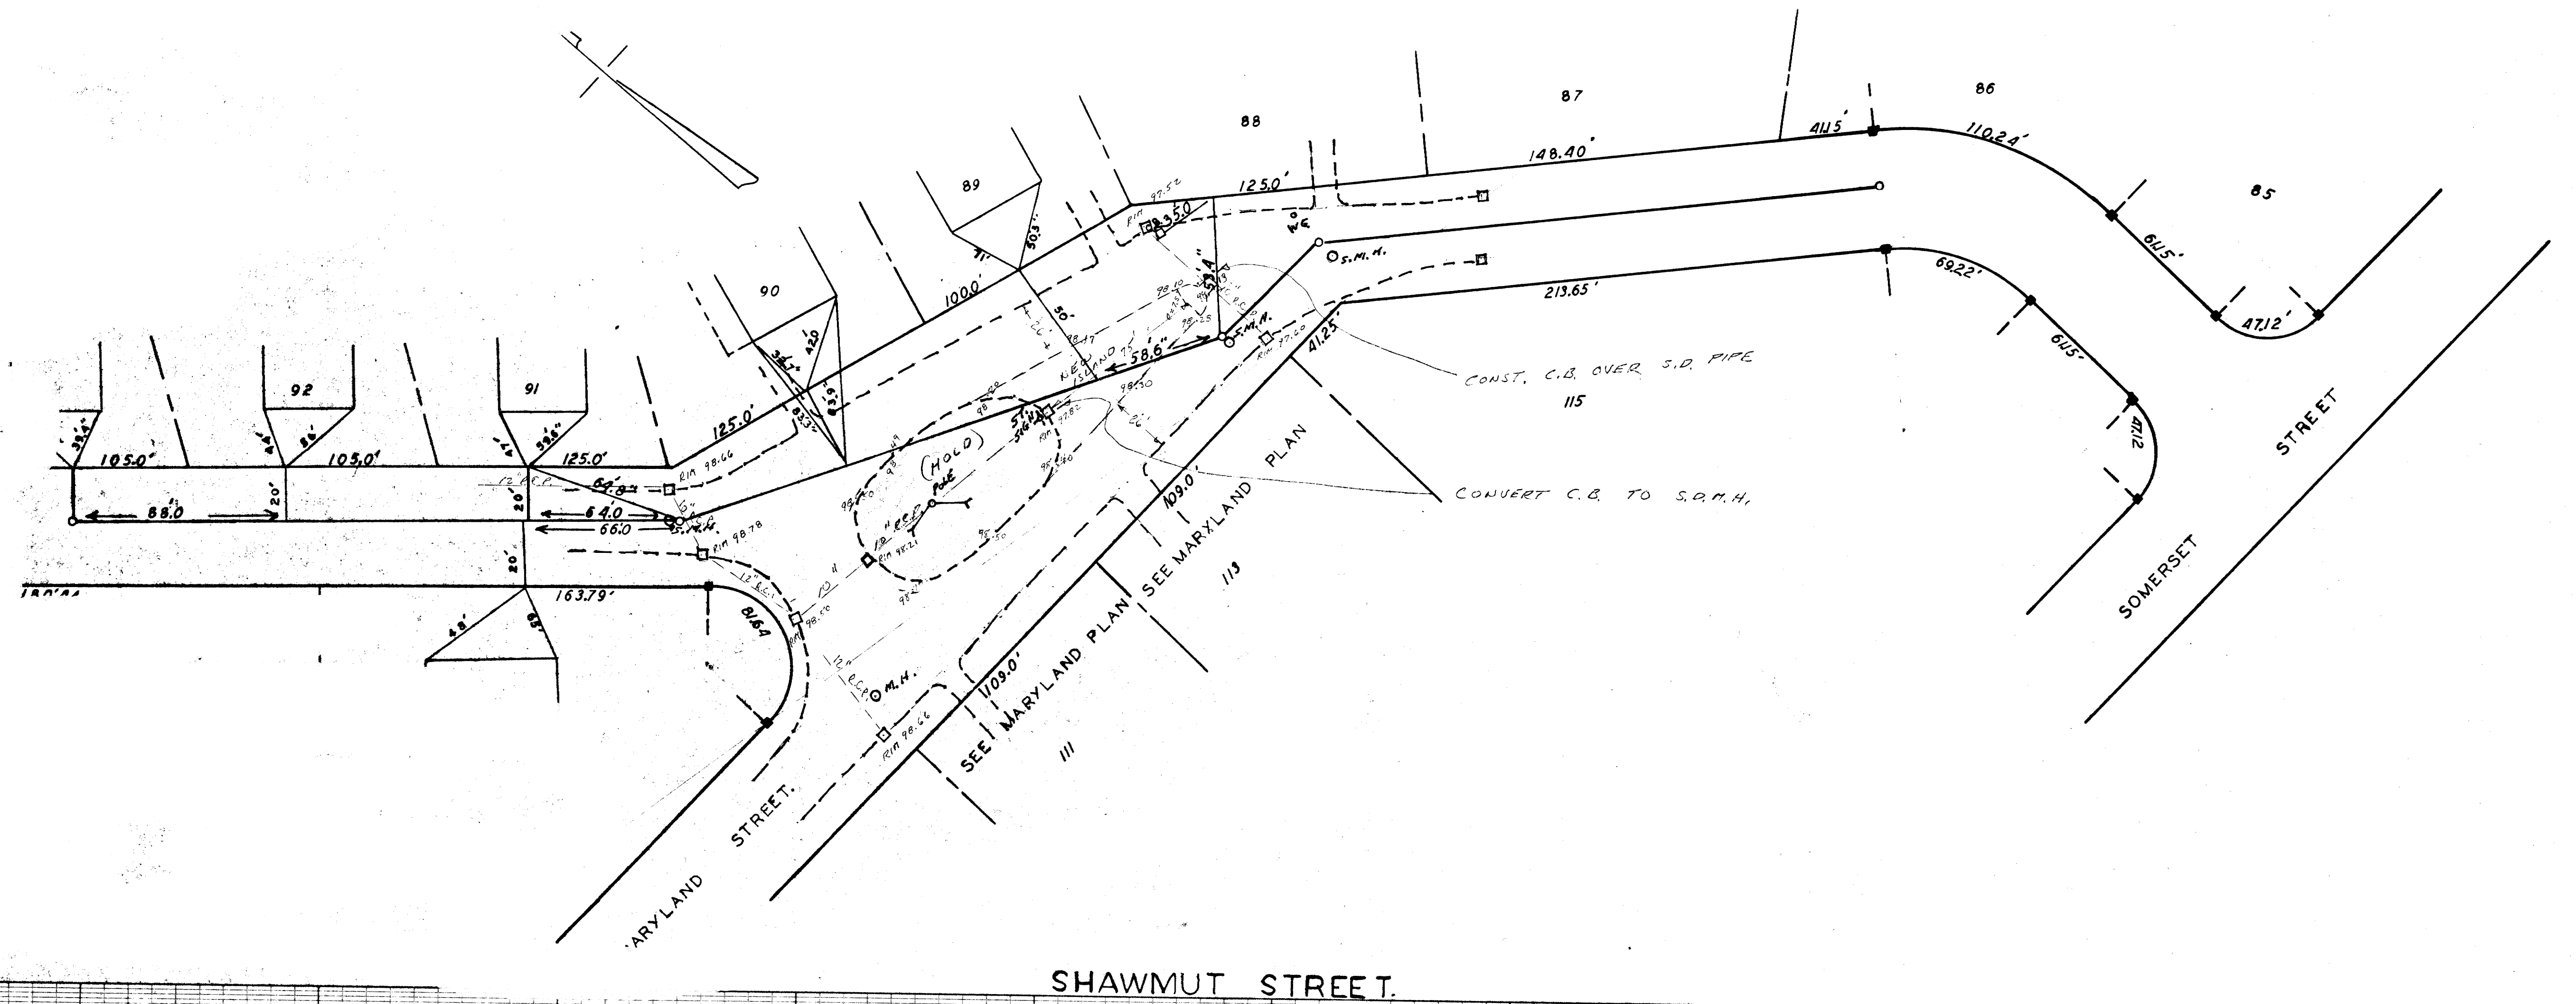

SHAWMUT STREET.

NOTE: HOUSES AND TIES TO CONNECTIONS
ARE NOT TO SCALE ONLY TIES TO M.H.
ARE TO SCALE.

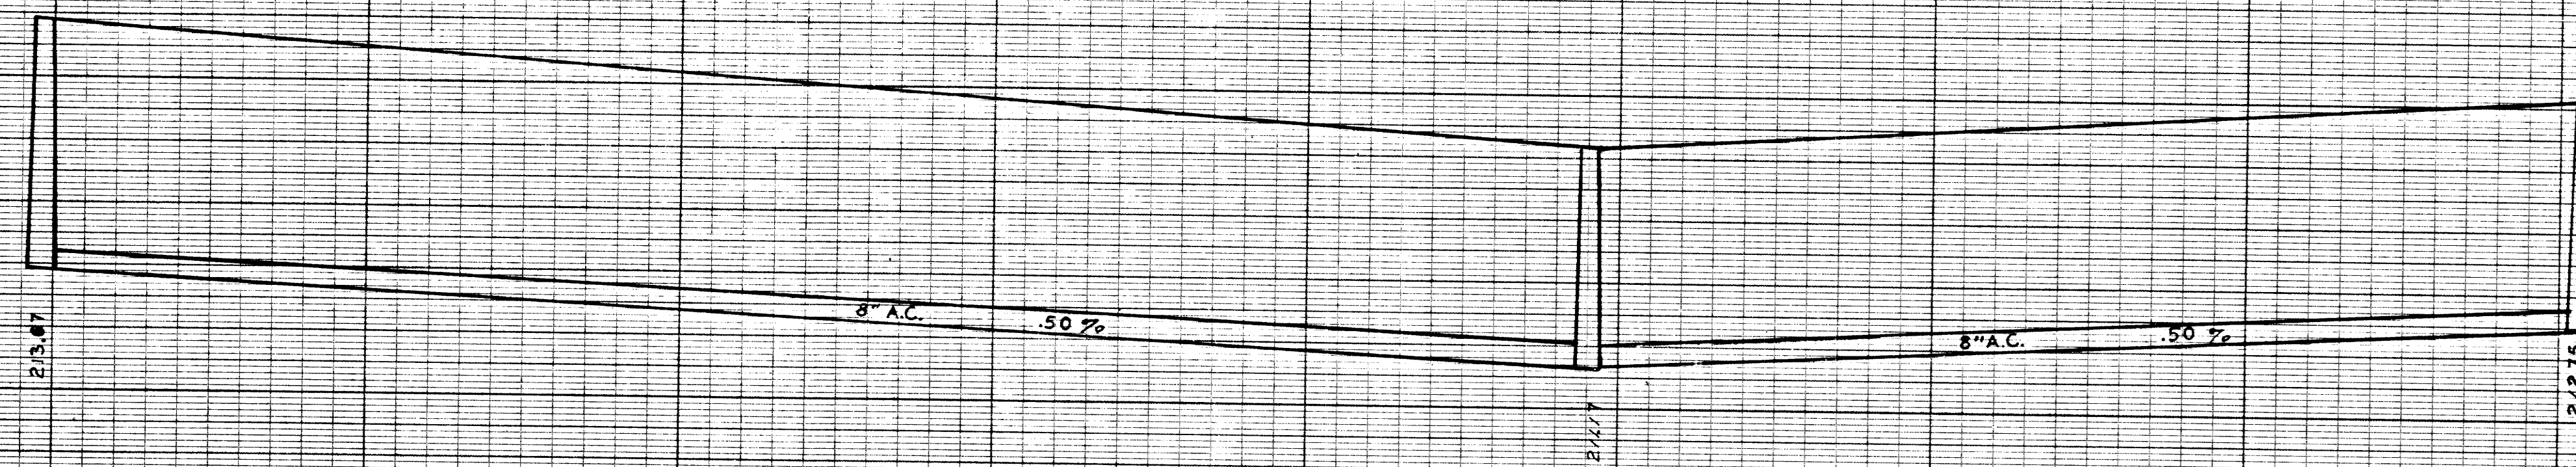

PLAN AND PROFILE
OF
SAN SEWER AND HOUSE CONNECTION
OF
SHAWMUT STREET
DEPT OF PUBLIC WORKS
TOWN OF EAST LONGMEADOW
SCALE 1"=40' HORIZ
1"=4' VERT A.A. MELIEN ENG.