



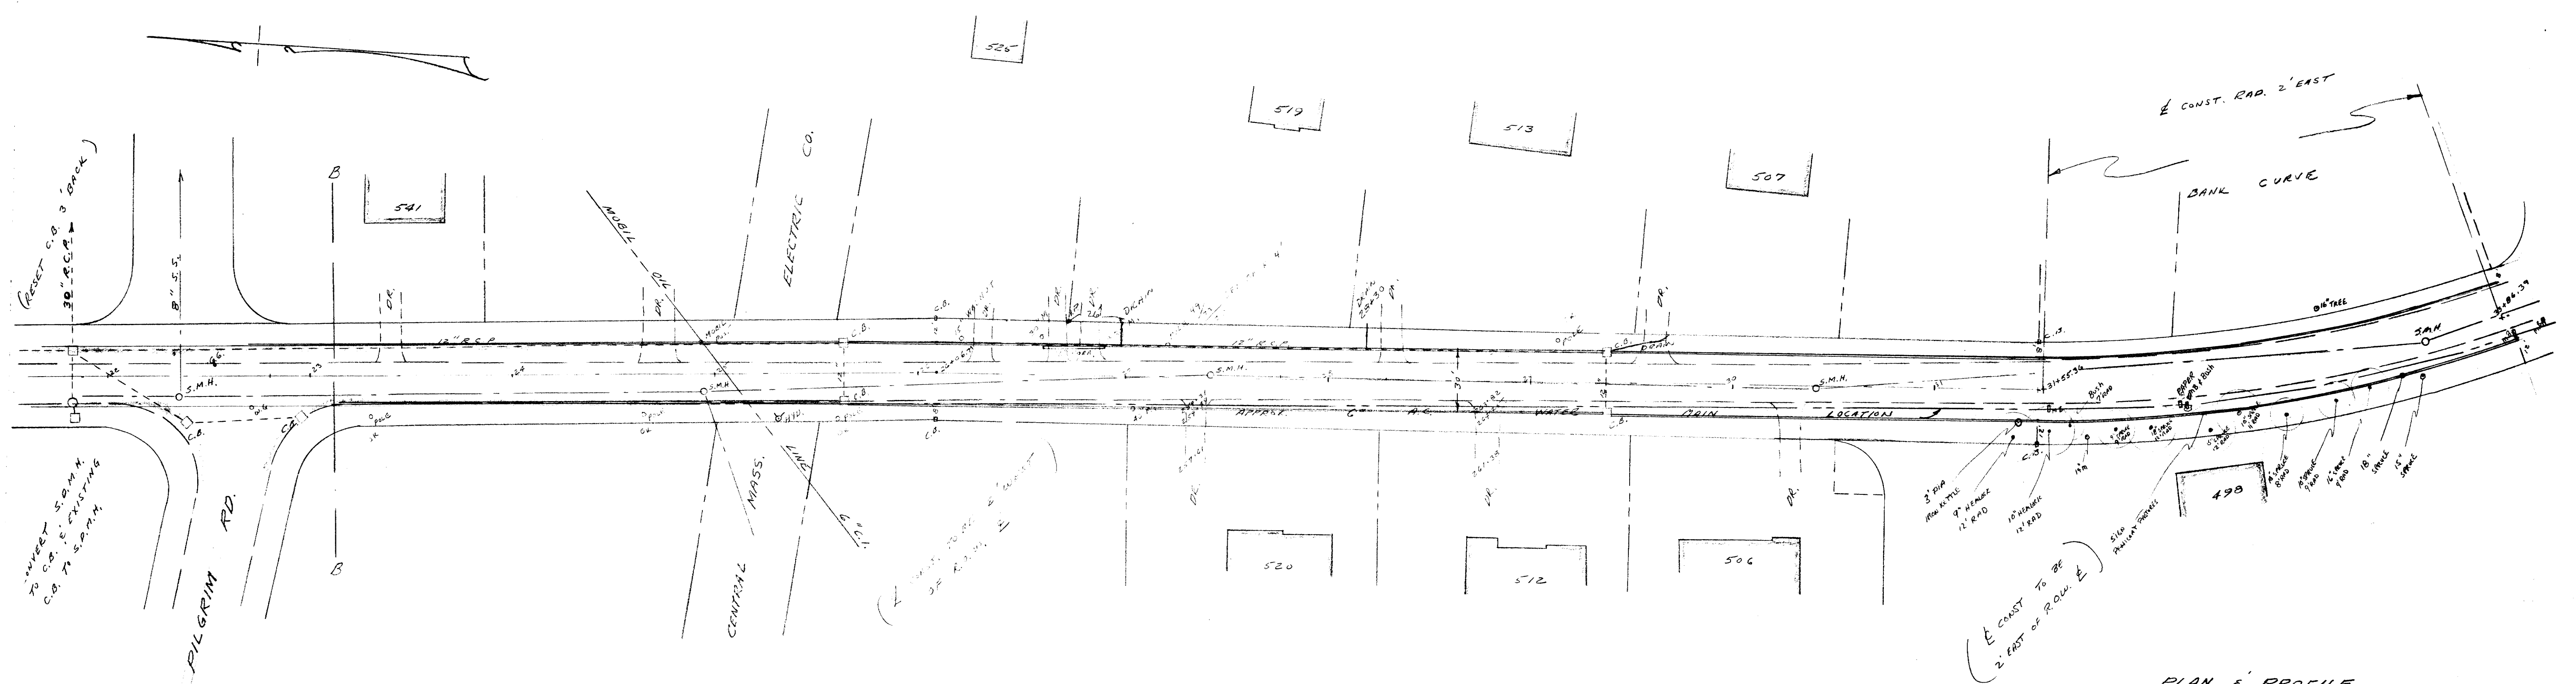

PLAN & PROFILE
 PARKER STREET
 EAST LONGMEADOW MASS.
 SCALE: 1" = 40' HOR. 1" = 4' VERT.
 NOV. 1975
 A.A. MELIEN TOWN ENG'R.

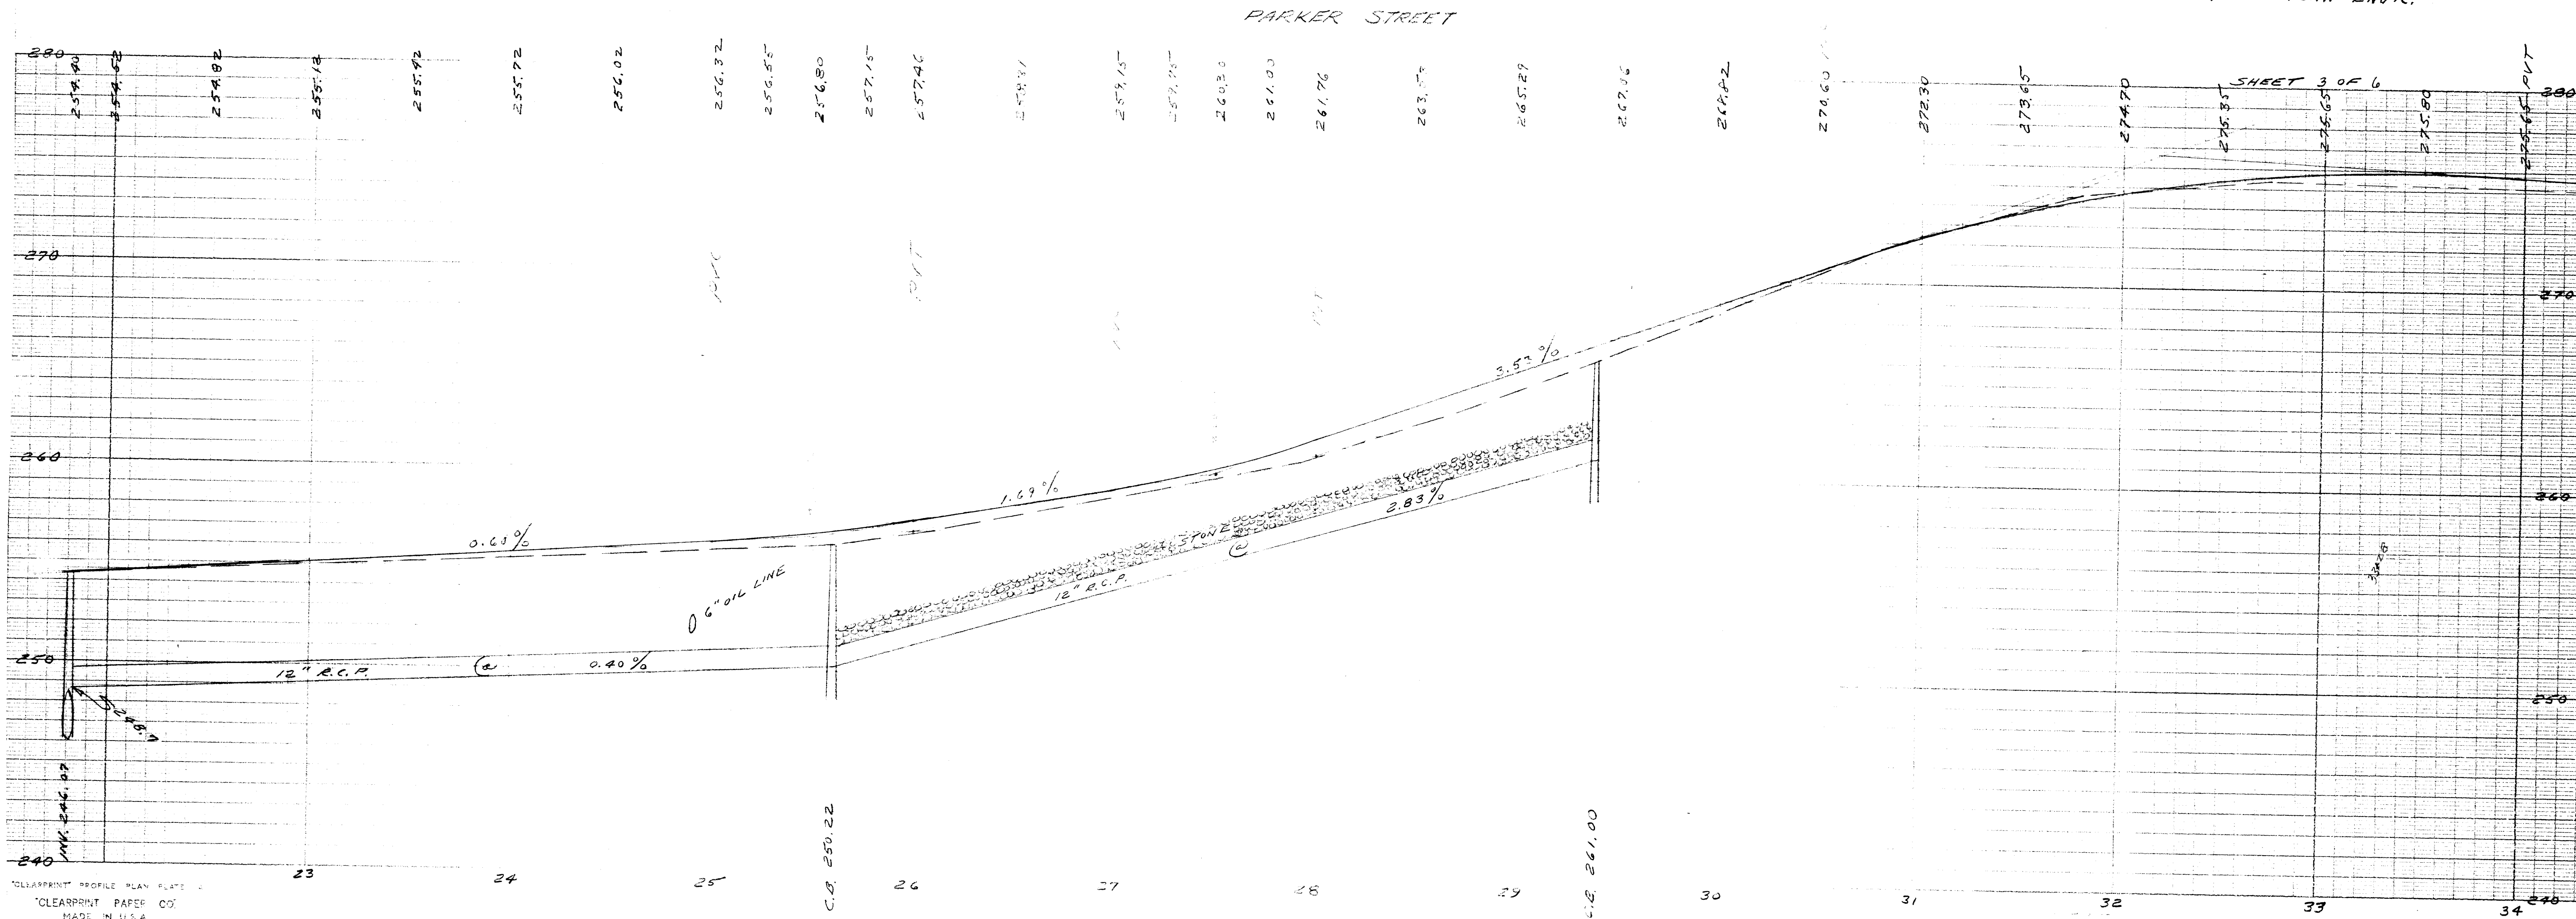

SD 1887