


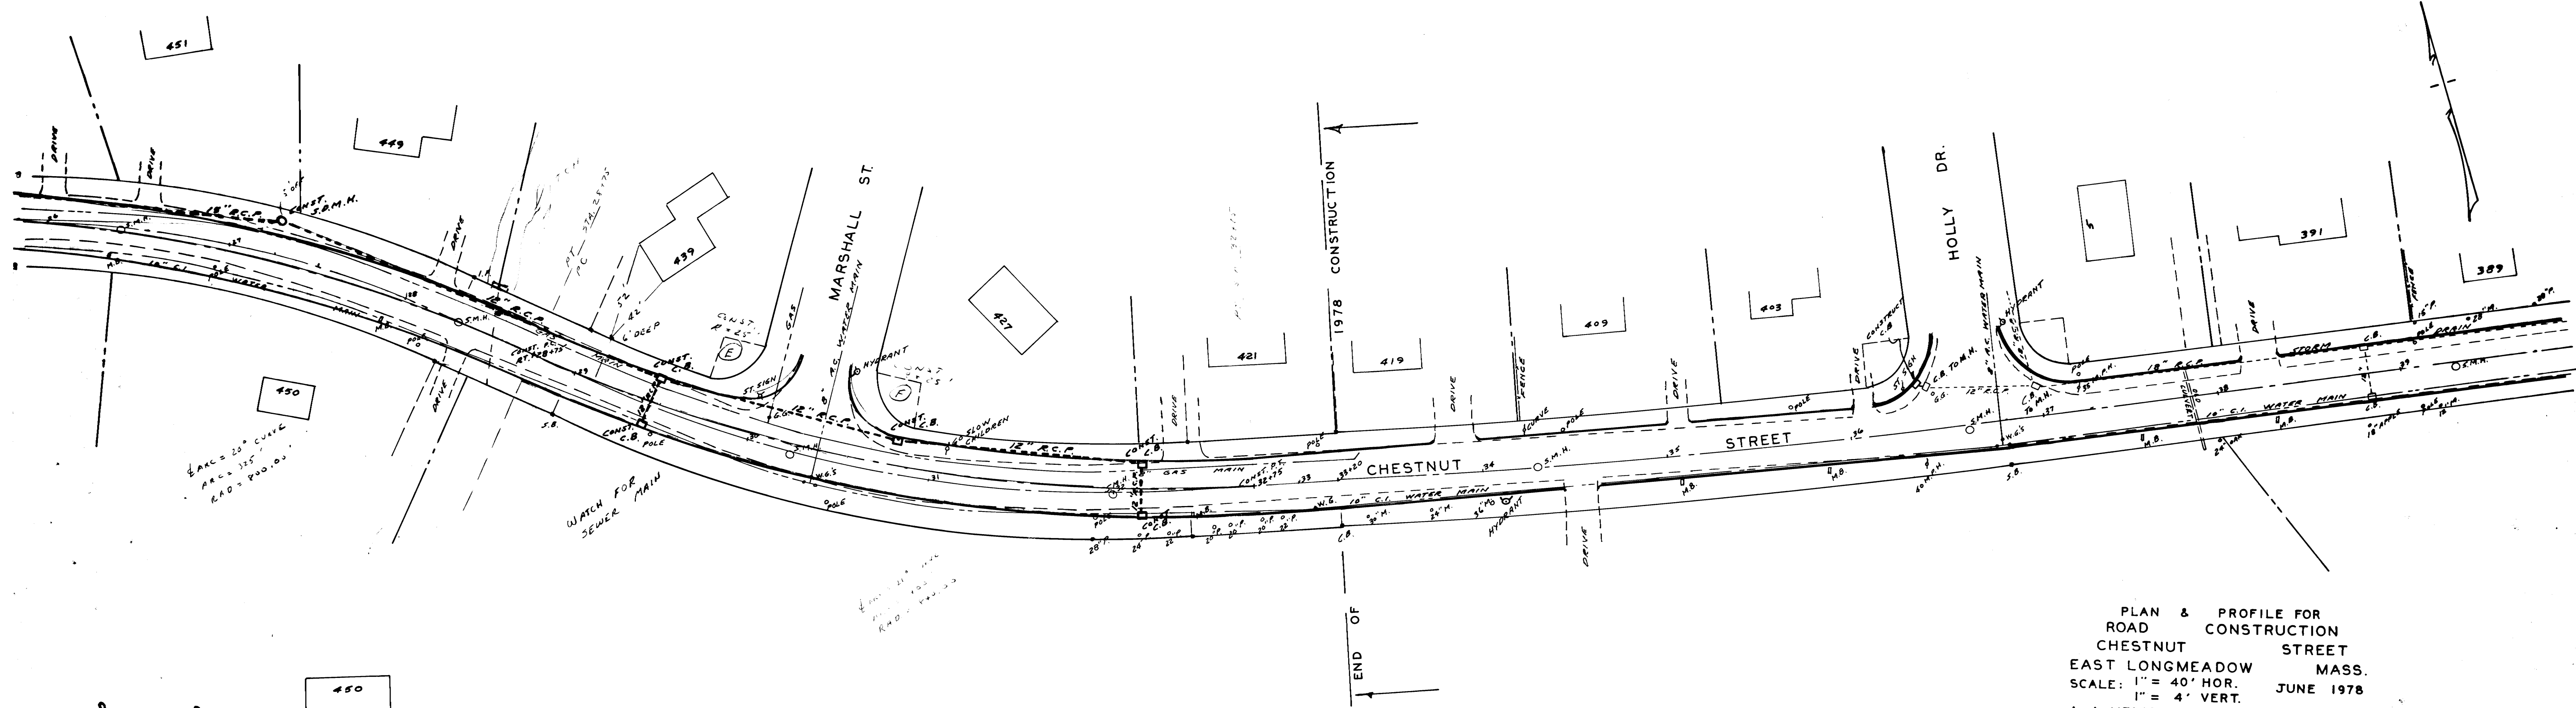

PLAN & PROFILE FOR
ROAD CONSTRUCTION
CHESTNUT STREET
EAST LONGMEADOW MASS.
SCALE: 1" = 40' HOR. JUNE 1978
1" = 4' VERT.
A. A. MELIEN TOWN ENGR.

SHEET 2 OF 3



51193