


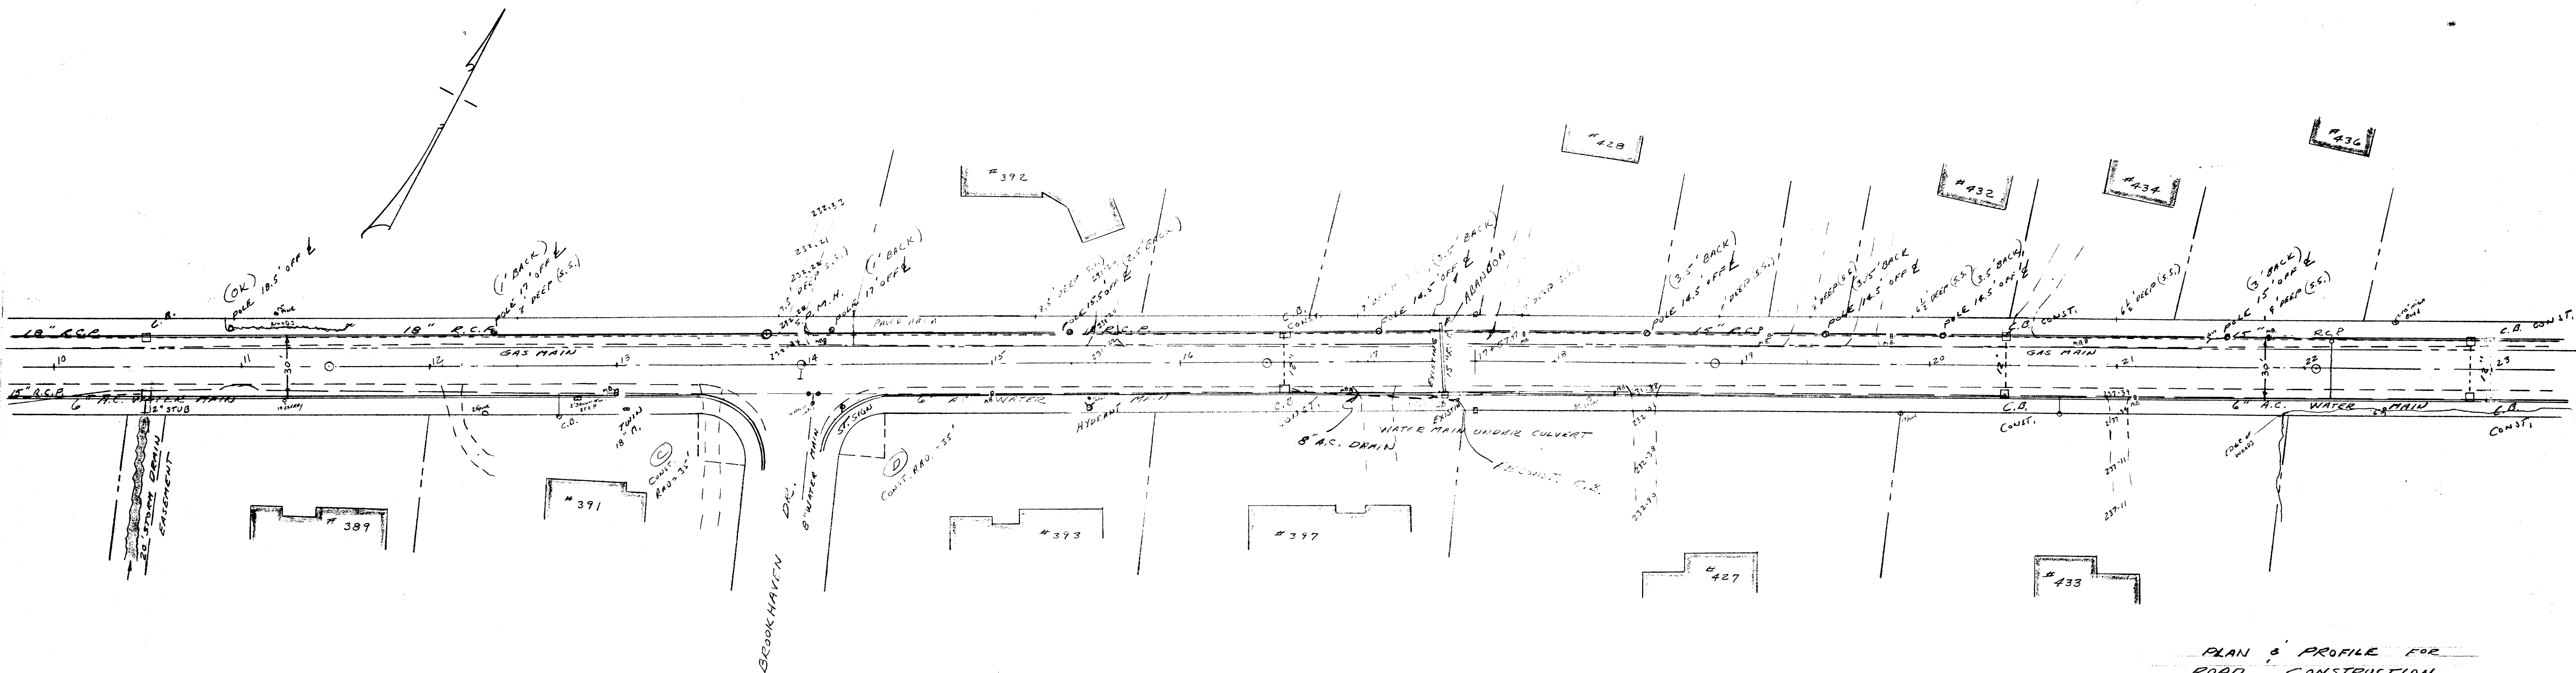

PLAN & PROFILE FOR
 ROAD CONSTRUCTION
 PORTER ROAD
 EAST LONGMEADOW MA.
 SCALE: 1" = 40' HORIZ.
 1" = 4' VERT.
 A.A. MELIEN TOWN ENGR.

