
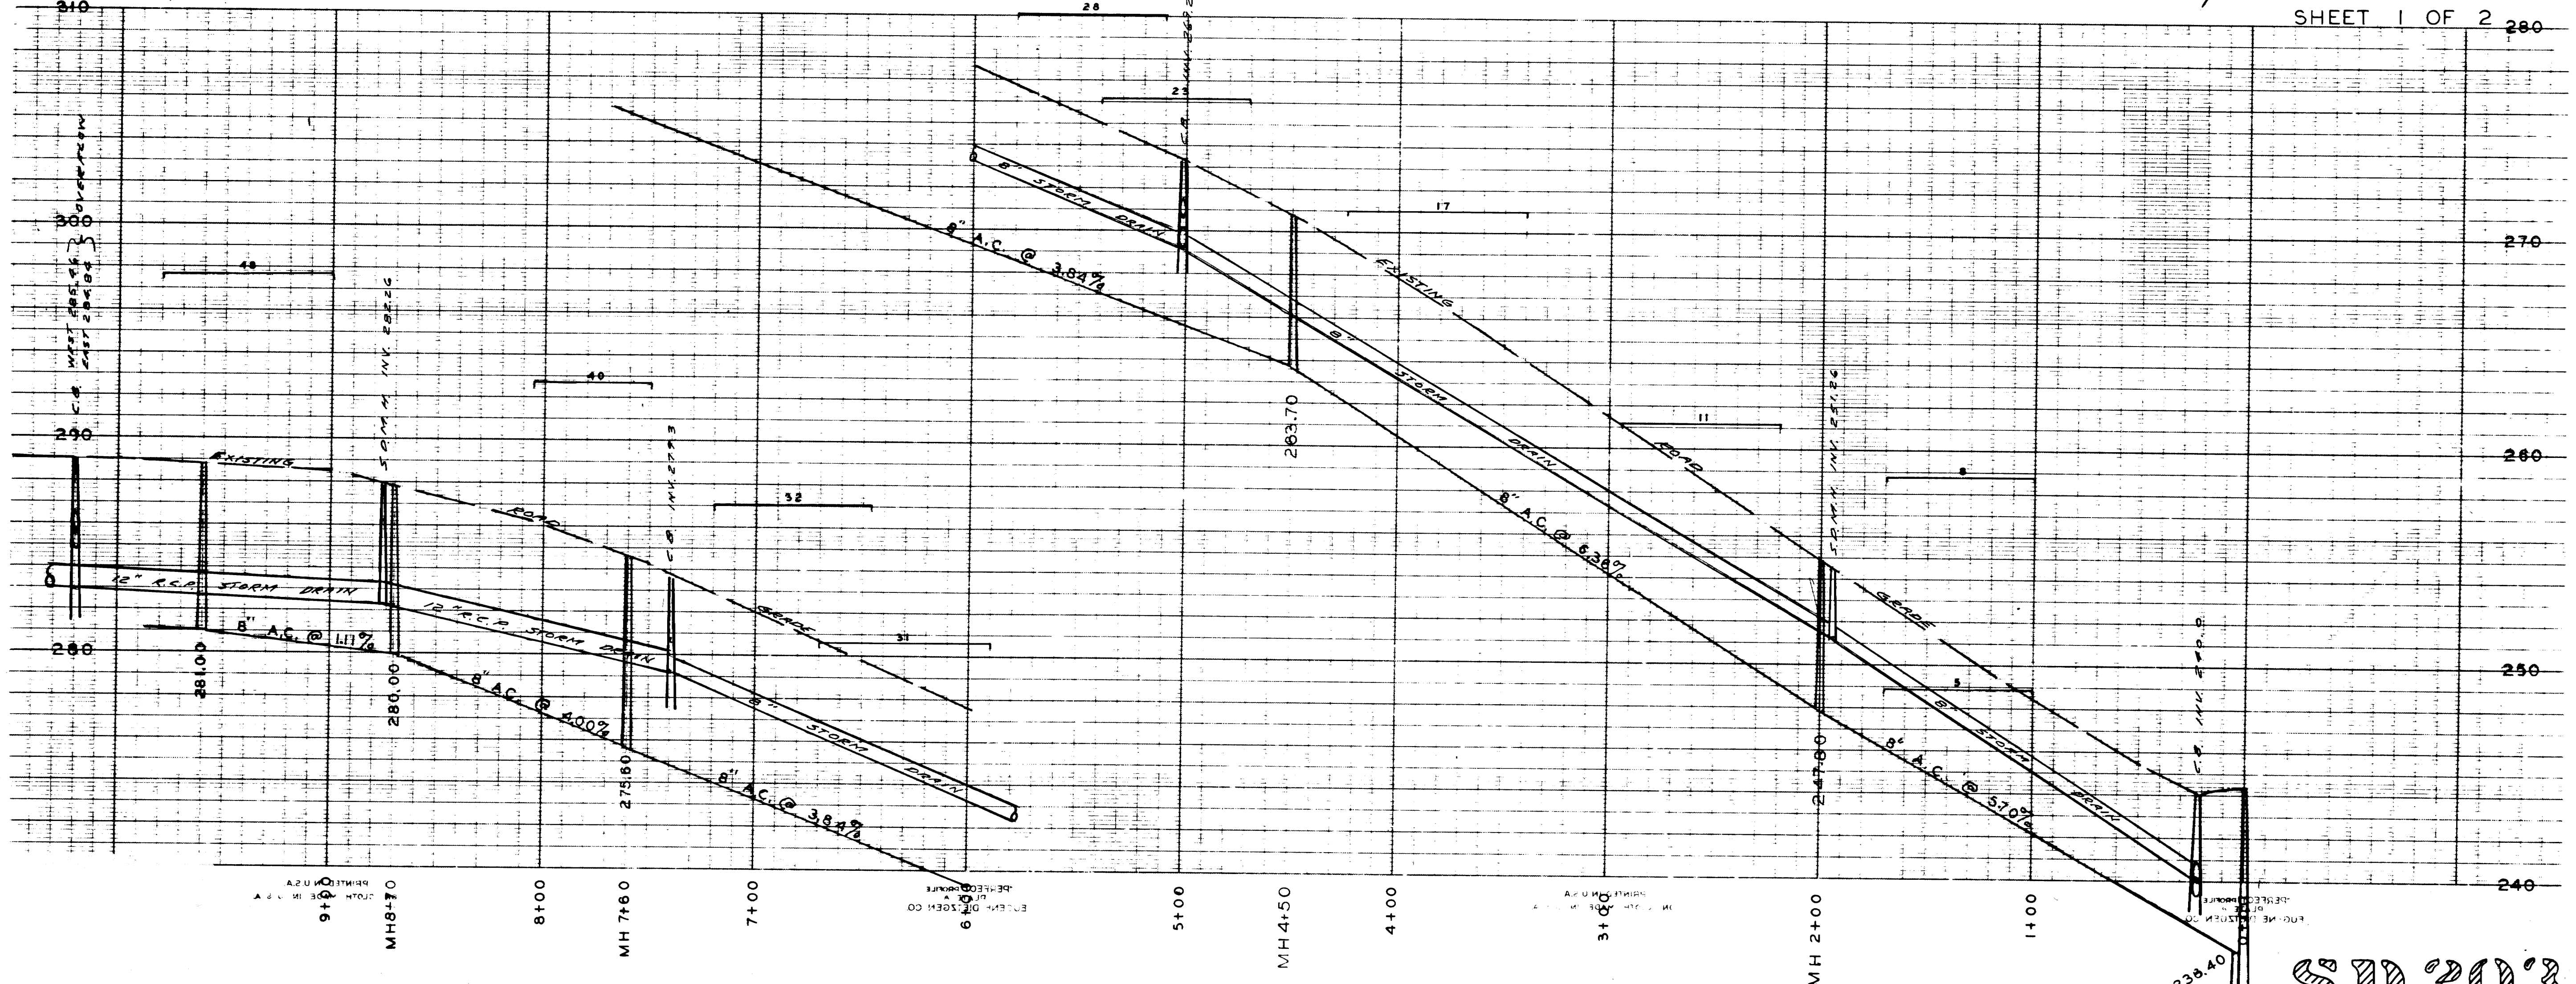


DESIGNED BY C.E. ANDERSON ASSOC.
SEE W 125 & W 229

PLAN & PROFILE
OF
STORM DRAIN
GREENWICH ROAD
EAST LONGMEADOW MASS.
SCALE: 1" = 40' HOR.
1" = 4' VERT.
A. A. MELIEN ENGR.

LEGEND
STORM DRAIN
WATER
EDGE PAVEMENT

Const. 28' - 26' final

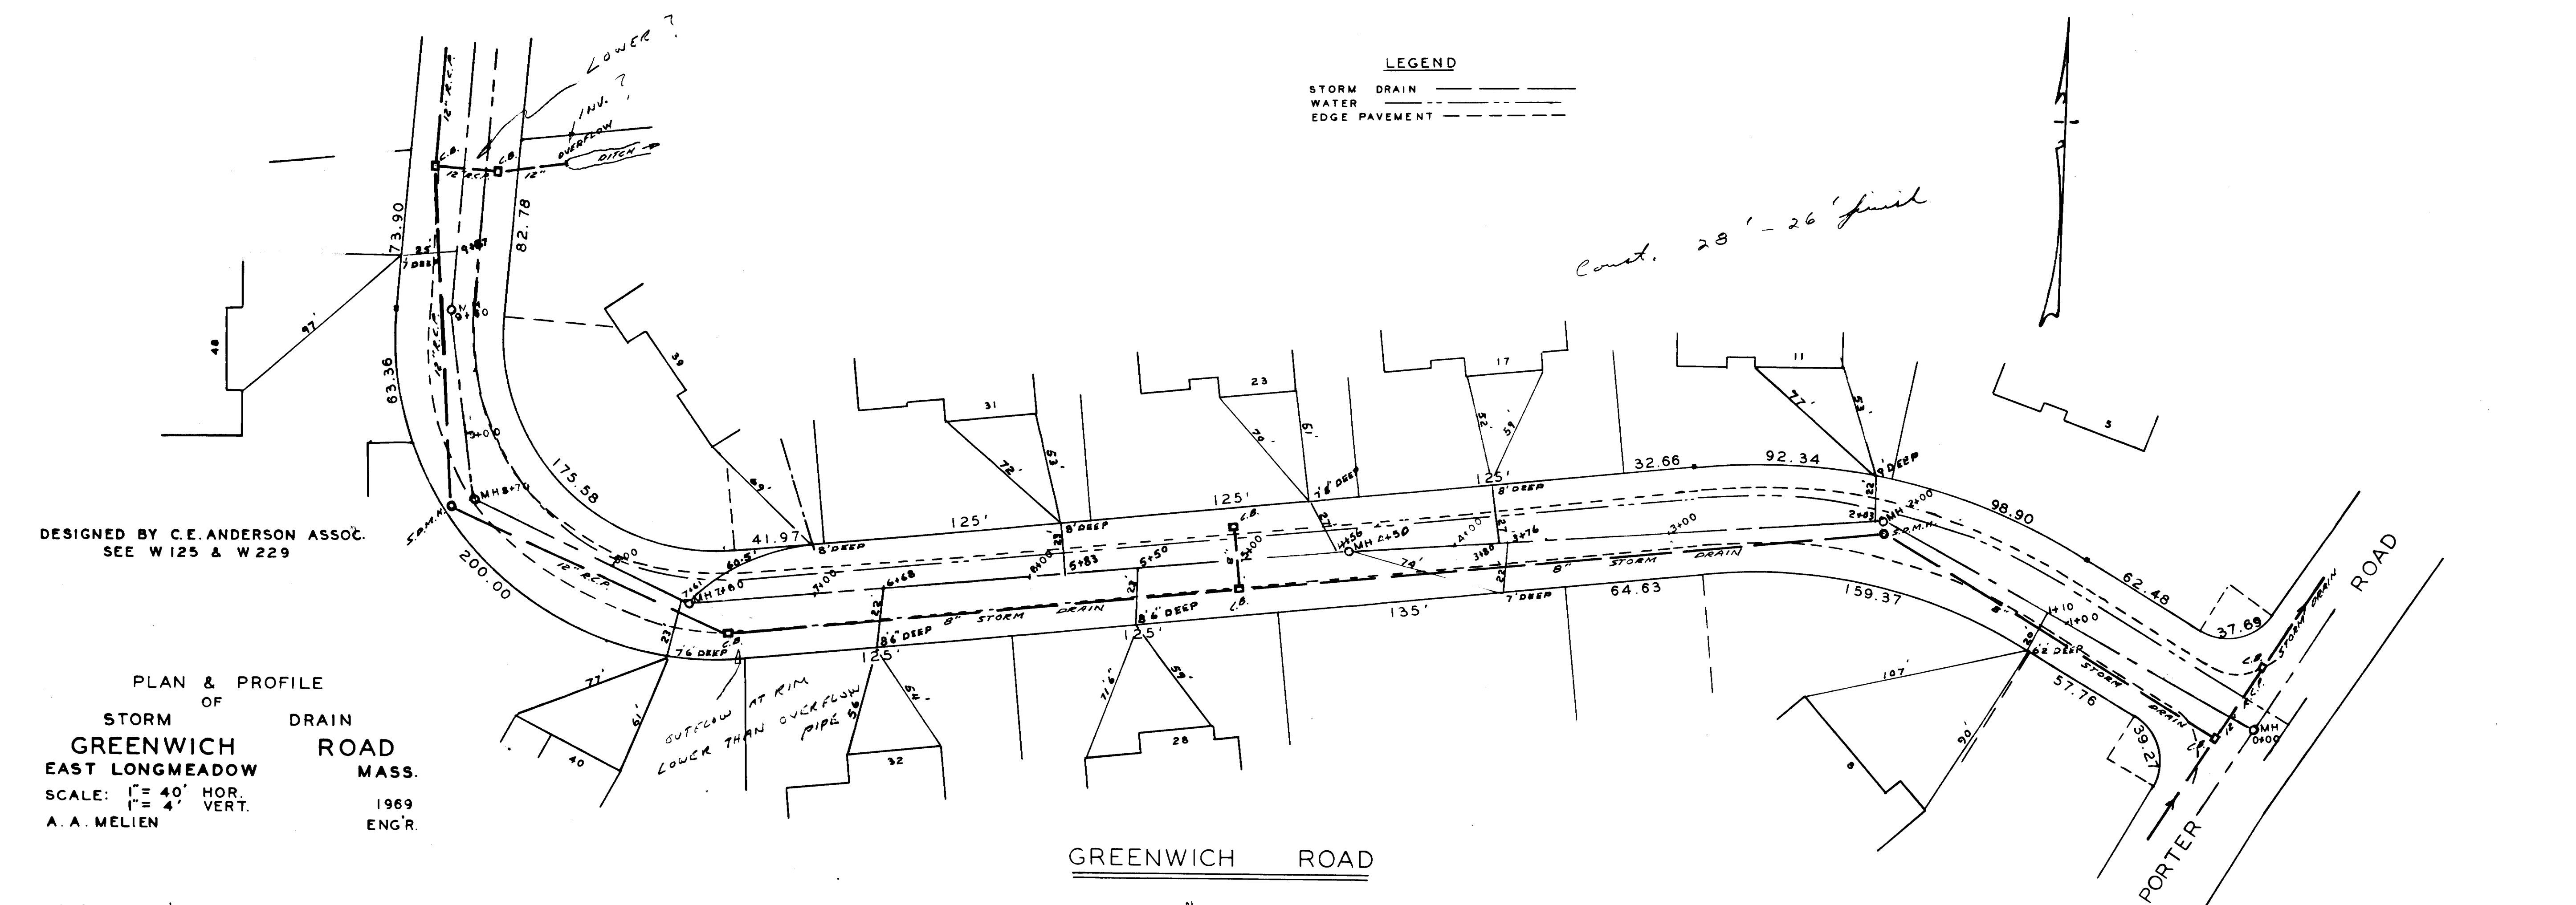

SD 2013