



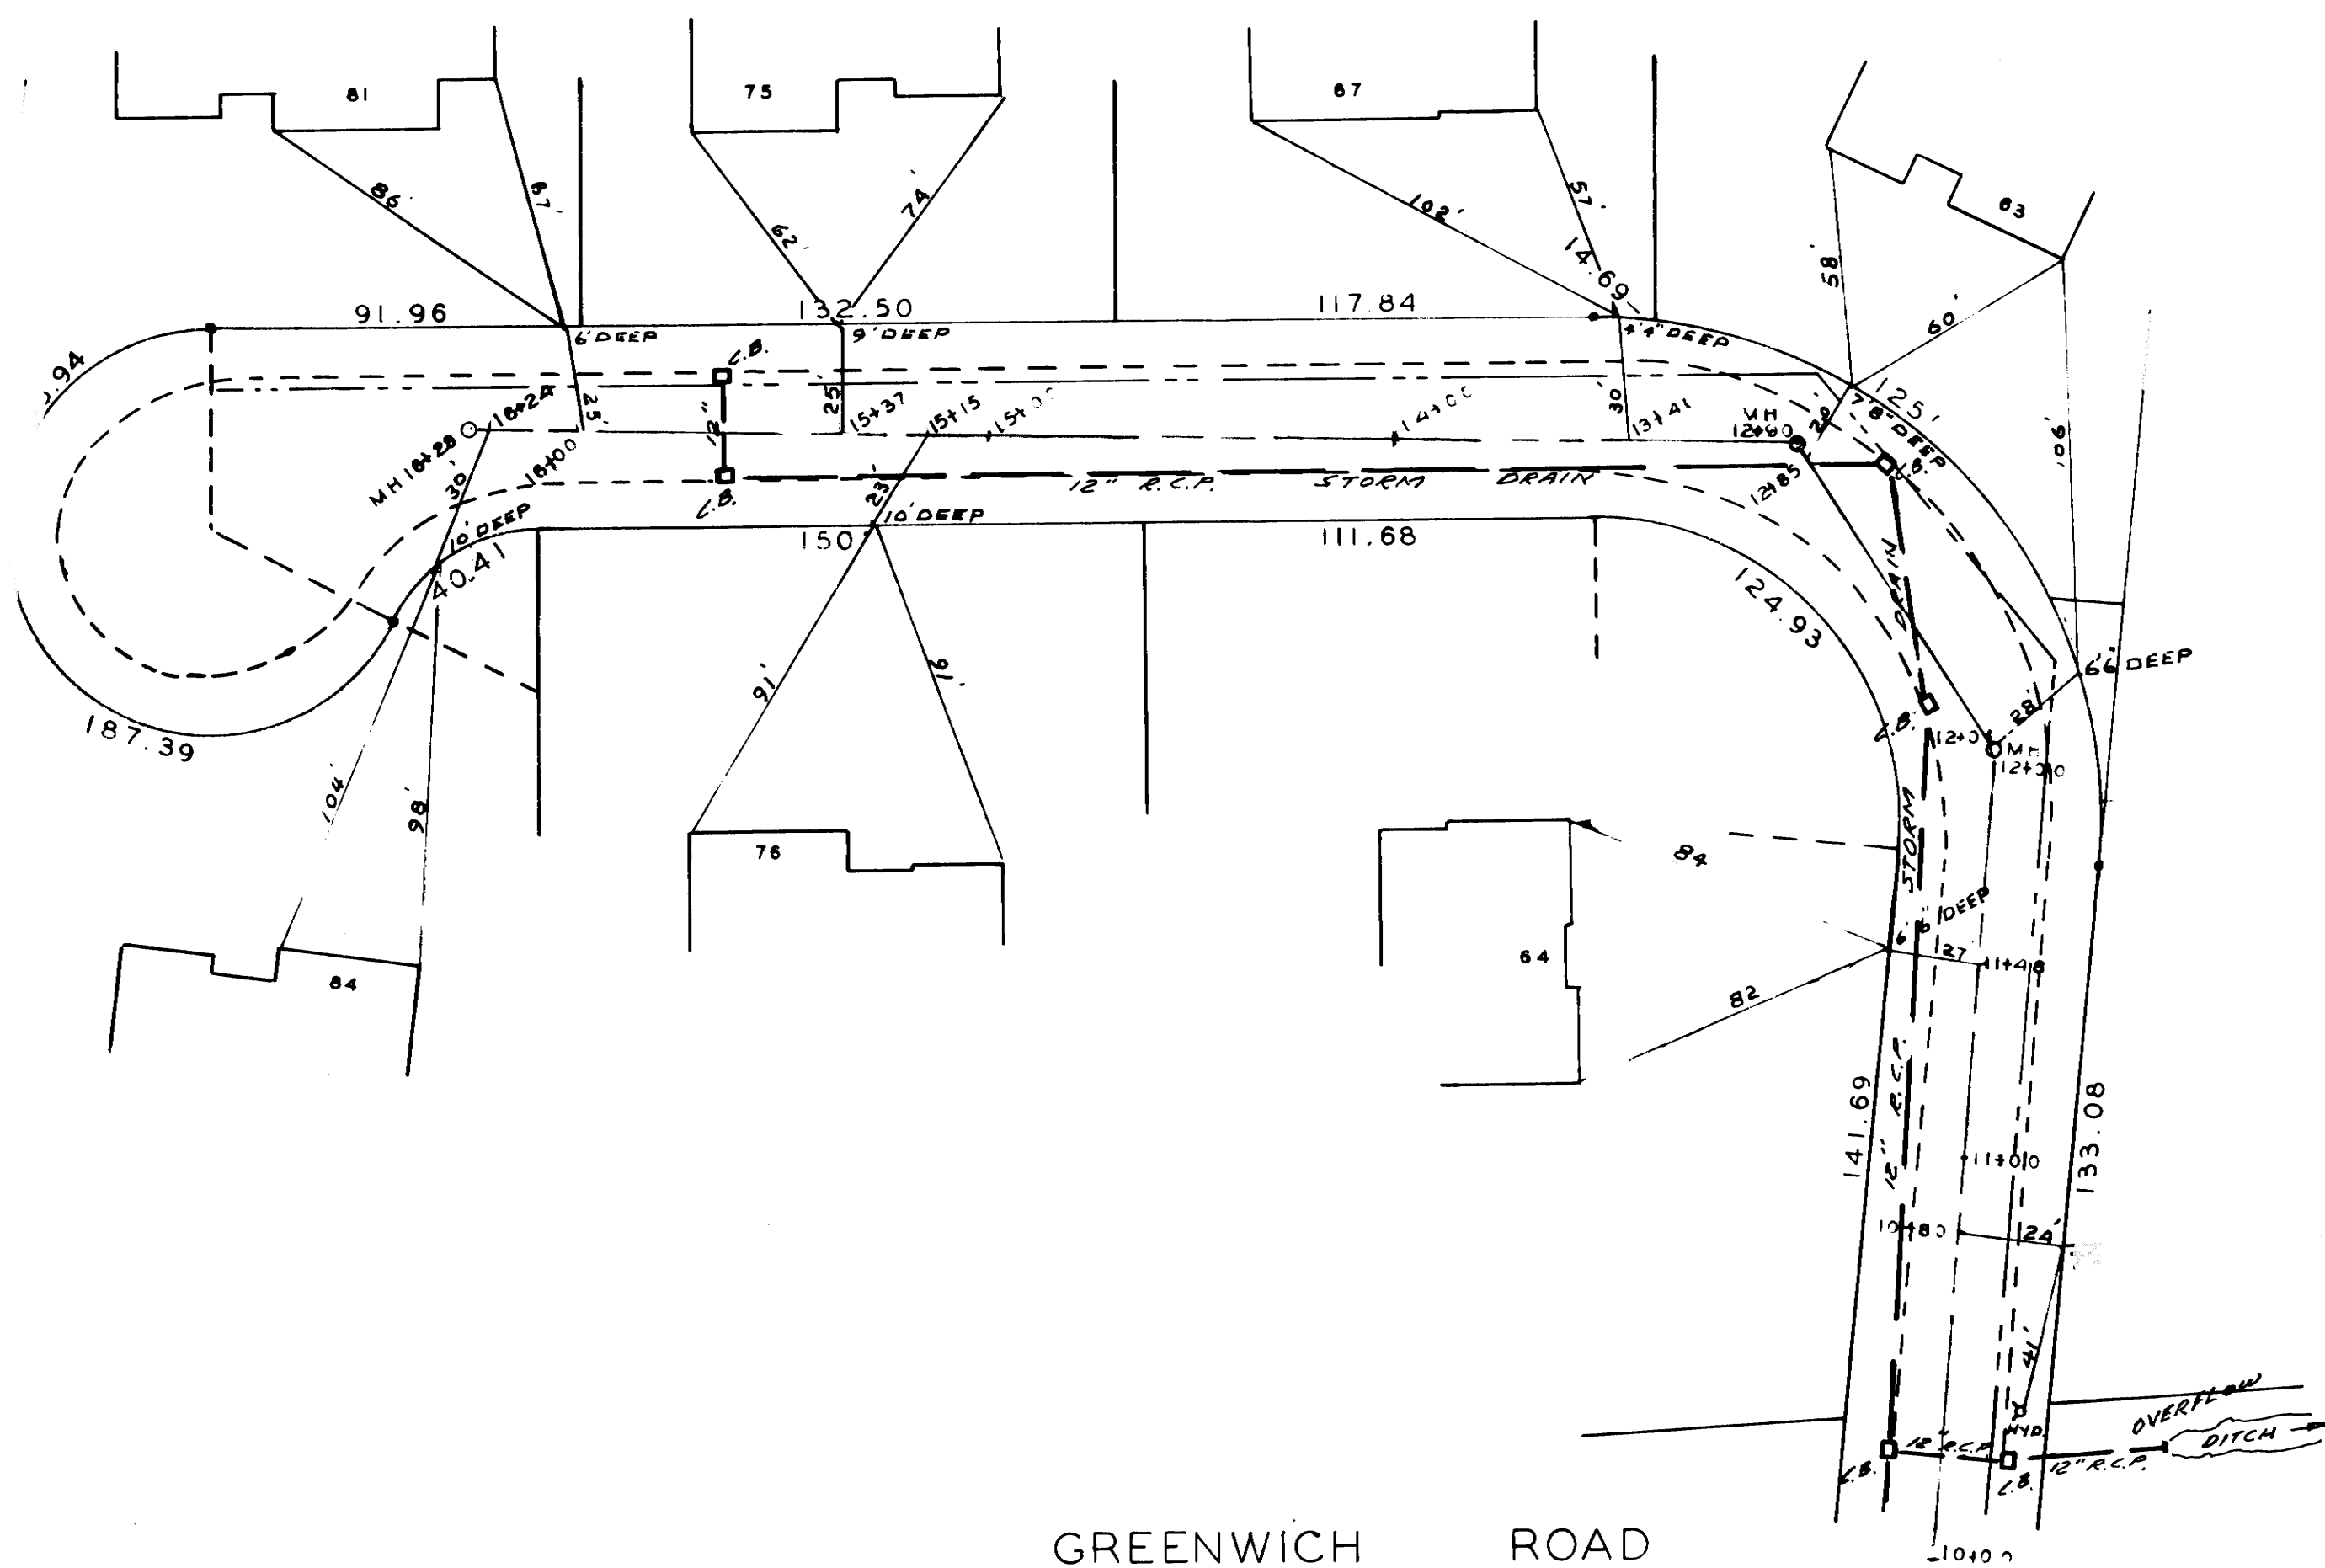

GREENWICH ROAD

SHEET 2 OF 2 320

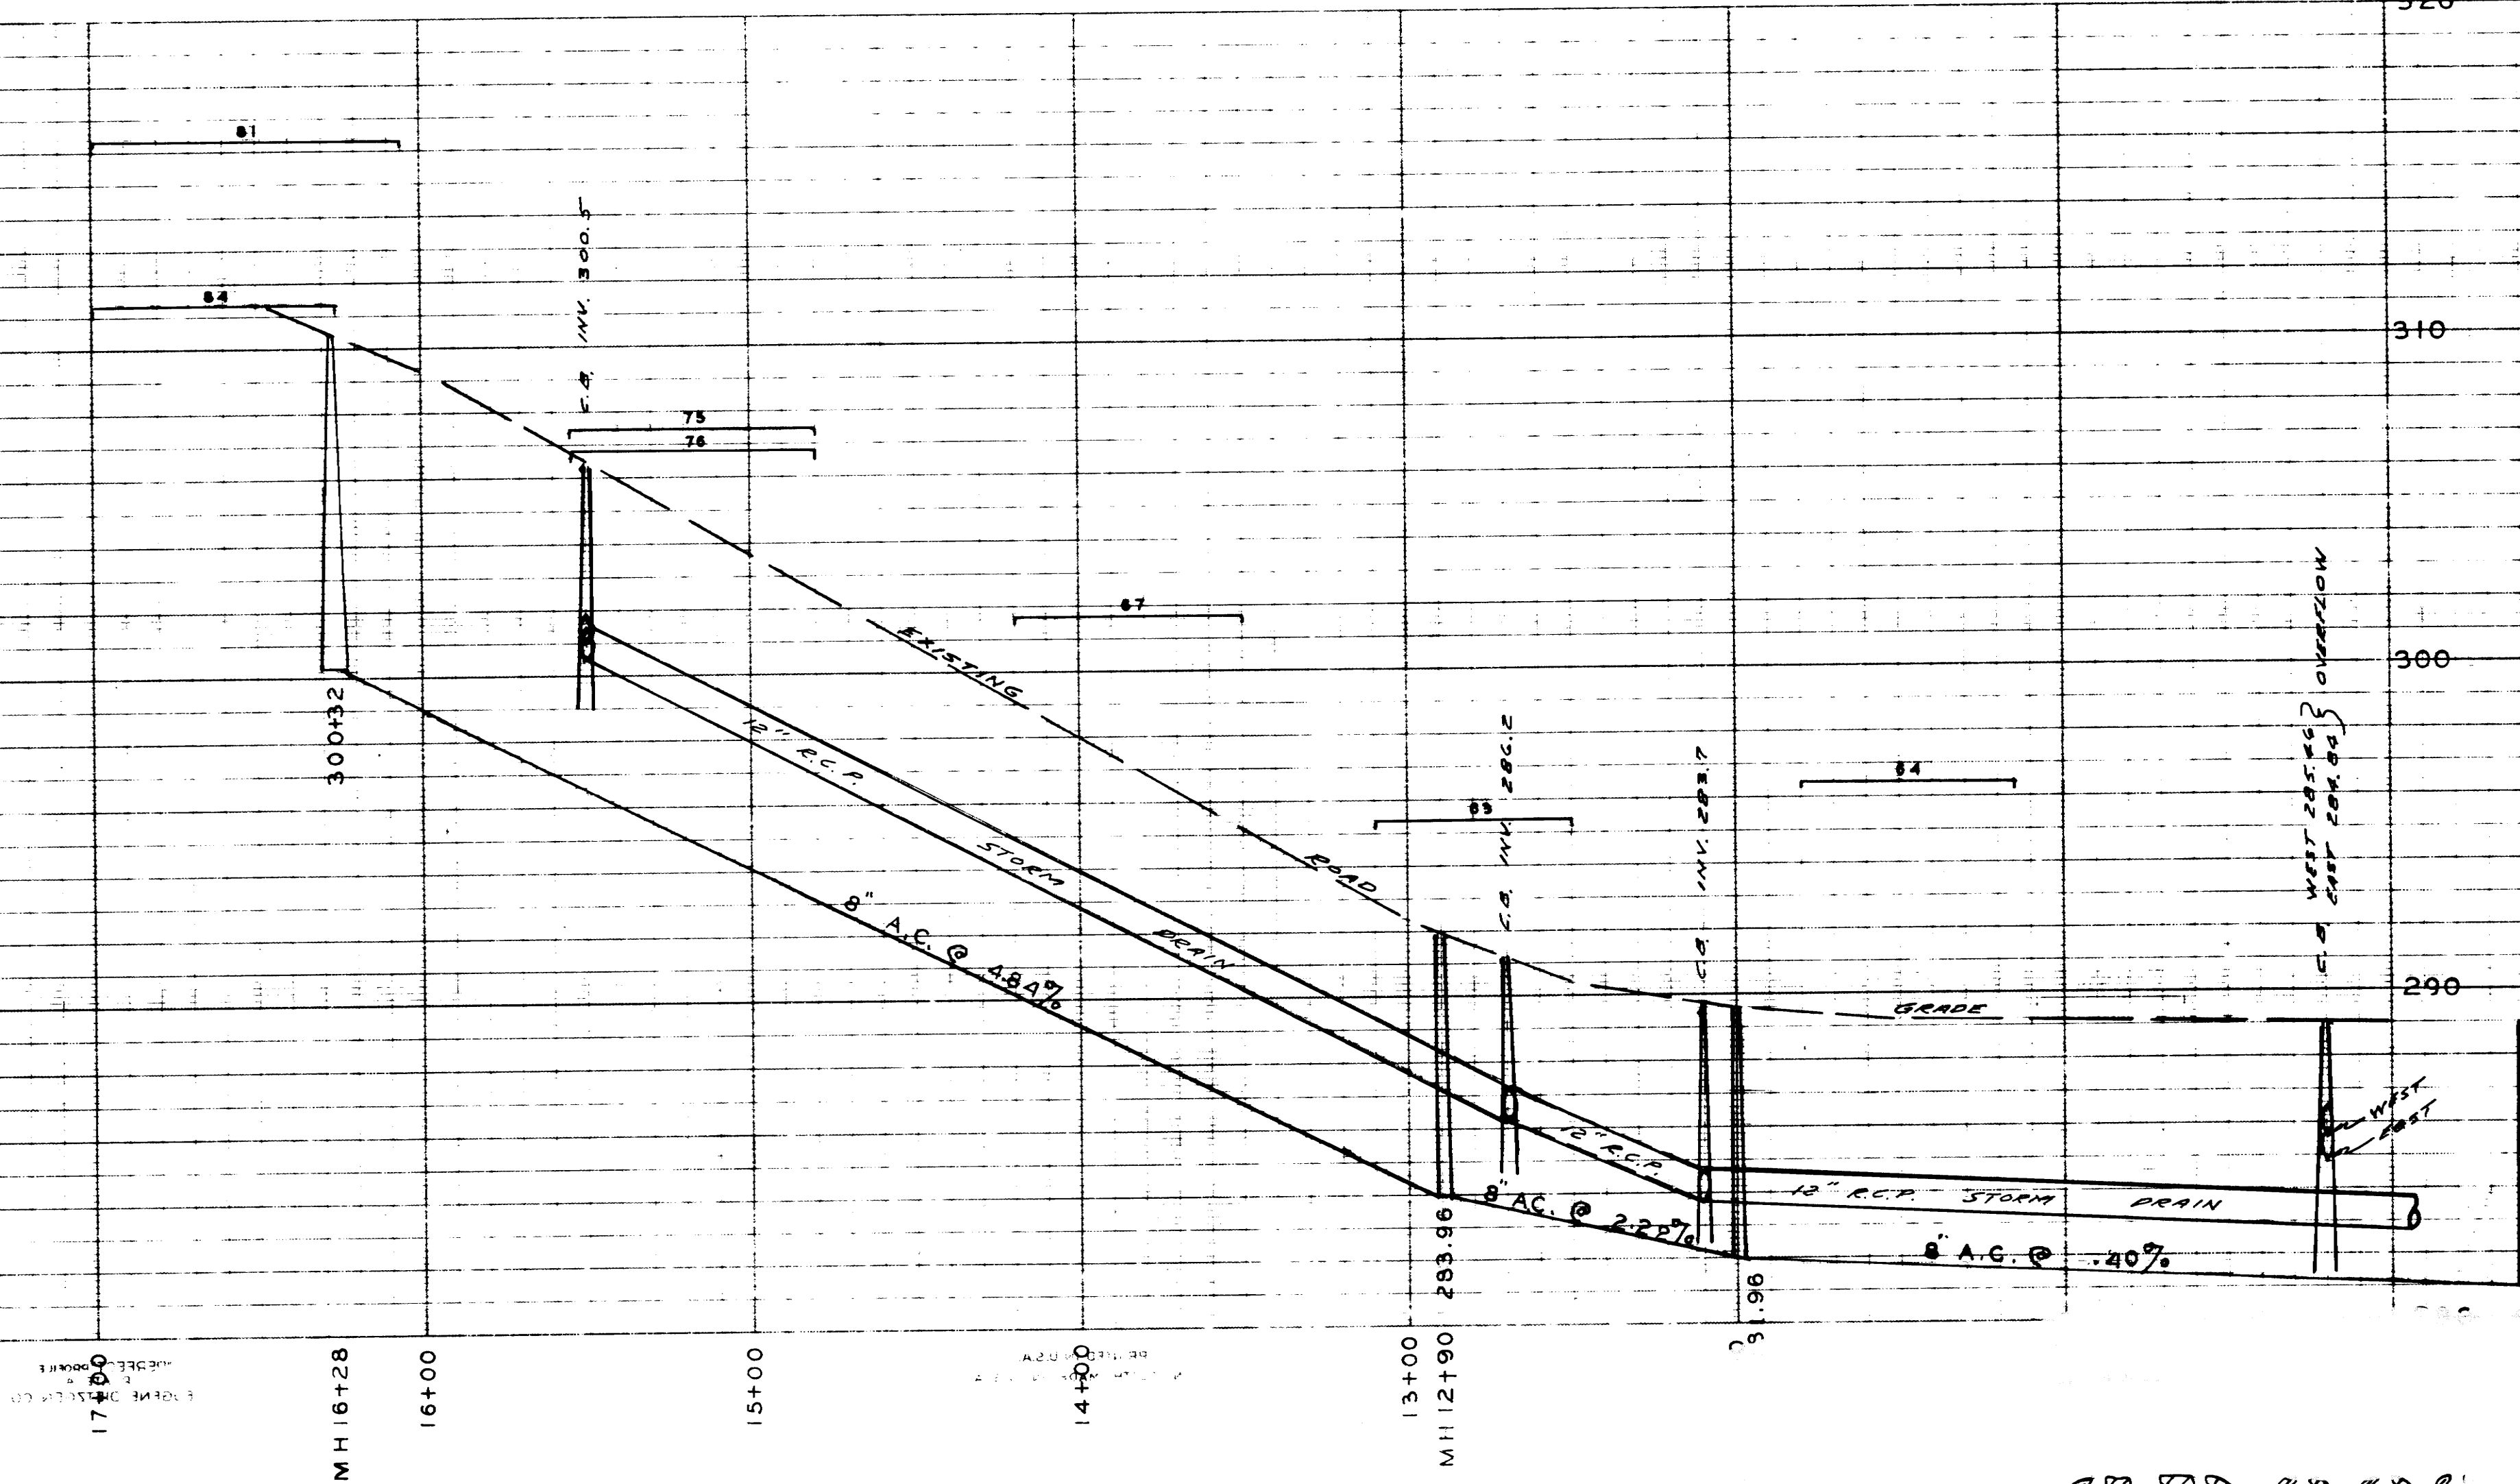

SD 20