


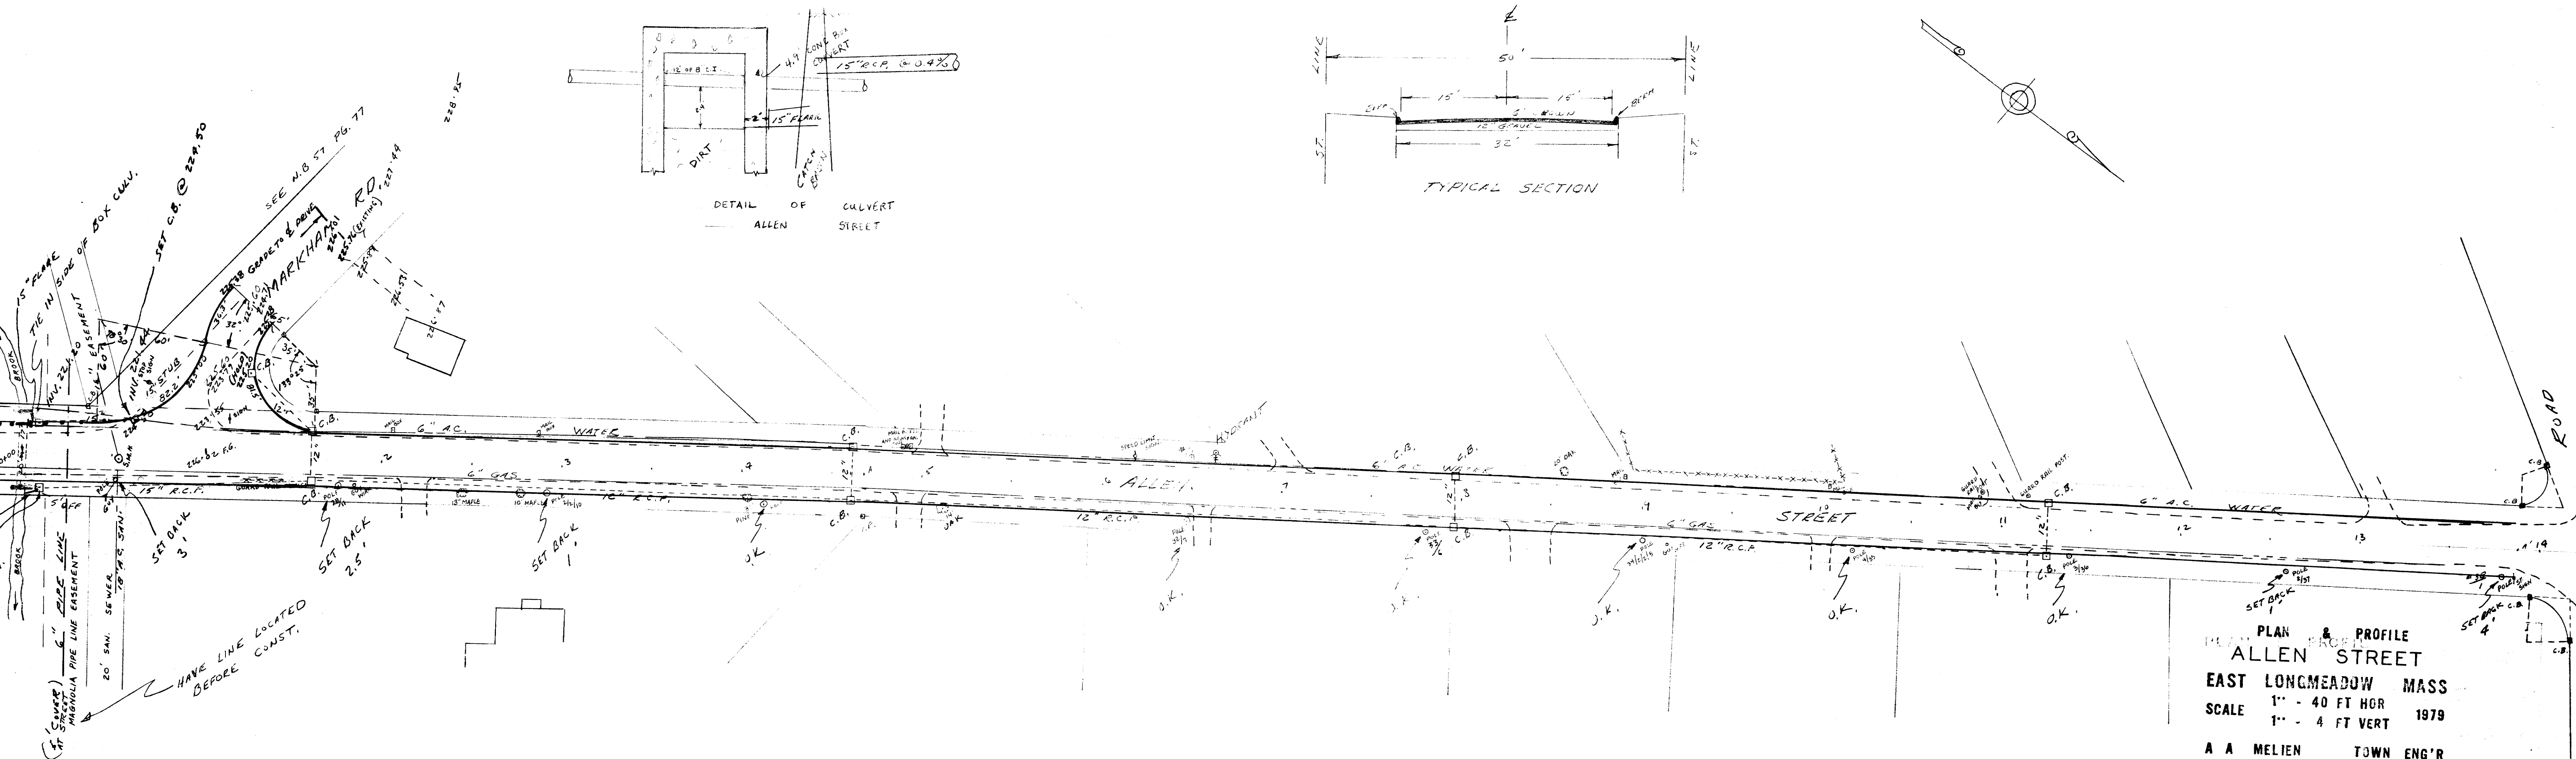

PLAN & PROFILE
ALLEN STREET
EAST LONGMEADOW MASS
SCALE 1" = 40 FT HOR
1" = 4 FT VERT 1979
A A MELIEN TOWN ENG'R

