
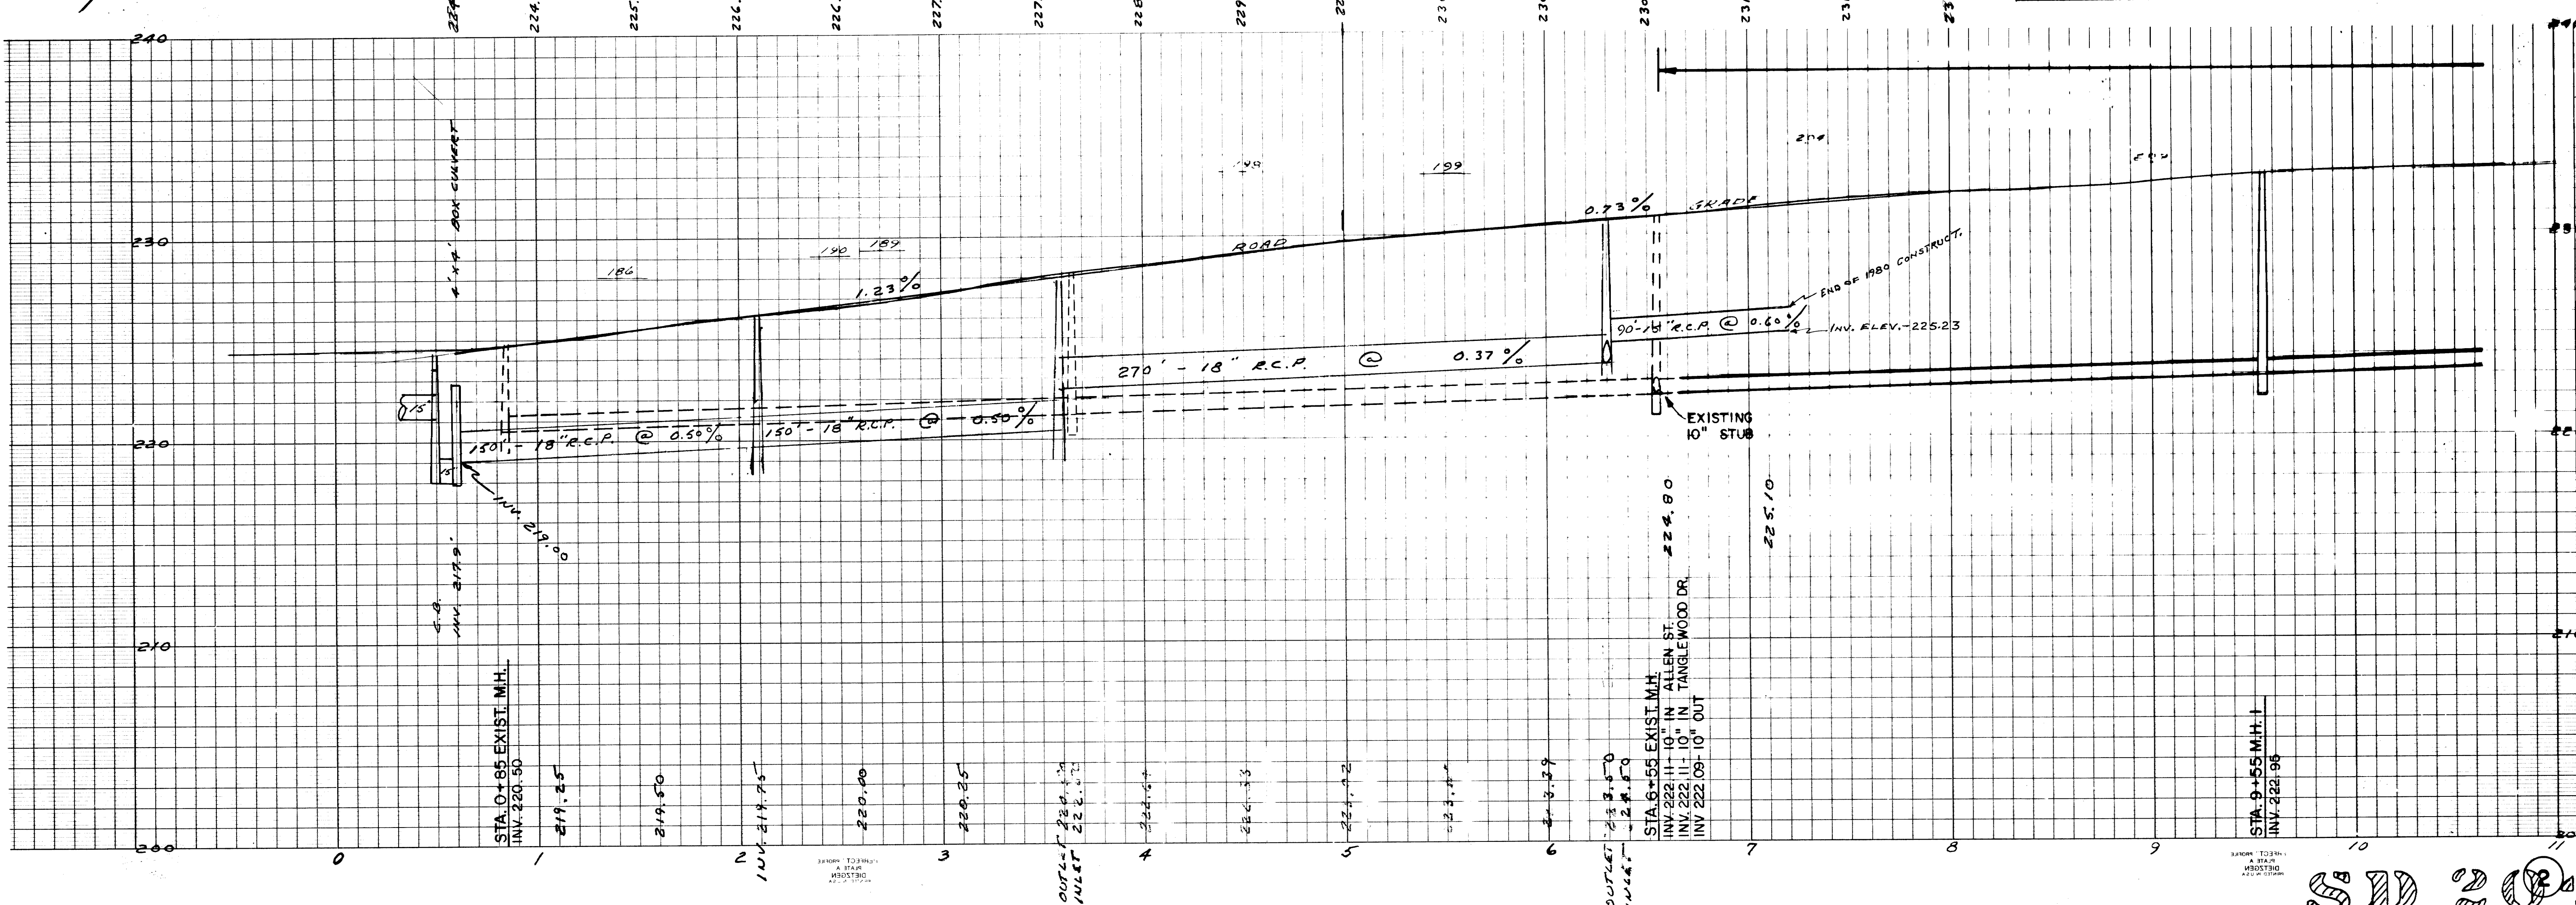


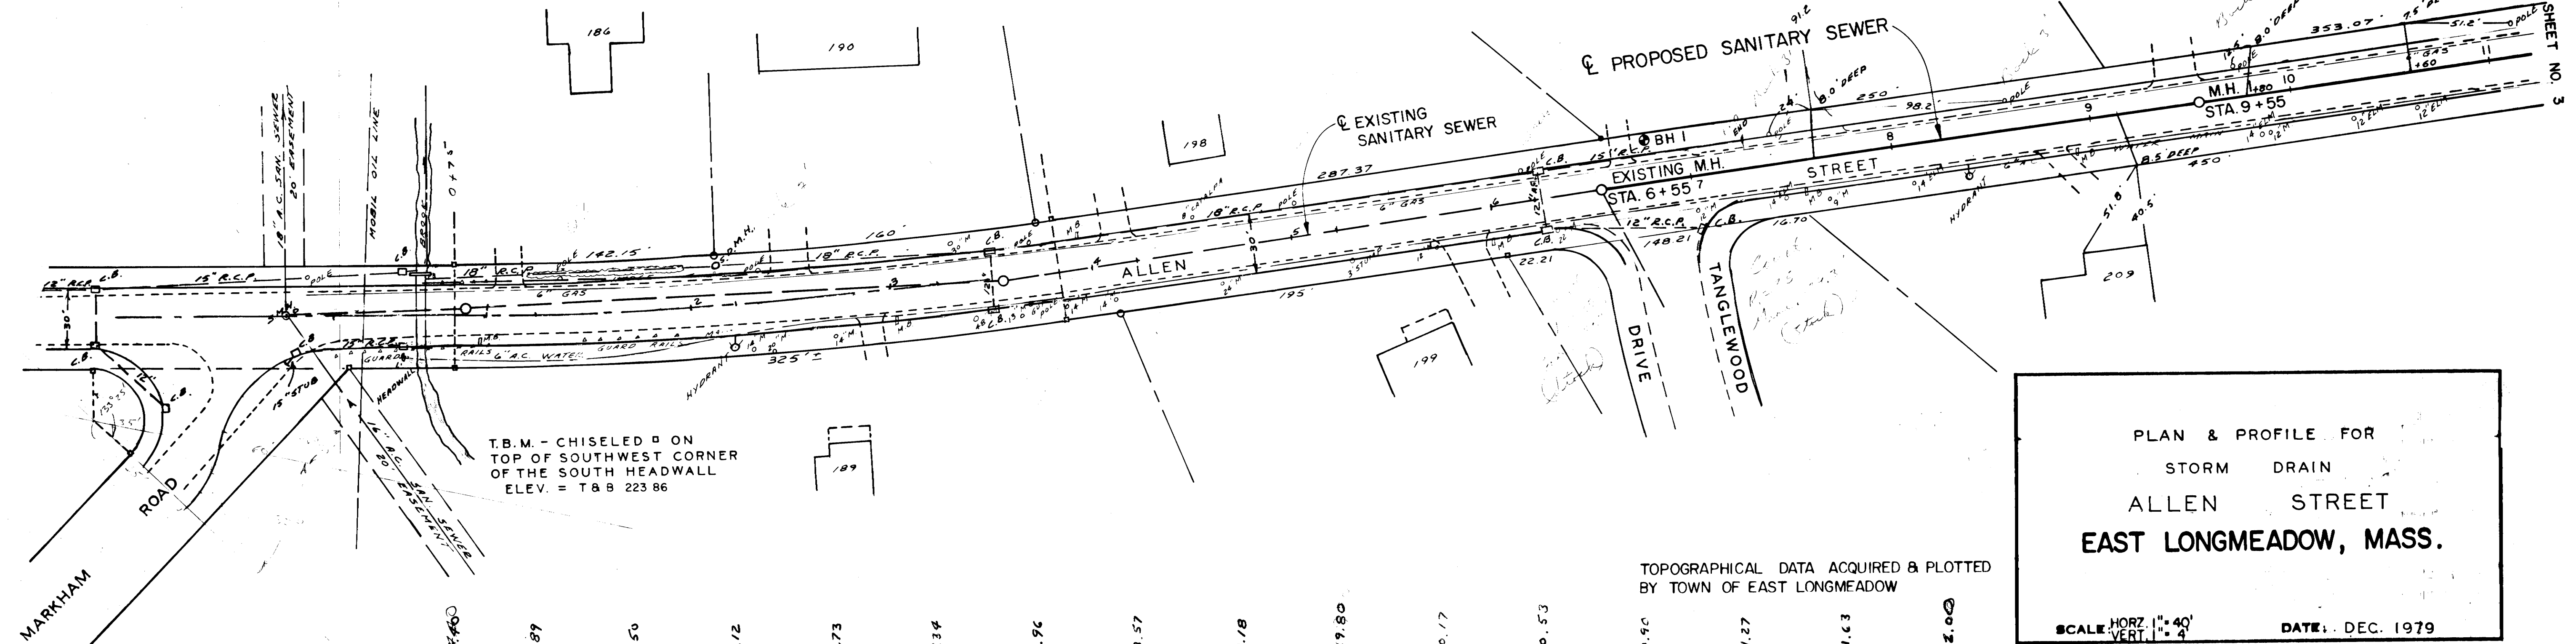

511 201