



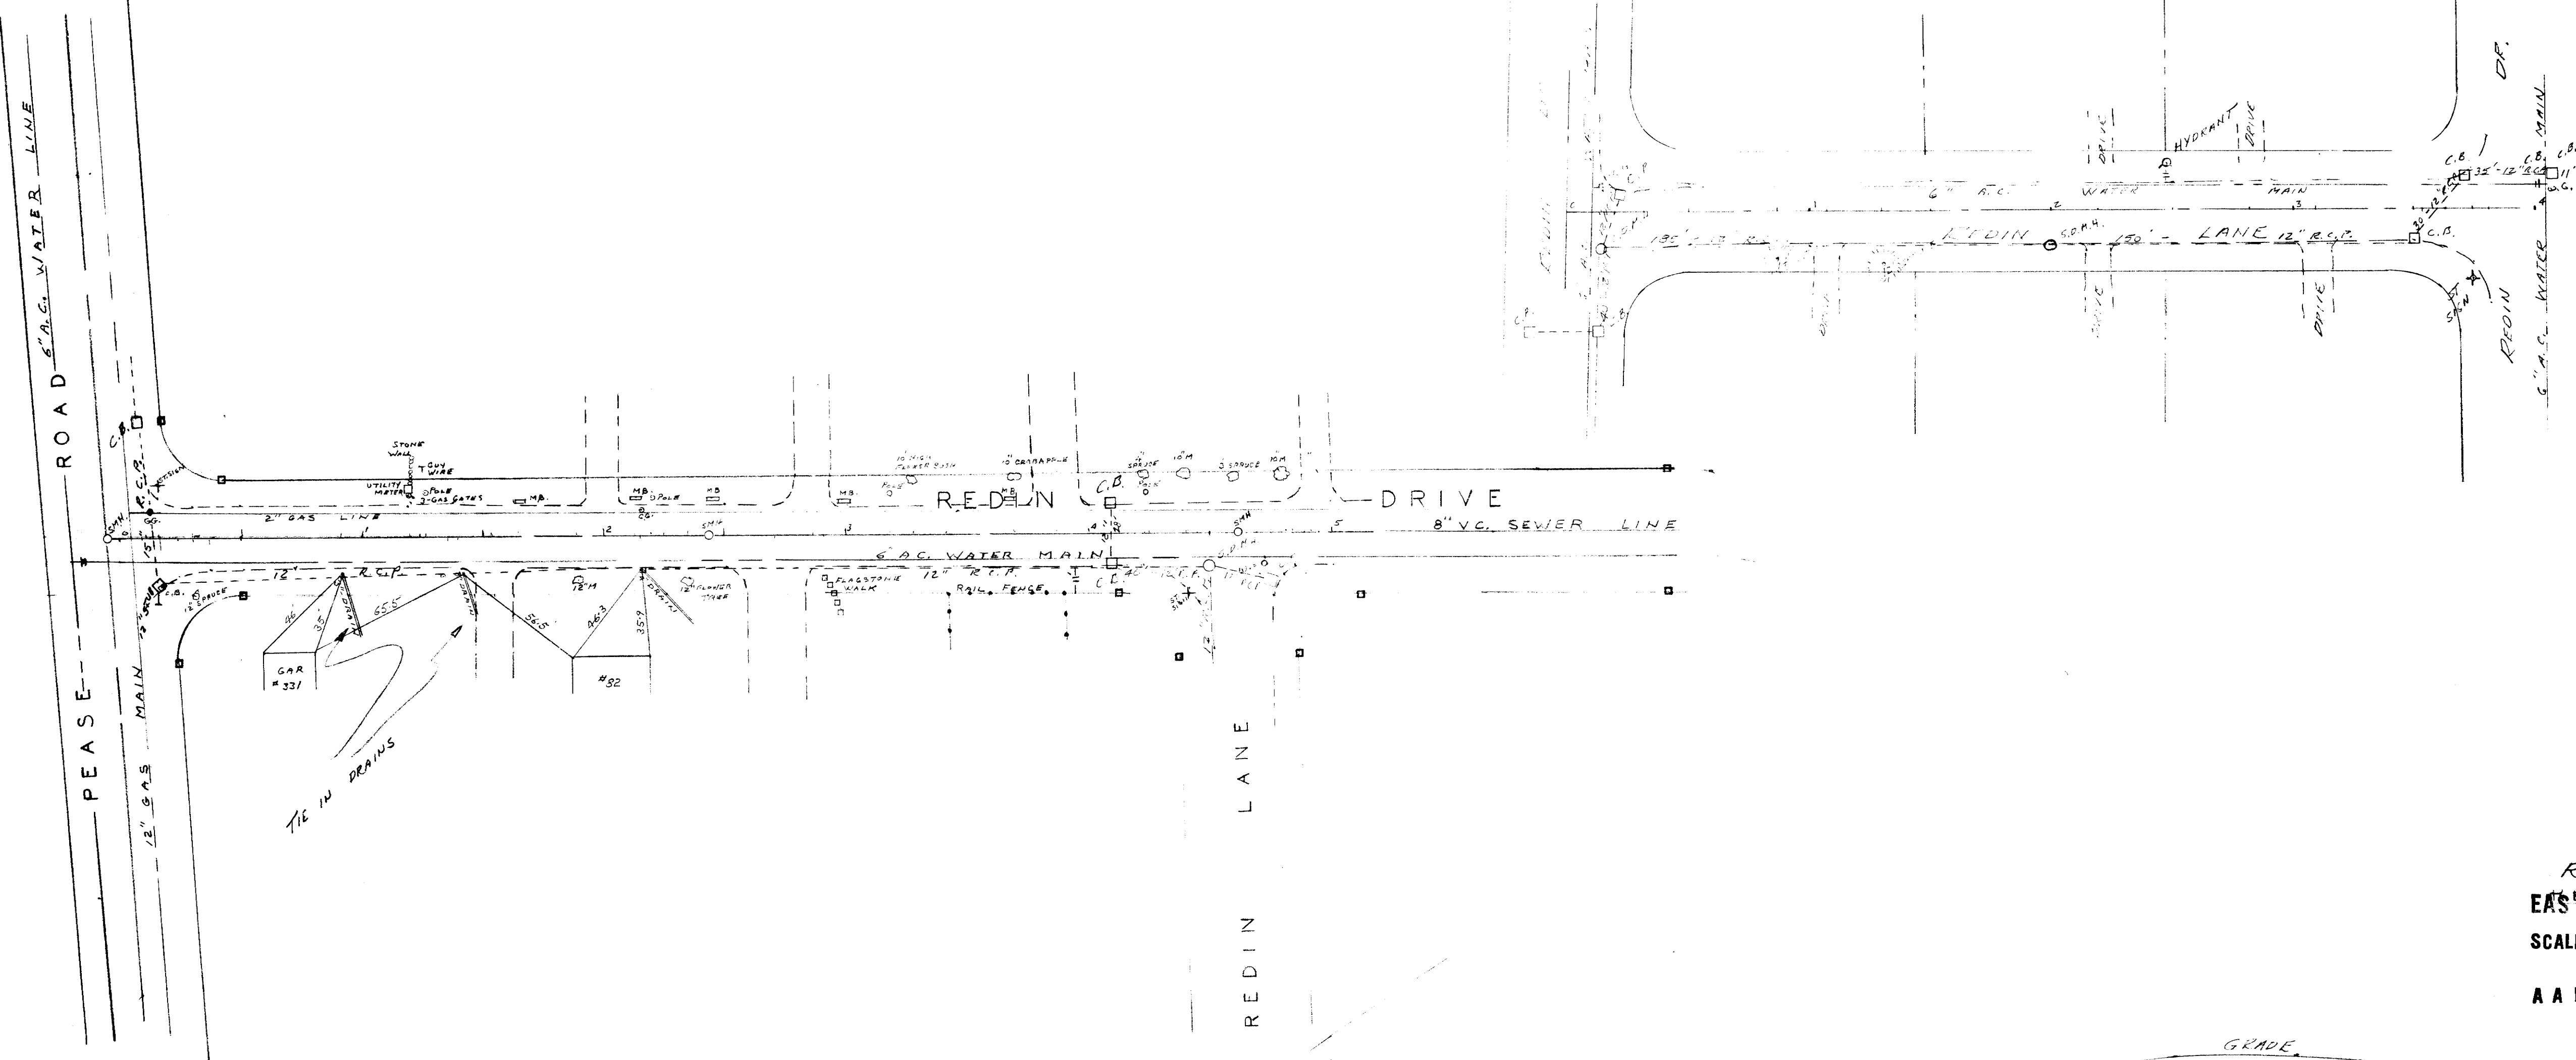

PLAN & PROFILE
 REDIN DRIVE & LANE
 EAST LONGMEADOW MASS
 SCALE 1" = 40 FT HOR 1981
 1" = 4 FT VERT
 A A MELIEN TOWN ENG'R

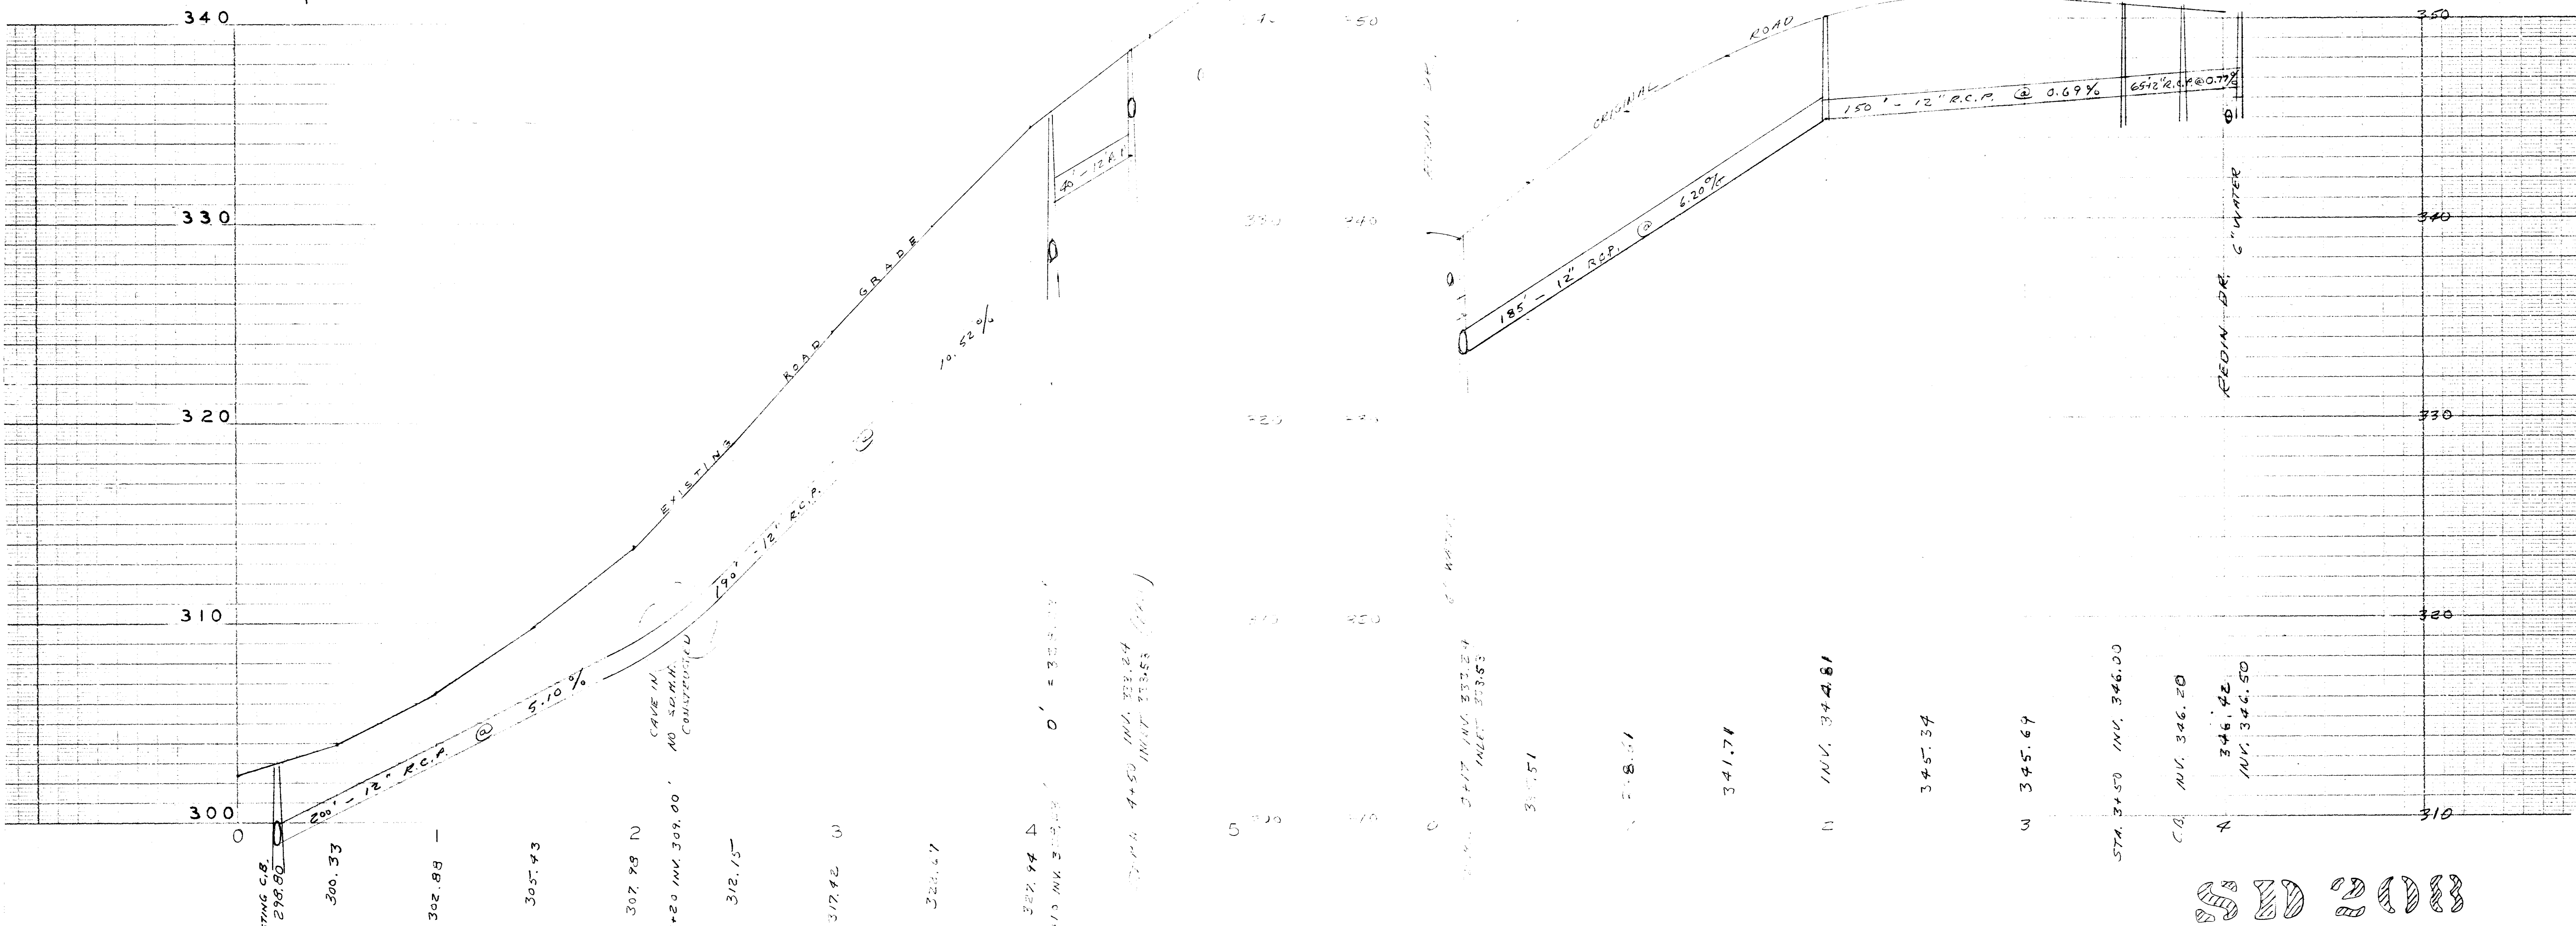

2008