



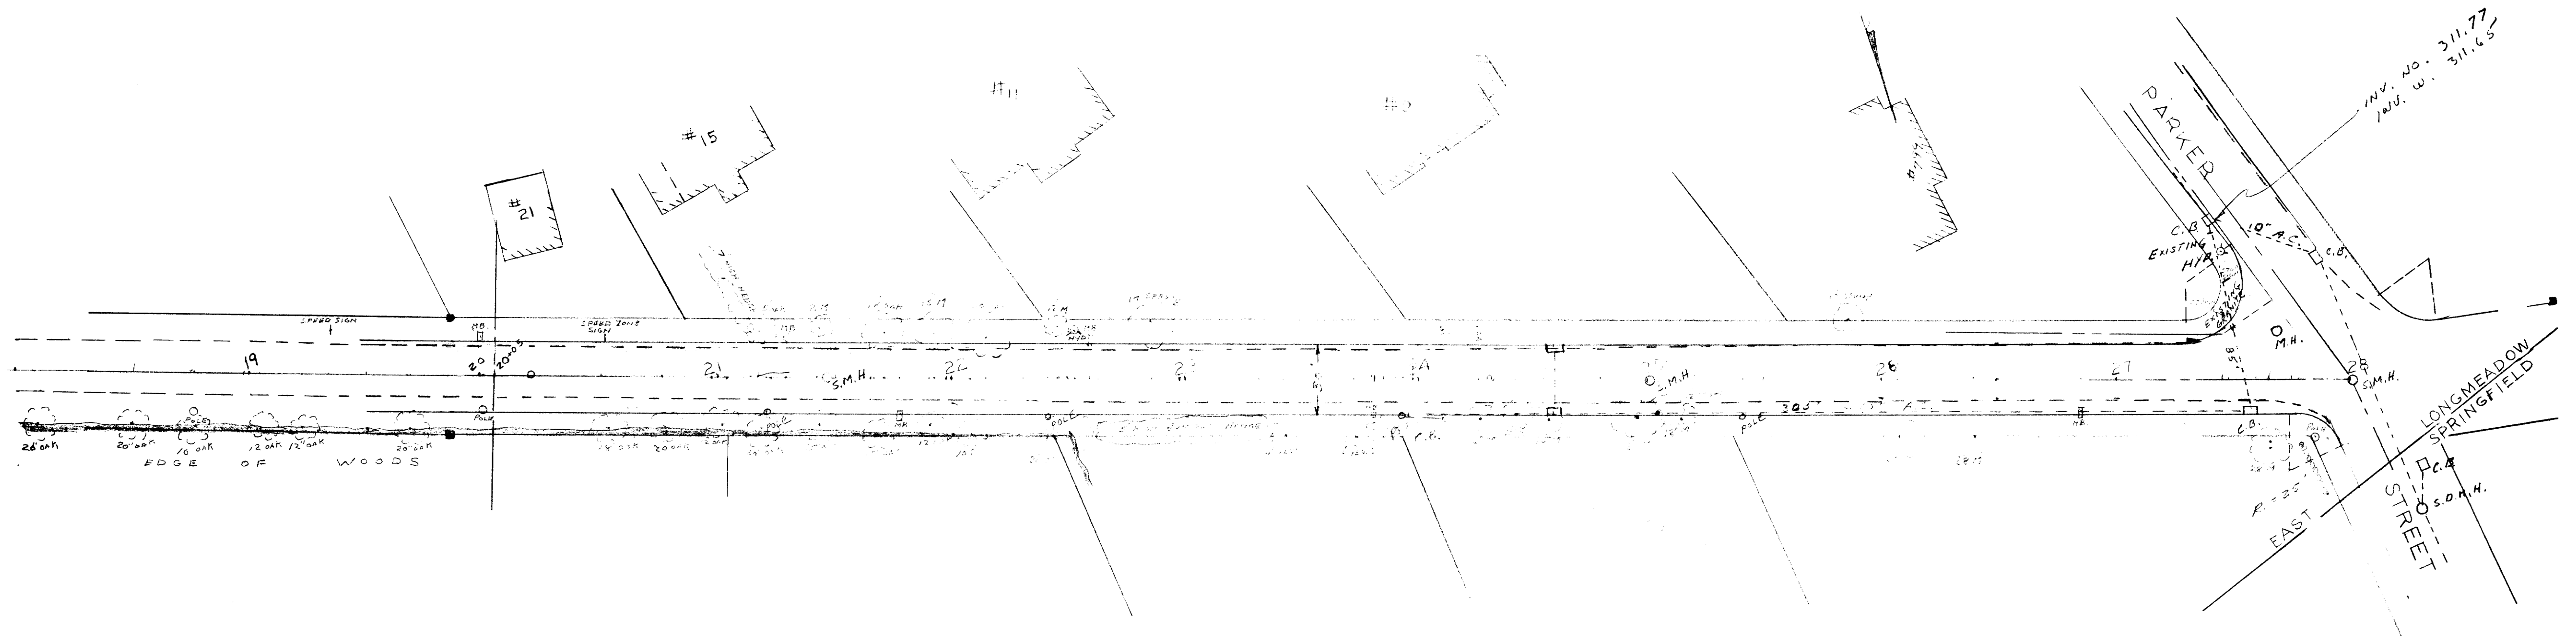

PLAN & PROFILE
 ALLEN ST.
 EAST LONGMEADOW MASS
 SCALE 1" = 40 FT HOR
 1" = 4 FT VERT
 A. A. WELIEM TOWN ENG'R

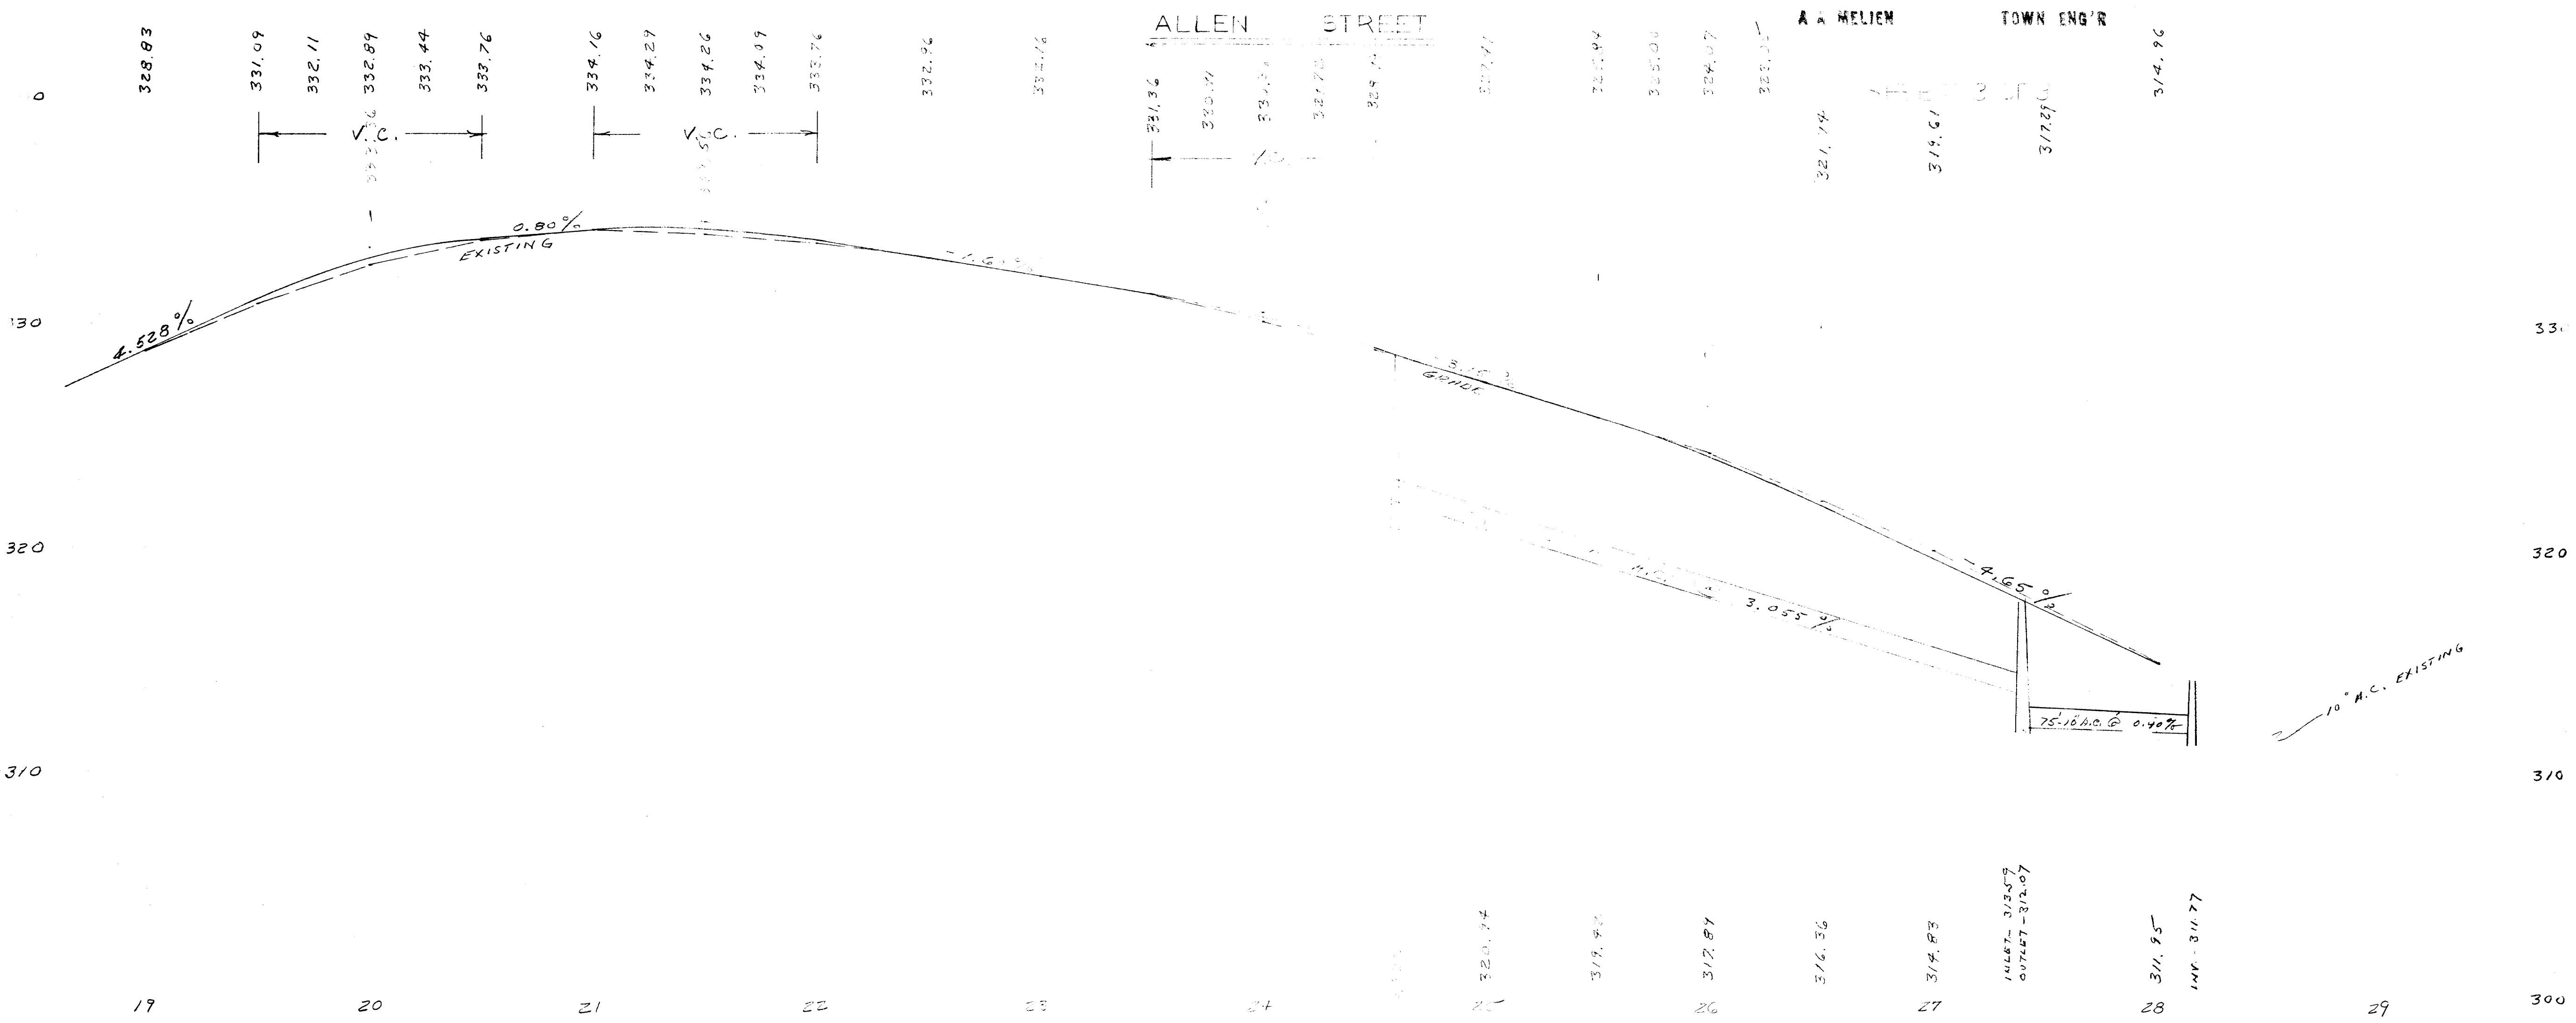

SD 209