




PLAN & PROFILE
 SWAMP DRAINAGE
 MILLBROOK DRIVE
 SCALE HORZ: 1"=40'
 VERT: 1"=4' FEB 83
 A.A. MELIEN TOWN ENGR
 TOWN OF EAST LONGMEADOW MA

SEE BOOK 62 PAGE 37-41

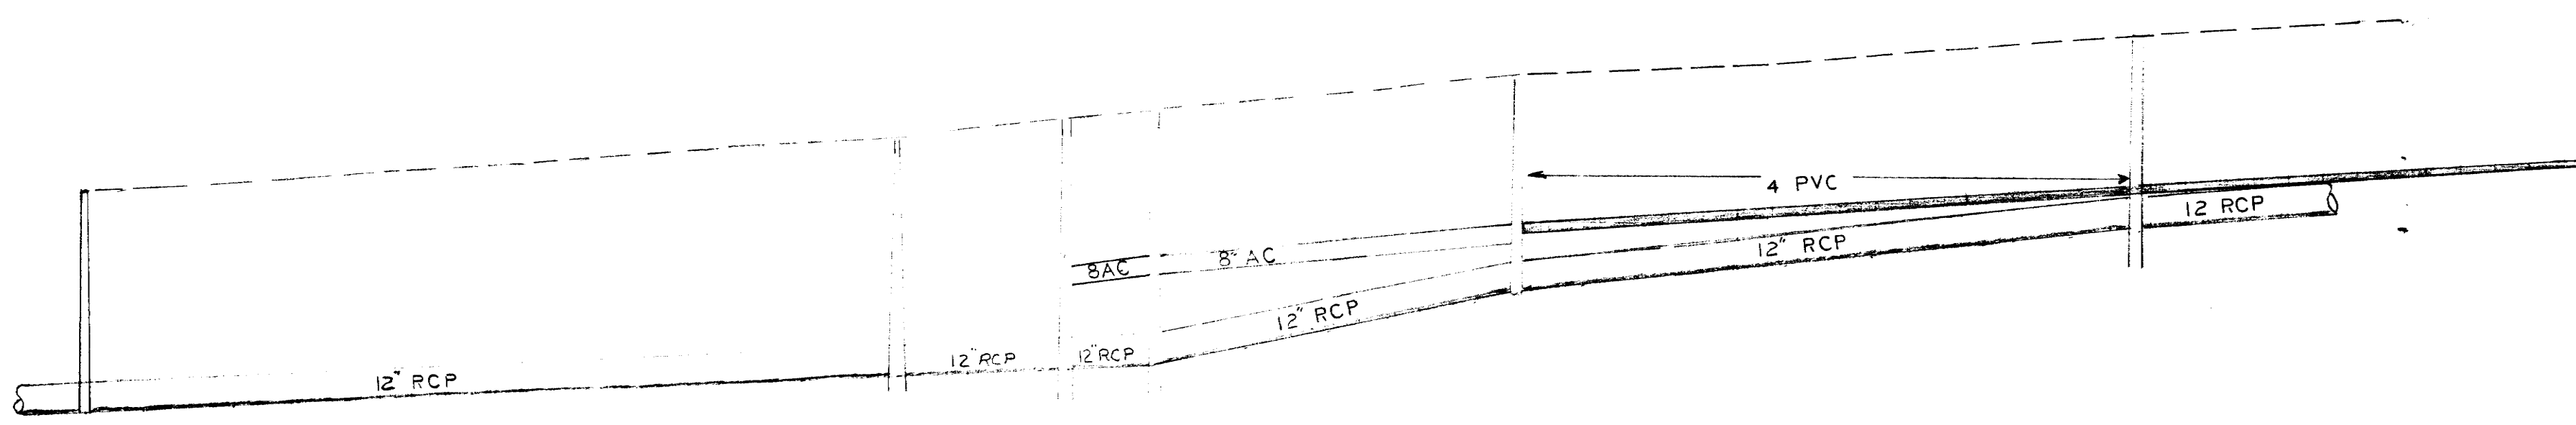

12" (OUT) 22471

SD-210