


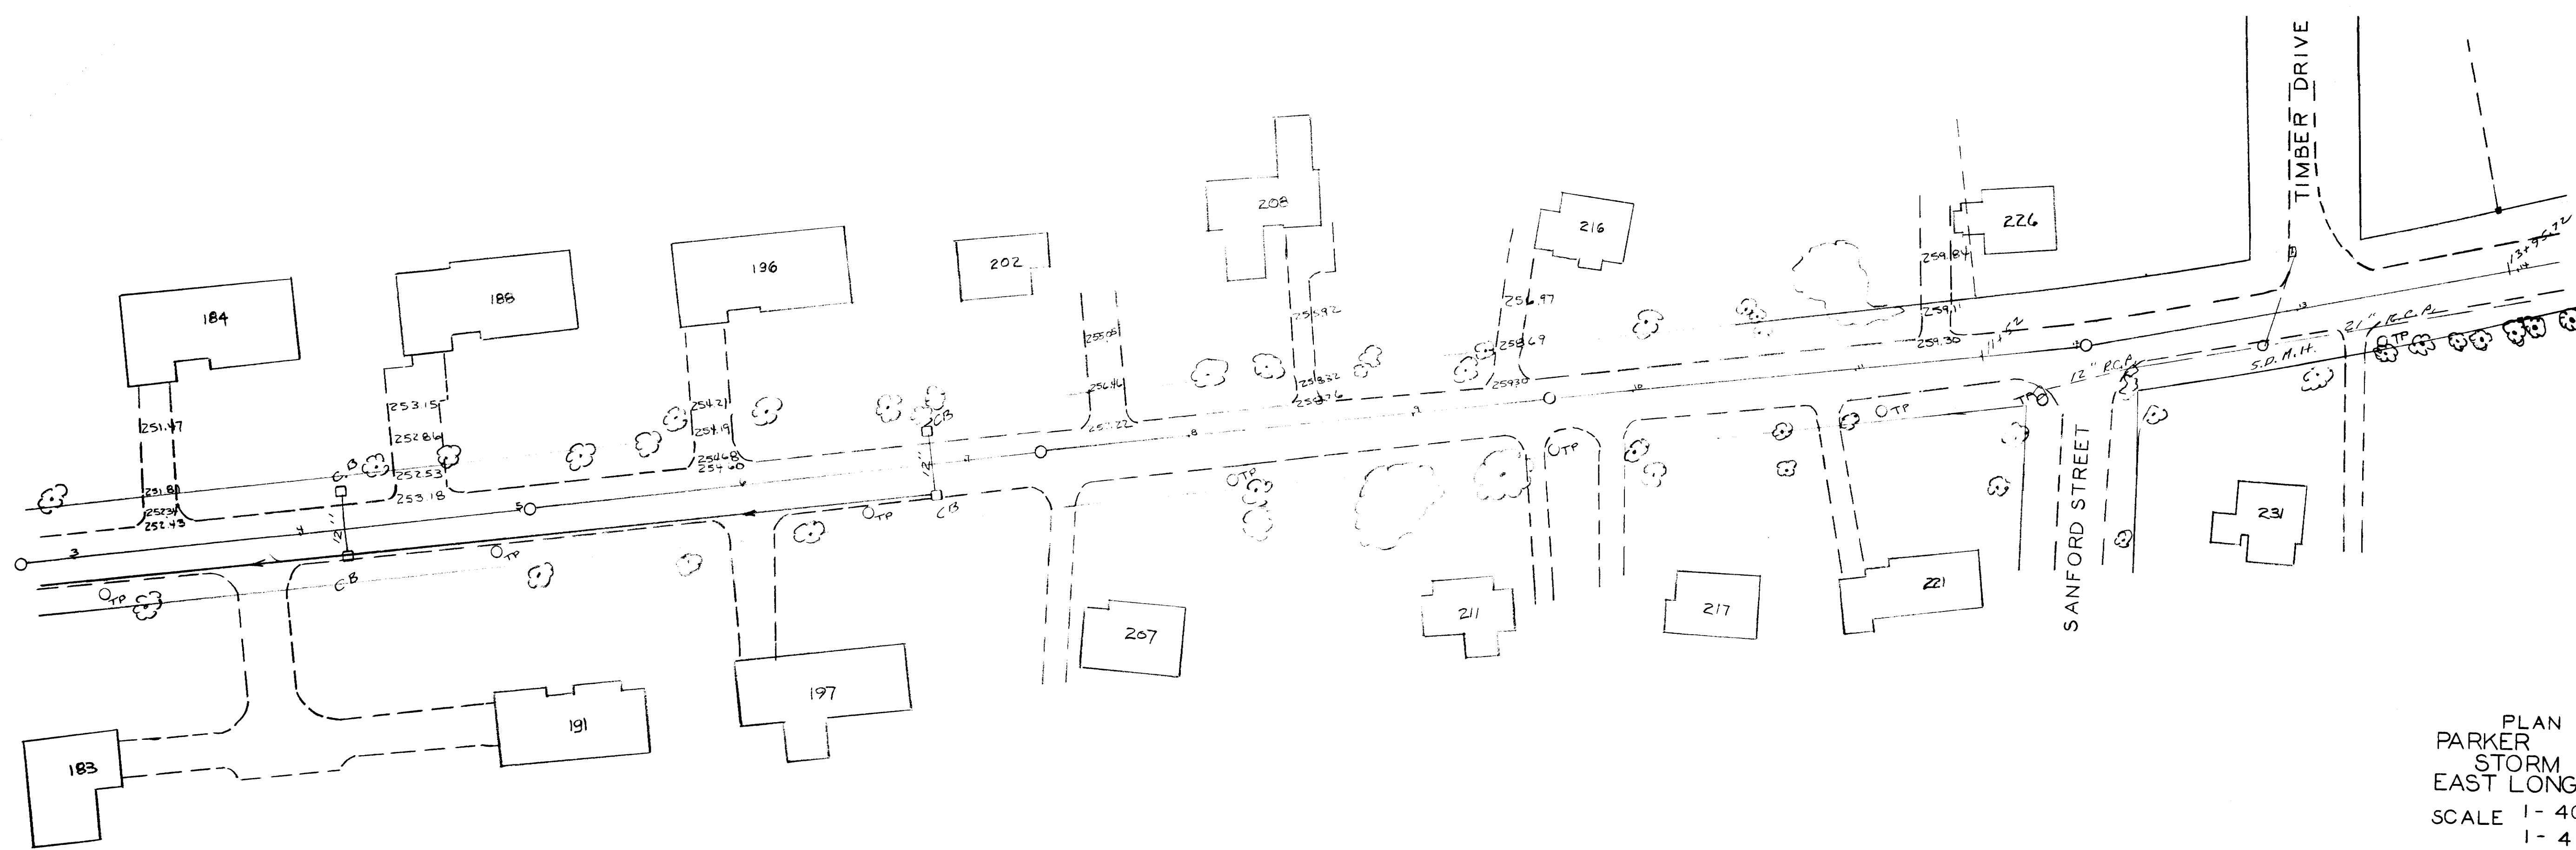

PLAN & PROFILE
PARKER STREET
STORM DRAIN
EAST LONGMEADOW MASS
SCALE 1" = 40 FT. HOR.
1" = 4 FT. VERT. 1984
A.A.MELIEN TOWN ENG.

252.75 252.90 253.12 253.39 253.72 254.44 255.16 255.89 256.60 257.32 258.04 258.76 259.48 260.20 260.92 261.64 262.36 263.08 263.80 264.52 252.17 252.40 252.63 259.76 260.00 260.23 260.46 260.69 260.92 261.15 261.38 261.61 261.84 262.07 262.30 262.53 262.76 263.00 263.23 263.46 263.69 263.92 264.15 264.38 264.61 264.84 265.07 265.30 265.53 265.76 266.00 266.23 266.46 266.69 266.92 267.15 267.38 267.61 267.84 268.07 268.30 268.53 268.76 269.00 269.23 269.46 269.69 269.92 270.15 270.38 270.61 270.84 271.07 271.30 271.53 271.76 272.00 272.23 272.46 272.69 272.92 273.15 273.38 273.61 273.84 274.07 274.30 274.53 274.76 275.00 275.23 275.46 275.69 275.92 276.15 276.38 276.61 276.84 277.07 277.30 277.53 277.76 278.00 278.23 278.46 278.69 278.92 279.15 279.38 279.61 279.84 280.07 280.30 280.53 280.76 281.00 281.23 281.46 281.69 281.92 282.15 282.38 282.61 282.84 283.07 283.30 283.53 283.76 284.00 284.23 284.46 284.69 284.92 285.15 285.38 285.61 285.84 286.07 286.30 286.53 286.76 287.00 287.23 287.46 287.69 287.92 288.15 288.38 288.61 288.84 289.07 289.30 289.53 289.76 290.00 290.23 290.46 290.69 290.92 291.15 291.38 291.61 291.84 292.07 292.30 292.53 292.76 293.00 293.23 293.46 293.69 293.92 294.15 294.38 294.61 294.84 295.07 295.30 295.53 295.76 296.00 296.23 296.46 296.69 296.92 297.15 297.38 297.61 297.84 298.07 298.30 298.53 298.76 299.00 299.23 299.46 299.69 299.92 300.15 300.38 300.61 300.84 301.07 301.30 301.53 301.76 302.00 302.23 302.46 302.69 302.92 303.15 303.38 303.61 303.84 304.07 304.30 304.53 304.76 305.00 305.23 305.46 305.69 305.92 306.15 306.38 306.61 306.84 307.07 307.30 307.53 307.76 308.00 308.23 308.46 308.69 308.92 309.15 309.38 309.61 309.84 310.07 310.30 310.53 310.76 311.00 311.23 311.46 311.69 311.92 312.15 312.38 312.61 312.84 313.07 313.30 313.53 313.76 314.00 314.23 314.46 314.69 314.92 315.15 315.38 315.61 315.84 316.07 316.30 316.53 316.76 317.00 317.23 317.46 317.69 317.92 318.15 318.38 318.61 318.84 319.07 319.30 319.53 319.76 320.00 320.23 320.46 320.69 320.92 321.15 321.38 321.61 321.84 322.07 322.30 322.53 322.76 323.00 323.23 323.46 323.69 323.92 324.15 324.38 324.61 324.84 325.07 325.30 325.53 325.76 326.00 326.23 326.46 326.69 326.92 327.15 327.38 327.61 327.84 328.07 328.30 328.53 328.76 329.00 329.23 329.46 329.69 329.92 330.15 330.38 330.61 330.84 331.07 331.30 331.53 331.76 332.00 332.23 332.46 332.69 332.92 333.15 333.38 333.61 333.84 334.07 334.30 334.53 334.76 335.00 335.23 335.46 335.69 335.92 336.15 336.38 336.61 336.84 337.07 337.30 337.53 337.76 338.00 338.23 338.46 338.69 338.92 339.15 339.38 339.61 339.84 340.07 340.30 340.53 340.76 341.00 341.23 341.46 341.69 341.92 342.15 342.38 342.61 342.84 343.07 343.30 343.53 343.76 344.00 344.23 344.46 344.69 344.92 345.15 345.38 345.61 345.84 346.07 346.30 346.53 346.76 347.00 347.23 347.46 347.69 347.92 348.15 348.38 348.61 348.84 349.07 349.30 349.53 349.76 350.00 350.23 350.46 350.69 350.92 351.15 351.38 351.61 351.84 352.07 352.30 352.53 352.76 353.00 353.23 353.46 353.69 353.92 354.15 354.38 354.61 354.84 355.07 355.30 355.53 355.76 356.00 356.23 356.46 356.69 356.92 357.15 357.38 357.61 357.84 358.07 358.30 358.53 358.76 359.00 359.23 359.46 359.69 359.92 360.15 360.38 360.61 360.84 361.07 361.30 361.53 361.76 362.00 362.23 362.46 362.69 362.92 363.15 363.38 363.61 363.84 364.07 364.30 364.53 364.76 365.00 365.23 365.46 365.69 365.92 366.15 366.38 366.61 366.84 367.07 367.30 367.53 367.76 368.00 368.23 368.46 368.69 368.92 369.15 369.38 369.61 369.84 370.07 370.30 370.53 370.76 371.00 371.23 371.46 371.69 371.92 372.15 372.38 372.61 372.84 373.07 373.30 373.53 373.76 374.00 374.23 374.46 374.69 374.92 375.15 375.38 375.61 375.84 376.07 376.30 376.53 376.76 377.00 377.23 377.46 377.69 377.92 378.15 378.38 378.61 378.84 379.07 379.30 379.53 379.76 380.00 380.23 380.46 380.69 380.92 381.15 381.38 381.61 381.84 382.07 382.30 382.53 382.76 383.00 383.23 383.46 383.69 383.92 384.15 384.38 384.61 384.84 385.07 385.30 385.53 385.76 386.00 386.23 386.46 386.69 386.92 387.15 387.38 387.61 387.84 388.07 388.30 388.53 388.76 389.00 389.23 389.46 389.69 389.92 390.15 390.38 390.61 390.84 391.07 391.30 391.53 391.76 392.00 392.23 392.46 392.69 392.92 393.15 393.38 393.61 393.84 394.07 394.30 394.53 394.76 395.00 395.23 395.46 395.69 395.92 396.15 396.38 396.61 396.84 397.07 397.30 397.53 397.76 398.00 398.23 398.46 398.69 398.92 399.15 399.38 399.61 399.84 400.07 400.30 400.53 400.76 401.00 401.23 401.46 401.69 401.92 402.15 402.38 402.61 402.84 403.07 403.30 403.53 403.76 404.00 404.23 404.46 404.69 404.92 405.15 405.38 405.61 405.84 406.07 406.30 406.53 406.76 407.00 407.23 407.46 407.69 407.92 408.15 408.38 408.61 408.84 409.07 409.30 409.53 409.76 410.00 410.23 410.46 410.69 410.92 411.15 411.38 411.61 411.84 412.07 412.30 412.53 412.76 413.00 413.23 413.46 413.69 413.92 414.15 414.38 414.61 414.84 415.07 415.30 415.53 415.76 416.00 416.23 416.46 416.69 416.92 417.15 417.38 417.61 417.84 418.07 418.30 418.53 418.76 419.00 419.23 419.46 419.69 419.92 420.15 420.38 420.61 420.84 421.07 421.30 421.53 421.76 422.00 422.23 422.46 422.69 422.92 423.15 423.38 423.61 423.84 424.07 424.30 424.53 424.76 425.00 425.23 425.46 425.69 425.92 426.15 426.38 426.61 426.84 427.07 427.30 427.53 427.76 428.00 428.23 428.46 428.69 428.92 429.15 429.38 429.61 429.84 430.07 430.30 430.53 430.76 431.00 431.23 431.46 431.69 431.92 432.15 432.38 432.61 432.84 433.07 433.30 433.53 433.76 434.00 434.23 434.46 434.69 434.92 435.15 435.38 435.61 435.84 436.07 436.30 436.53 436.76 437.00 437.23 437.46 437.69 437.92 438.15 438.38 438.61 438.84 439.07 439.30 439.53 439.76 440.00 440.23 440.46 440.69 440.92 441.15 441.38 441.61 441.84 442.07 442.30 442.53 442.76 443.00 443.23 443.46 443.69 443.92 444.15 444.38 444.61 444.84 445.07 445.30 445.53 445.76 446.00 446.23 446.46 446.69 446.92 447.15 447.38 447.61 447.84 448.07 448.30 448.53 448.76 449.00 449.23 449.46 449.69 449.92 450.15 450.38 450.61 450.84 451.07 451.30 451.53 451.76 452.00 452.23 452.46 452.69 452.92 453.15 453.38 453.61 453.84 454.07 454.30 454.53 454.76 455.00 455.23 455.46 455.69 455.92 456.15 456.38 456.61 456.84 457.07 457.30 457.53 457.76 458.00 458.23 458.46 458.69 458.92 459.15 459.38 459.61 459.84 460.07 460.30 460.53 460.76 461.00 461.23 461.46 461.69 461.92 462.15 462.38 462.61 462.84 463.07 463.30 463.53 463.76 464.00 464.23 464.46 464.69 464.92 465.15 465.38 465.61 465.84 466.07 466.30 466.53 466.76 467.00 467.23 467.46 467.69 467.92 468.15 468.38 468.61 468.84 469.07 469.30 469.53 469.76 470.00 470.23 470.46 470.69 470.92 471.15 471.38 471.61 471.84 472.07 472.30 472.53 472.76 473.00 473.23 473.46 473.69 473.92 474.15 474.38 474.61 474.84 475.07 475.30 475.53 475.76 476.00 476.23 476.46 476.69 476.92 477.15 477.38 477.61 477.84 478.07 478.30 478.53 478.76 479.00 479.23 479.46 479.69 479.92 480.15 480.38 480.61 480.84 481.07 481.30 481.53 481.76 482.00 482.23 482.46 482.69 482.92 483.15 483.38 483.61 483.84 484.07 484.30 484.53 484.76 485.00 485.23 485.46 485.69 485.92 486.15 486.38 486.61 486.84 487.07 487.30 487.53 487.76 488.00 488.23 488.46 488.69 488.92 489.15 489.38 489.61 489.84 490.07 490.30 490.53 490.76 491.00 491.23 491.46 491.69 491.92 492.15 492.38 492.61 492.84 493.07 493.30 493.53 493.76 494.00 494.23 494.46 494.69 494.92 495.15 495.38 495.61 495.84 496.07 496.30 496.53 496.76 497.00 497.23 497.46 497.69 497.92 498.15 498.38 498.61 498.84 499.07 499.30 499.53 499.76 500.00 500.23 500.46 500.69 500.92 501.15 501.38 501.61 501.84 502.07 502.30 502.53 502.76 503.00 503.23 503.46 503.69 503.92 504.15 504.38 504.61 504.84 505.07 505.30 505.53 505.76 506.00 506.23 506.46 506.69 506.92 507.15 507.38 507.61 507.84 508.07 508.30 508.53 508.76 509.00 509.23 509.46 509.69 509.92 510.15 510.38 510.61 510.84 511.07 511.30 511.53 511.76 512.00 512.23 512.46 512.69 512.92 513.15 513.38 513.61 513.84 514.07 514.30 514.53 514.76 515.00 515.23 515.46 515.69 515.92 516.15 516.38 516.61 516.84 517.07 517.30 517.53 517.76 518.00 518.23 518.46 518.69 518.92 519.15 519.38 519.61 519.84 520.07 520.30 520.53 520.76 521.00 521.23 521.46 521.69 521.92 522.15 522.38 522.61 522.84 523.07 523.30 523.53 523.76 524.00 524.23 524.46 524.69 524.92 525.15 525.38 525.61 525.84 526.07 526.30 526.53 526.76 527.00 527.23 527.46 527.69 527.92 528.15 528.38 528.61 528.84 529.07 529.30 529.53 529.76 530.00 530.23 530.46 530.69 530.92 531.15 531.38 531.61 531.84 532.07 532.30 532.53 532.76 533.00 533.23 533.46 533.69 533.92 534.15 534.38 534.61 534.84 535.07 535.30 535.53 535.76 536.00 536.23 536.46 536.69 536.92 537.15 537.38 537.61 537.84 538.07 538.30 538.53 538.76 539.00 539.23 539.46 539.69 539.92 540.15 540.38 540.61 540.84 541.07 541.30 541.53 541.76 542.00 542.23 542.46 542.69 542.92 543.15 543.38 543.61 543.84 544.07 544.30 544.53 544.76 545.00 545.23 545.46 545.69 545.92 546.15 546.38 546.61 546.84 547.07 547.30 547.53 547.76 548.00 548.23 548.46 548.69 548.92 549.15 549.38 549.61 549.84 550.07 550.30 550.53 550.76 551.00 551.23 551.46 551.69 551.92 552.15 552.38 552.61 552.84 553.07 553.30 553.53 553.76 554.00 554.23 554.46 554.69 554.92 555.15 555.38 555.61 555.84 556.07 556.30 556.53 556.76 557.00 557.23 557.46 557.69 557.92 558.15 558.38 558.61 558.84 559.07 559.30 559.53 559.76 560.00 560.23 560.46 560.69 560.92 561.15 561.38 561.61 561.84 562.07 562.30 562.53 562.76 563.00 563.23 563.46 563.69 563.92 564.15 564.38 564.61 564.84 565.07 565.30 565.53 565.76 566.00 566.23 566.46 566.69 566.92 567.15 567.38 567.61 567.84 568.07 568.30 568.53 568.76 569.00 569.23 569.46 569.69 569.92 570.15 570.38 570.61 570.84 571.07 571.30 571.53 571.76 572.00 572.23 572.46 572.69 572.92 573.15 573.38 573.61 573.84 574.07 574.30 574.53 574.76 575.00 575.23 575.46 575.69 575.92 576.15 576.38 576.61 576.84 577.07 577.30 577.53 577.76 578.00 578.23 578.46 578.69 578.92 579.15 579.38 579.61 579.84 580.07 580.30 580.53 580.76 581.00 581.23 581.46 581.69 581.92 582.15 582.38 582.61 582.84 583.07 583.30 583.53 583.76 584.00 584.23 584.46 584.69 584.92 585.15 585.38 585.61 585.84 586.07 586.30 586.53 586.76 587.00 587.23 587.46 587.69 587.92 588.15 588.38 588.61 588.84 589.07 589.30 589.53 589.76 590.00 590.23 590.46 590.69 590.92 591.15 591.38 591.61 591.84 592.07 592.30 592.53 592.76 593.00 593.23 593.46 593.69 593.92 594.15 594.38 594.61 594.84 595.07 595.30 595.53 595.76 596.00 596.23 596.46 596.69 596.92 597.15 597.38 597.61 597.84 598.07 598.30 598.53 598.76 599.00 599.23 599.46 599.69 599.92 600.15 600.38 600.61 600.84 601.07 601.30 601.53 601.76 602.00 602.23 602.46 602.69 602.92 603.15 603.38 603.61 603.84 604.07 604.30 604.53 604.76 605.00 605.23 605.46 605.69 605.92 606.15 606.38 606.61 606.84 607.07 607.30 607.53 607.76 608.00 608.23 608.46 608.69 608.92 609.15 609.38 609.61 609.84 610.07 610.30 610.53 610.76 611.00 611.23 611.46 611.69 611.92 612.15 612.38 612.61 612.84 613.07 613.30 613.53 613.76 614.00 614.23 614.46 614.69 614.92 615.15 615.38 615.61 615.84 616.07 616.30 616.53 616.76 617.00 617.23 617.46 617.69 617.92 618.15 618.38 618.61 618.84 619.07 619.30 619.53 619.76 620.00 620.23 620.46 620.69 620.92 621.15 621.38 621.61 621.84 622.07 622.30 622.53 622.76 623.00 623.23 623.46 623.69 623.92 624.15 624.38 624.61 624.84 625.07 625.30 625.53 625.76 626.00 626.23 626.46 626.69 626.92 627.15 627.38 627.61 627.84 628.07 628.30 628.53 628.76 629.00 629.23 629.46 629.69 629.92 630.15 630.38 630.61 630.84 631.07 631.30 631.53 631.76 632.00 632.23 632.46 632.69 632.92 633.15 633.38 633.61 633.84 634.07 634.30 634.53 634.76 635.00 635.23 635.46 635.69 635.92 636.15 636.38 636.61 636.84 637.07 637.30 637.53 637.76 638.00 638.23 638.46 638.69 638.92 639.15 639.38 639.61 639.84 640.07 640.30 640.53 640.76 641.00 641.23 641.46 641.69 641.92 642.15 642.38 642.61 642.84 643.07 643.30 643.53 643.76 644.00 644.23 644.46 644.69 644.92 645.15 645.38 645.61 645.84 64