


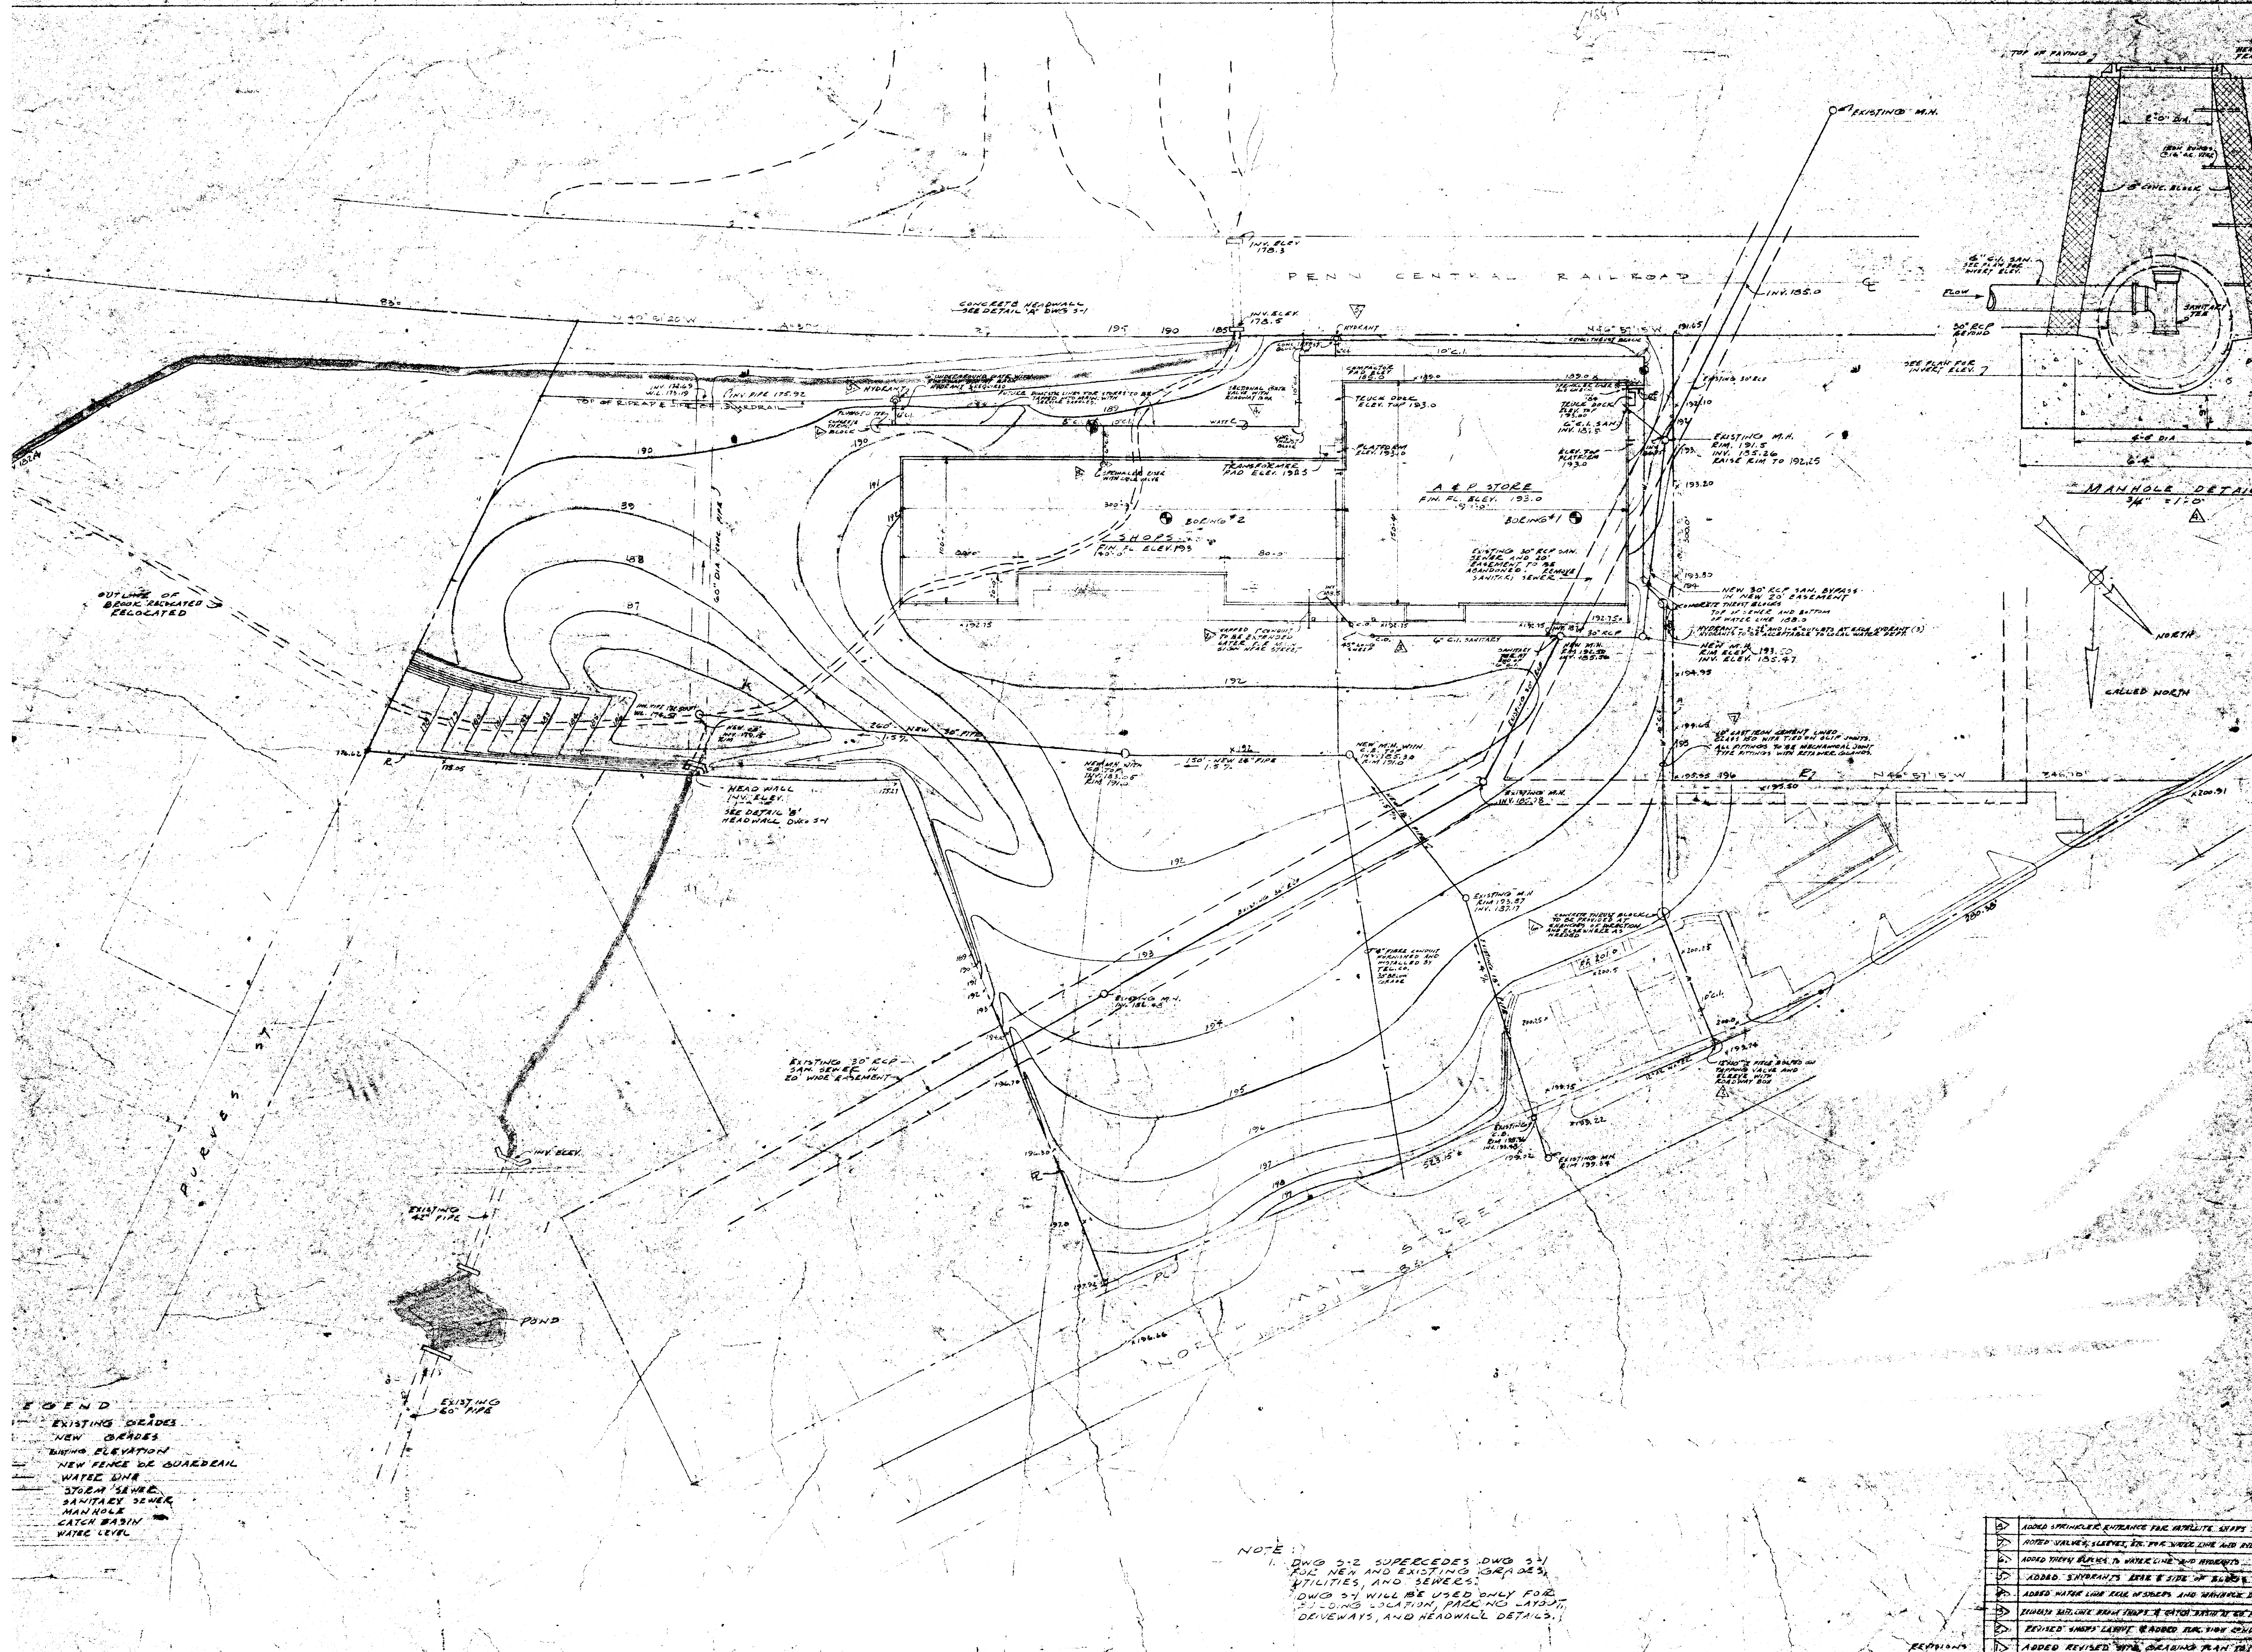


- LEGEND
- EXISTING GRADES
 - NEW GRADES
 - BUILDING ELEVATION
 - NEW FENCE DE GARDEBAIL
 - WATER LINE
 - STORM SEWER
 - SANITARY SEWER
 - MANHOLE
 - CATCH BASIN
 - WATER LEVEL

NOTE
1. DWG 5-2 SUPERCEDES DWG 5-1 FOR NEW AND EXISTING GRADES, UTILITIES, AND SEWERS.
2. DWG 5-1 WILL BE USED ONLY FOR EXISTING LOCATION, PAVING LAYOUT, DRIVEWAYS, AND HEADWALL DETAILS.

- REVISIONS
- | | |
|---|--|
| 1 | ADDED SPRINKLER ENTRANCE FOR UTILITY SHOPS |
| 2 | ADDED VALVE SLEEVES FOR FIRE WATER LINE AND MAIN |
| 3 | ADDED TRUNK RAILWAY TO WATER LINE AND HYDRANTS |
| 4 | ADDED HYDRANTS AND SIDE OF ALLEYS |
| 5 | ADDED WATER LINE FROM WAREHOUSE AND MAINLINE |
| 6 | ADDED WATER LINE FROM TRAP & CATCH BASIN TO MAIN |
| 7 | REVISED WAREHOUSE LAYOUT, ADDED TRUNK RAILWAY |
| 8 | ADDED REVISED SITE, GRADING PLAN |

X GITBERG ASSOCIATES INC.
ARCHITECTS AND ENGINEERS
INNSFIELD MASSACHUSETTS

SHOPPING CENTER
NORTH MAIN STREET
FOR
GASLAND INC.
602 5th E ST. SPRINGFIELD MASS.

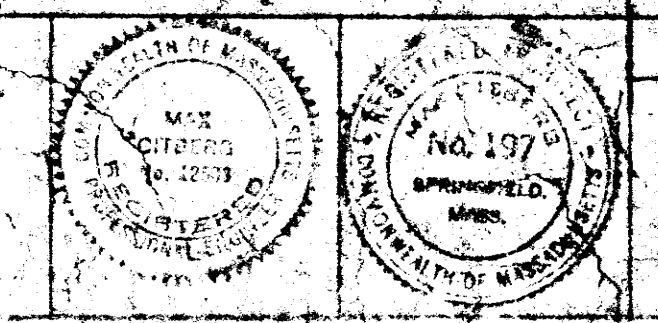

SITE GRADING & UTILITY PLAN
SCALE 1" = 40'-0"
DATE 4-23-73
PROJECT NO. 456

SD 10