



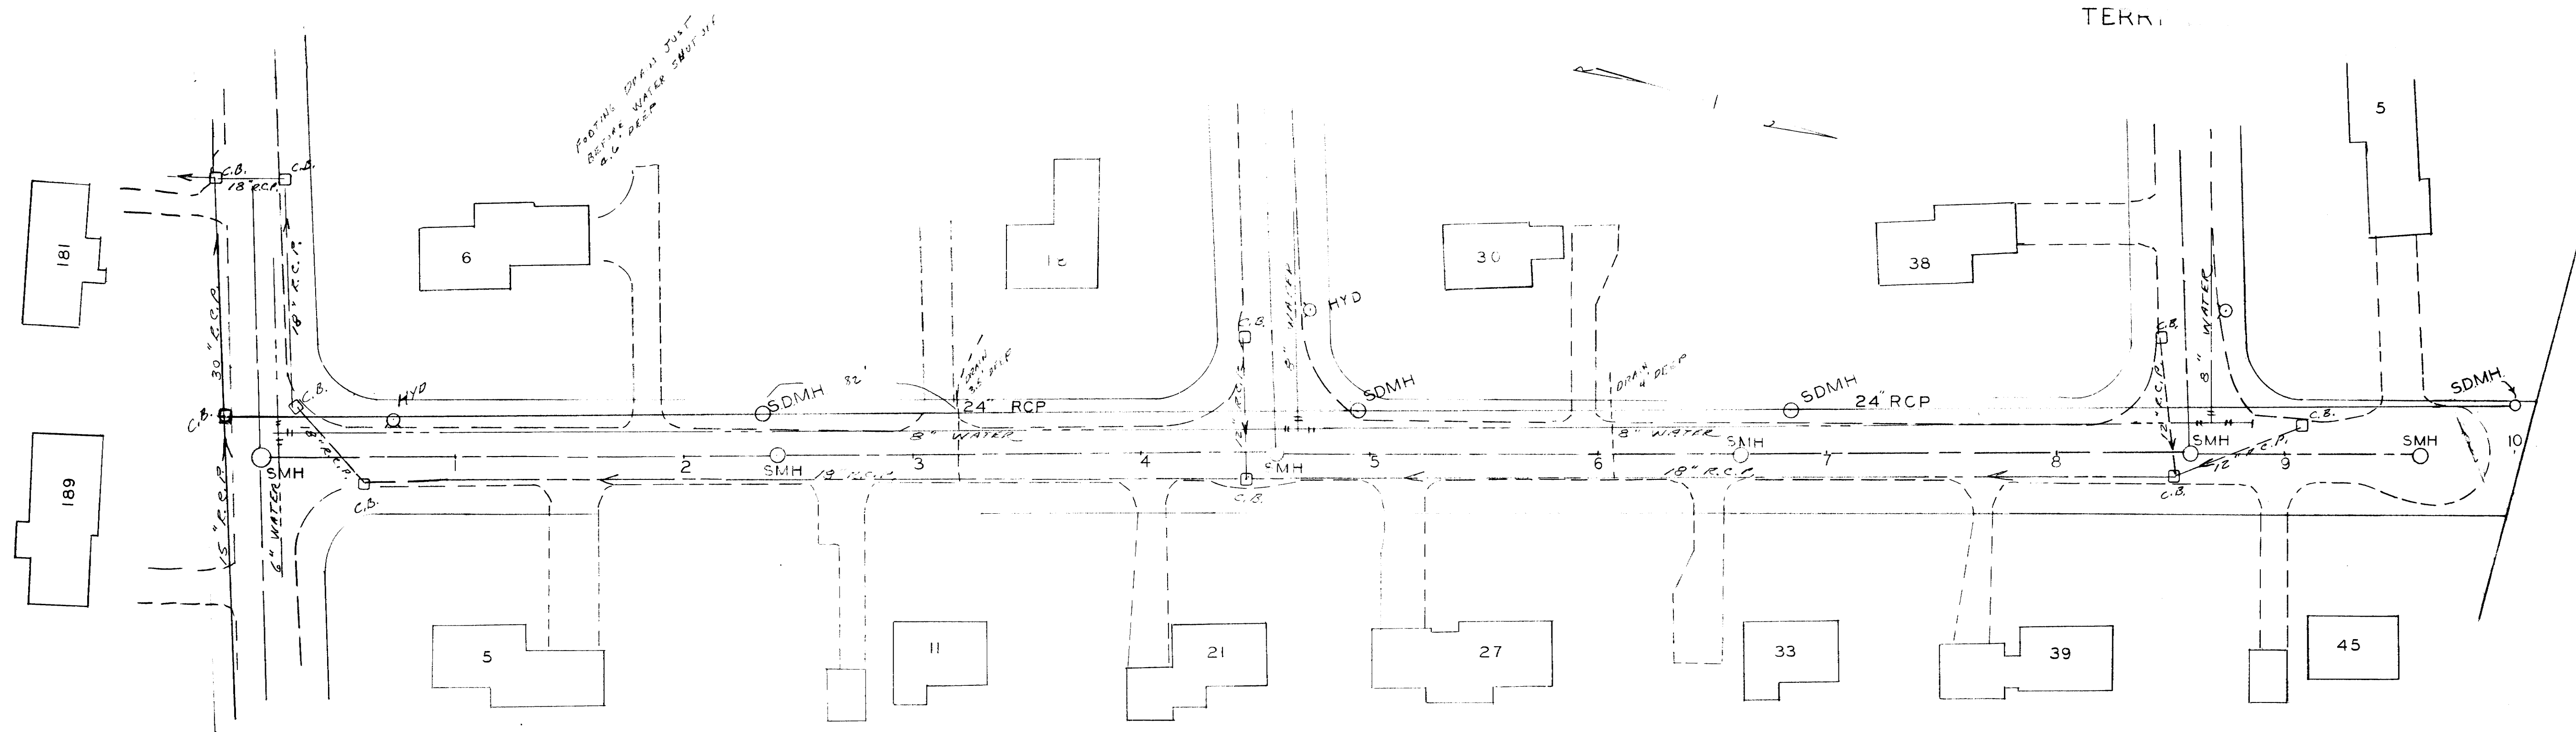

PLAN & PROFILE
CLARESIDE DRIVE
STORM DRAIN
EAST LONGMEADOW MASS
SCALE 1" = 40 FT. HOR. 1984
1" = 4 FT. VERT.
A.A.MELIEN TOWN ENG.

CLARESIDE DRIVE

SHEET 1 OF 2

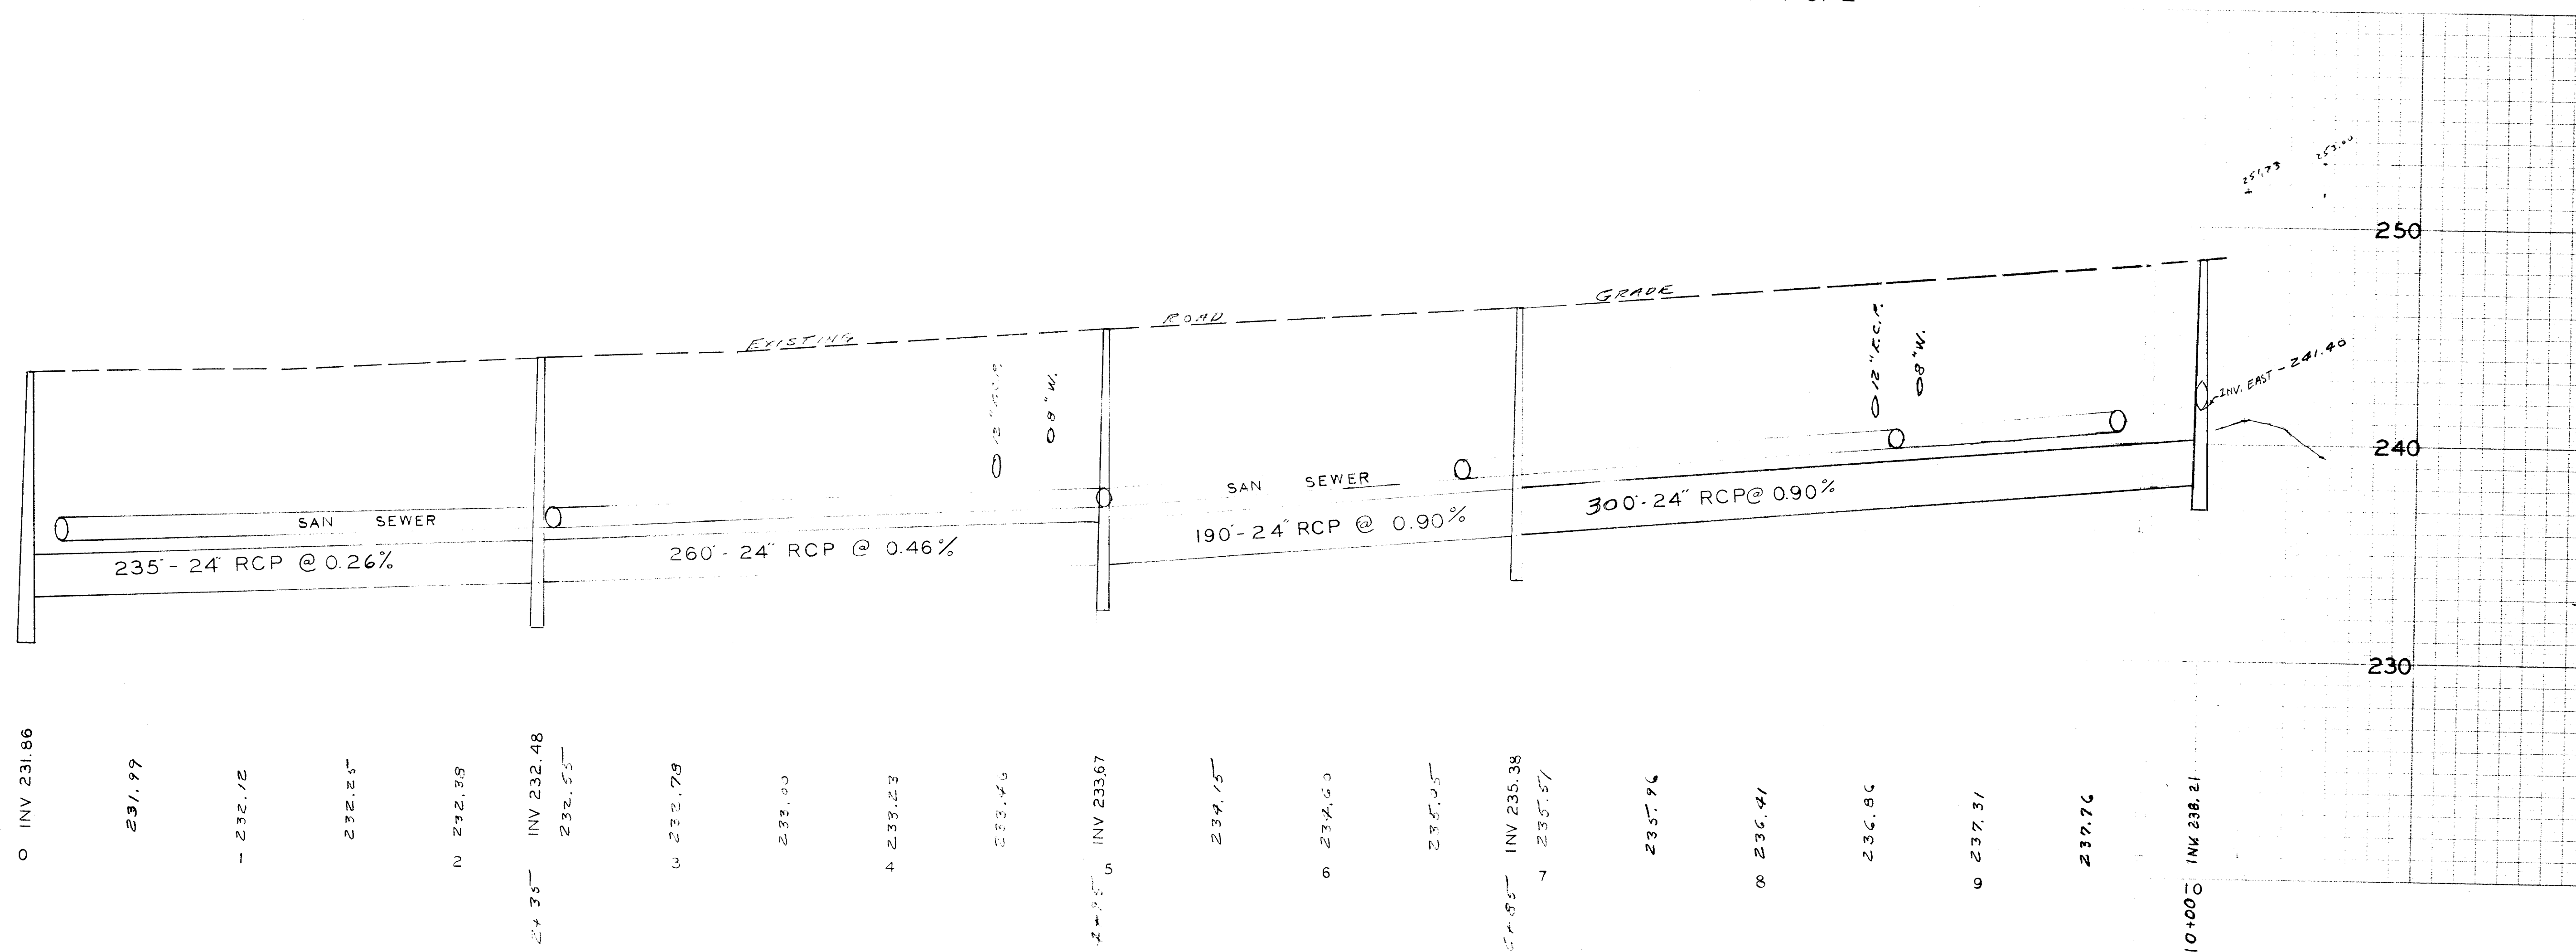

SD-234