



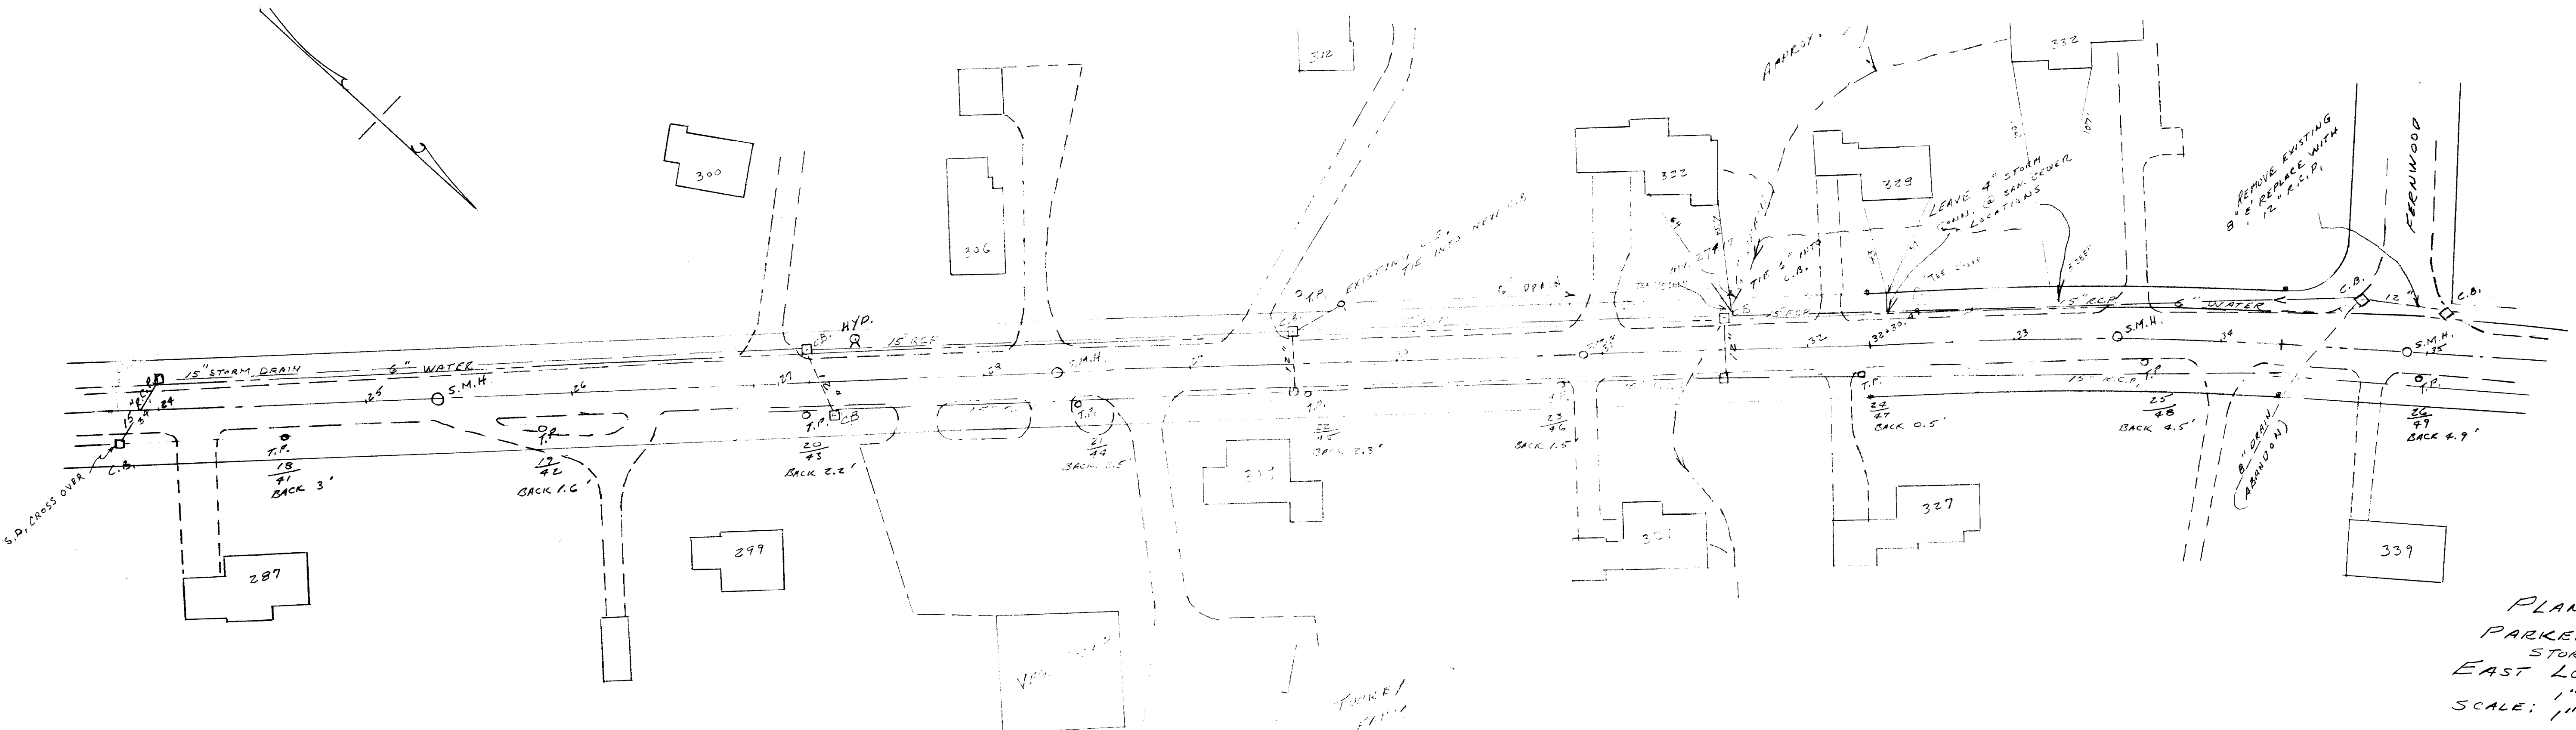

PLAN & PROFILE
 PARKER STREET
 STORM DRAIN
 EAST LONGMEADOW, MASS.
 SCALE: 1" = 40' HOR.
 1" = 4' VERT. 1984
 A. A. MELIEN TOWN ENGR.

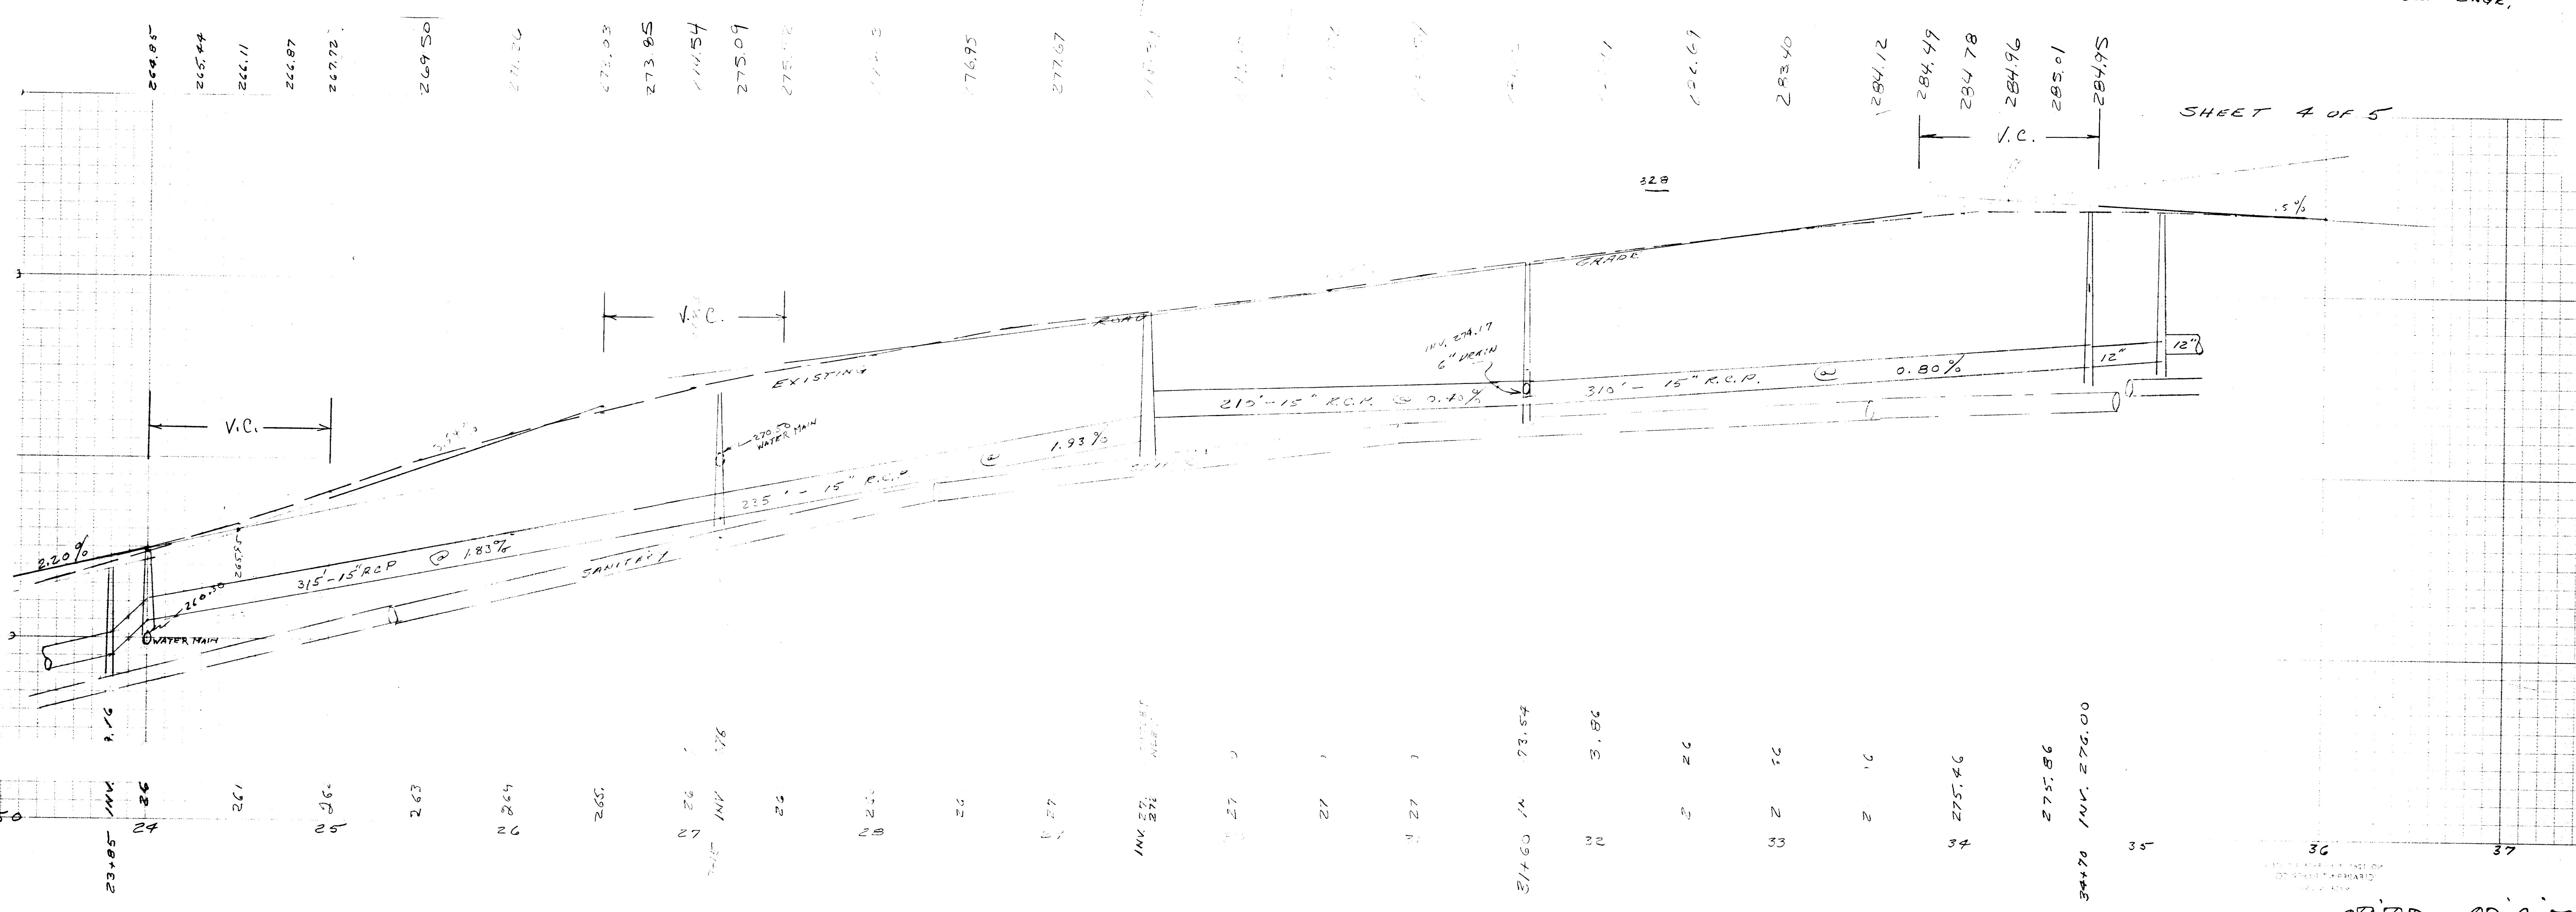

SHEET 4 OF 5

SD-215