


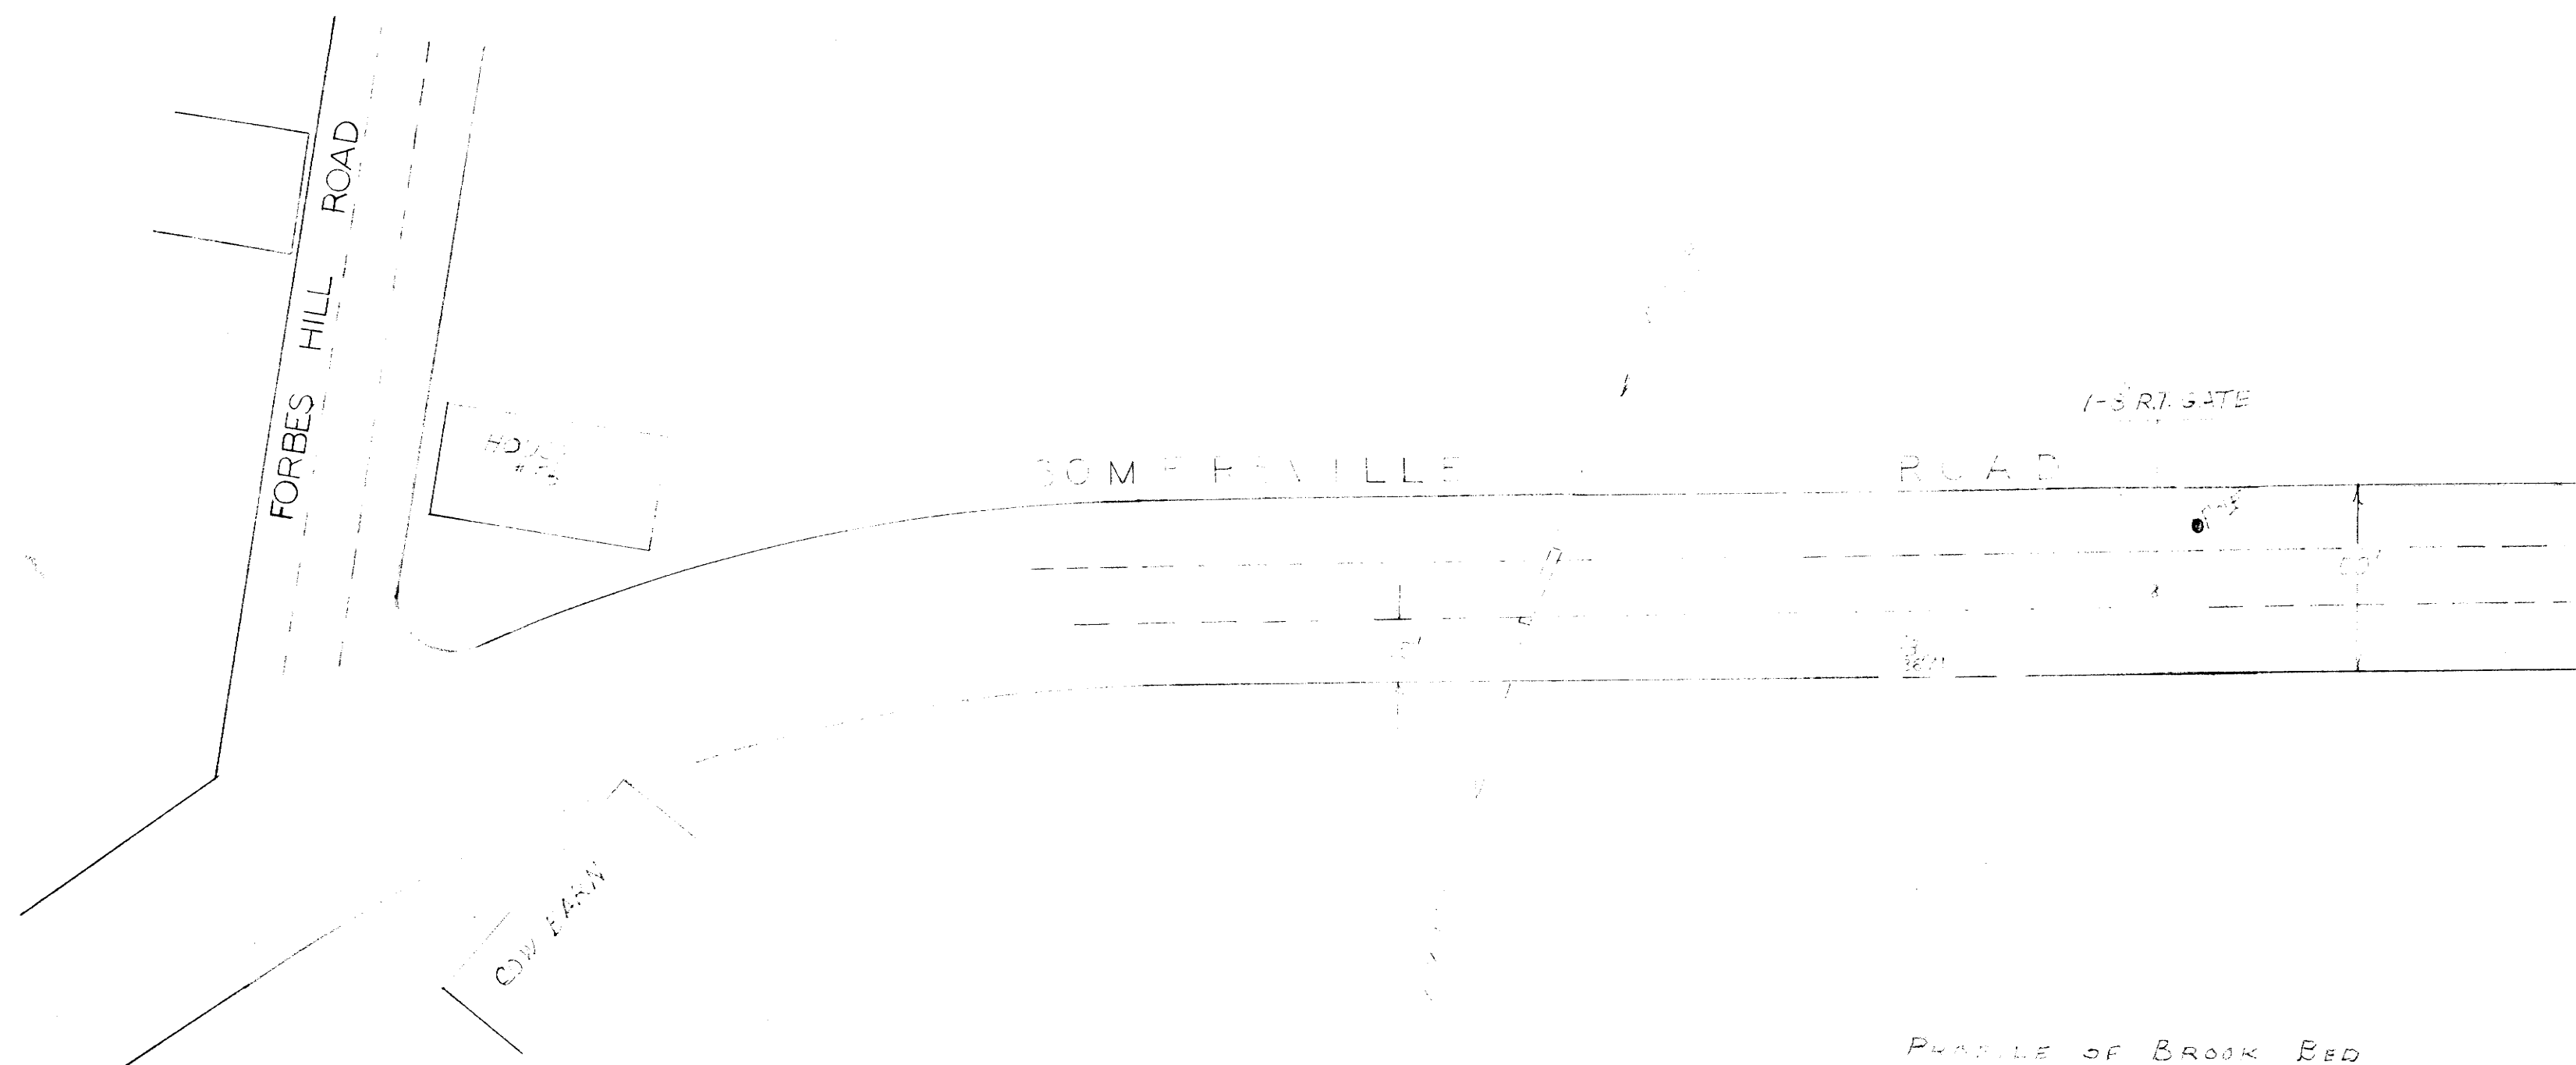

PROFILE OF BROOK BED
 SOMERVILLE ROAD
 EAST LONGMEADOW, MASS.
 SCALE: 1"=40' HORIZ. SEPT. 1984.
 REVISED - JULY 1986

270

SOUTH

NORTH

ROAD SOMERVILLE RD.

INLET INV. ELEV. = 2590'

ROAD ELEV. = 262.6'

24" DIA. CORR. PIPE

OUTLET INV. ELEV. = 2593'

PROFILE 1985

NEW
 CULV.