



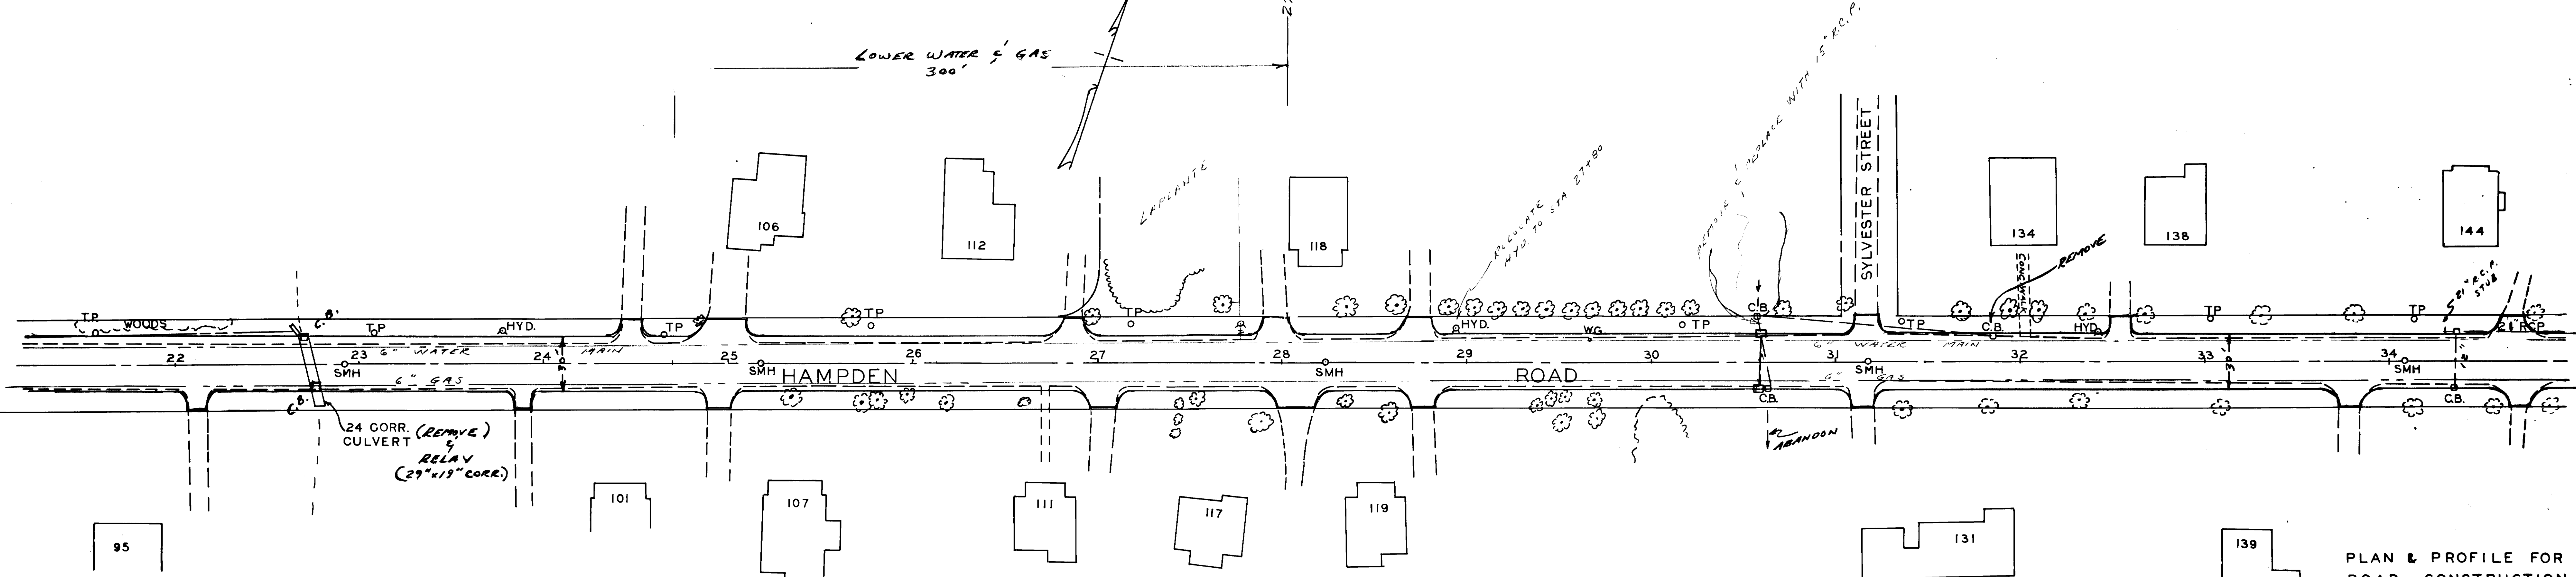

PLAN & PROFILE FOR
 ROAD CONSTRUCTION
 HAMPDEN ROAD
 EAST LONGMEADOW MASS
 SCALE: 1" = 40' HORIZ. FEB. 1985
 1" = 4' VERT.
 A.A. MELIEN TOWN ENG'R.

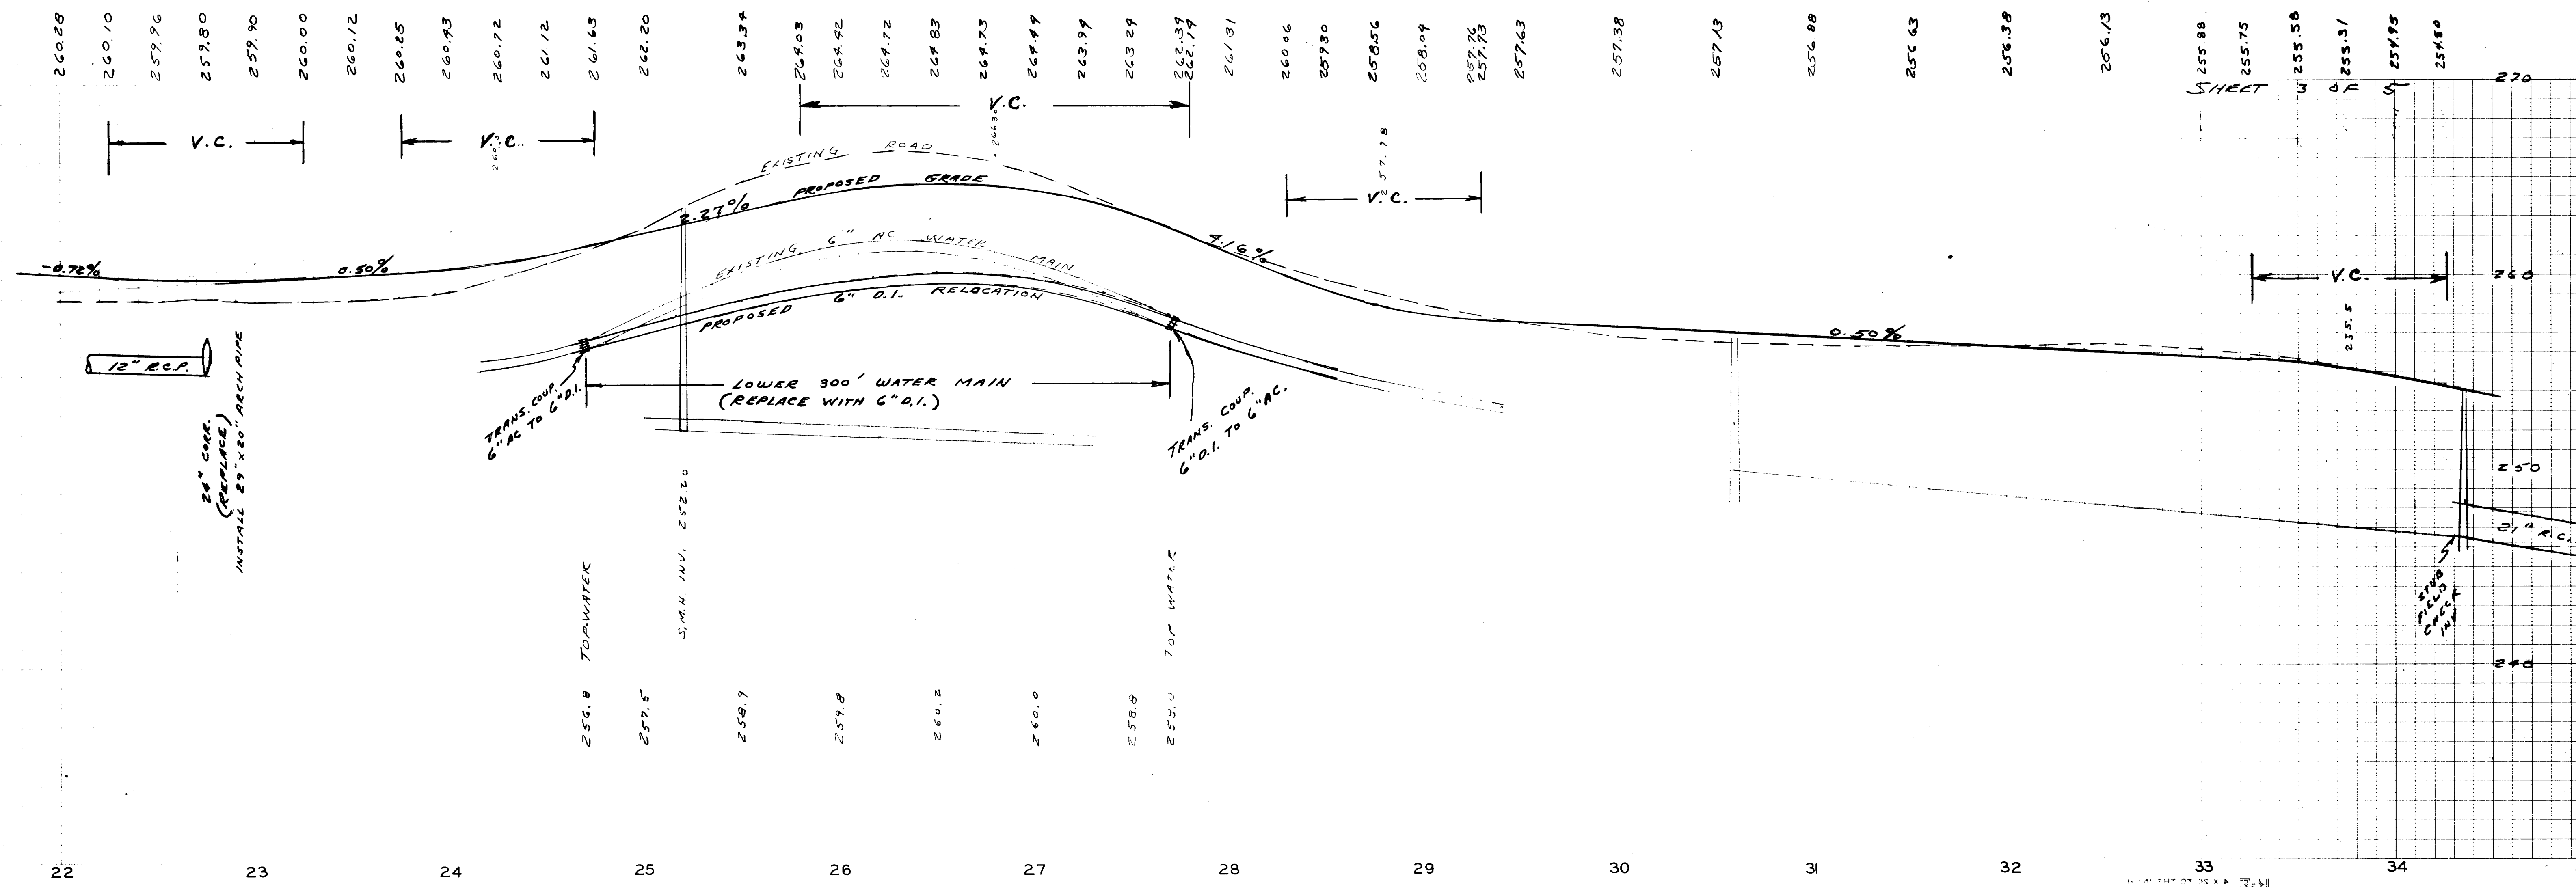

SD 234 C