



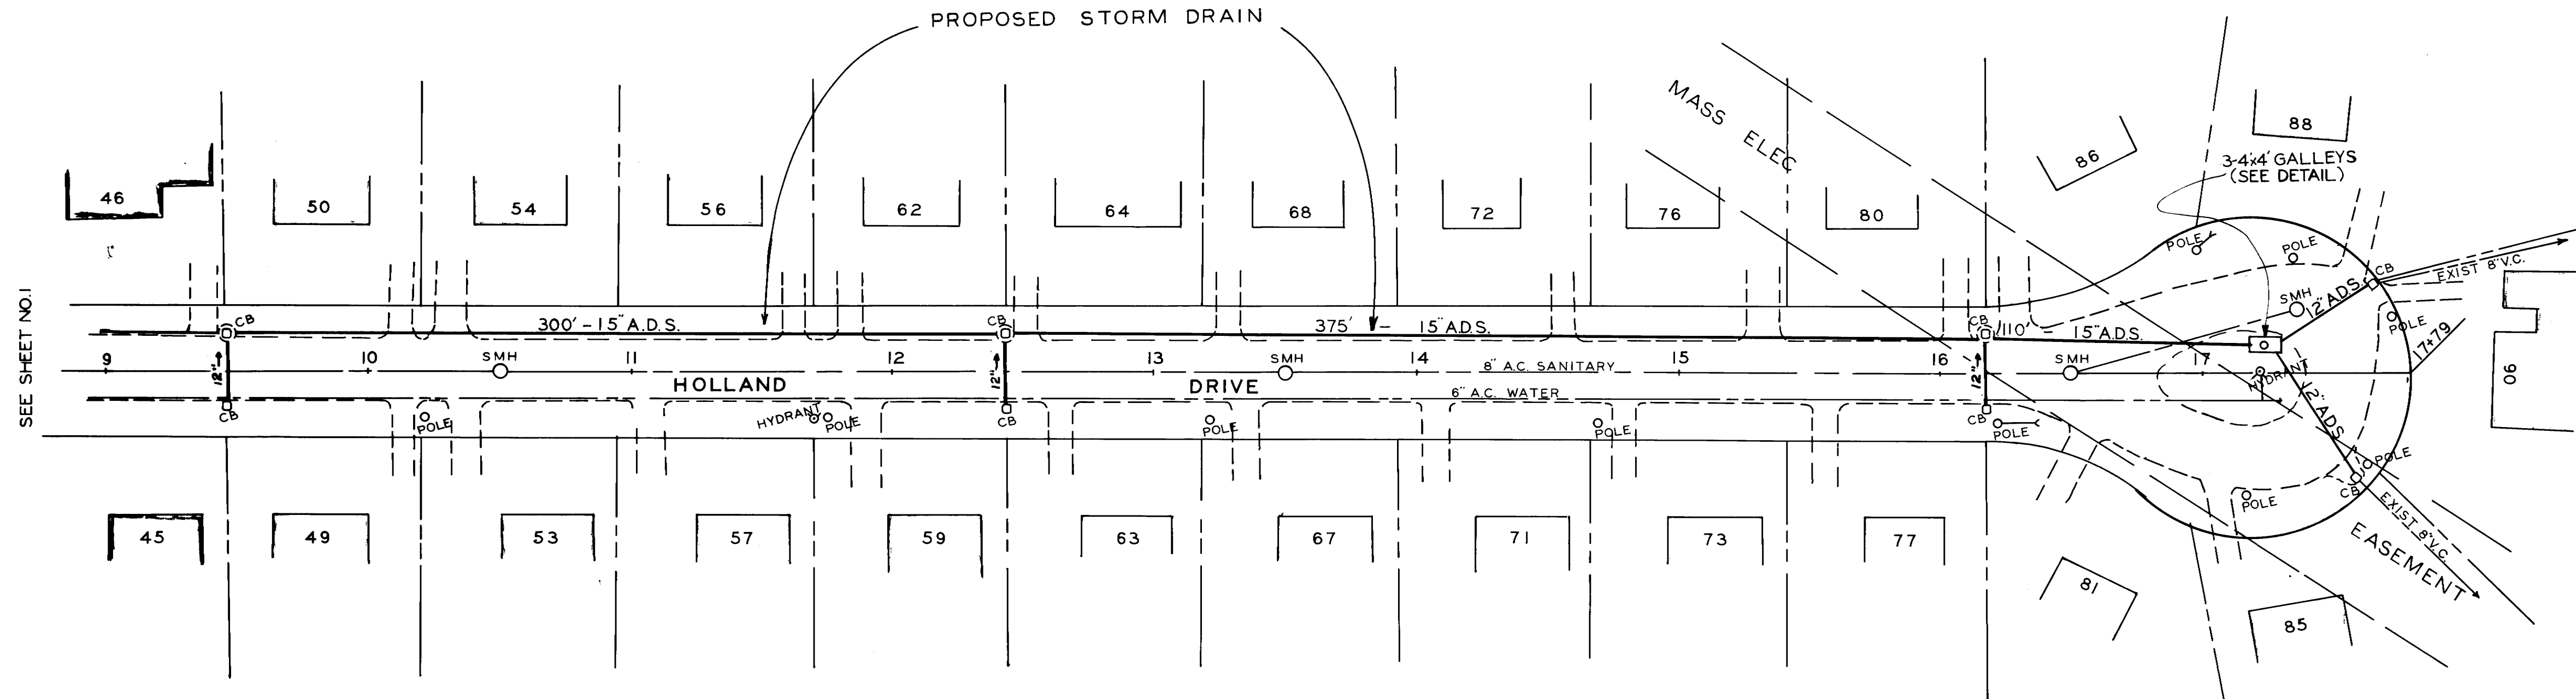


3-4'x4' GALLEYS (NO SCALE)
STA. 17+30 (STONE AROUND GALLEYS)

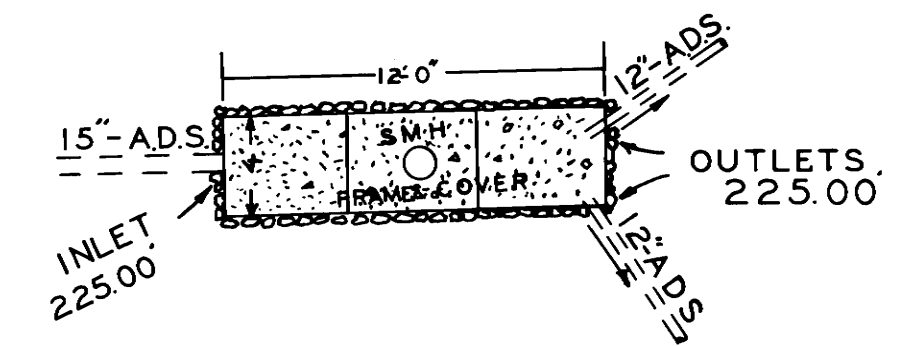


PLAN & PROFILE
HOLLAND DRIVE
STORM DRAIN
EAST LONGMEADOW MA
SCALE 1"=40 FT. HOR.
1"=4 FT. VERT.
TIGHE & BOND, TOWN ENGINEERS
WESTFIELD, MA
DEC., 1988

SHEET 2 OF 2


NOTE: LOCATE ALL WATER & SEWER SERVICES BEFORE EXCAVATION

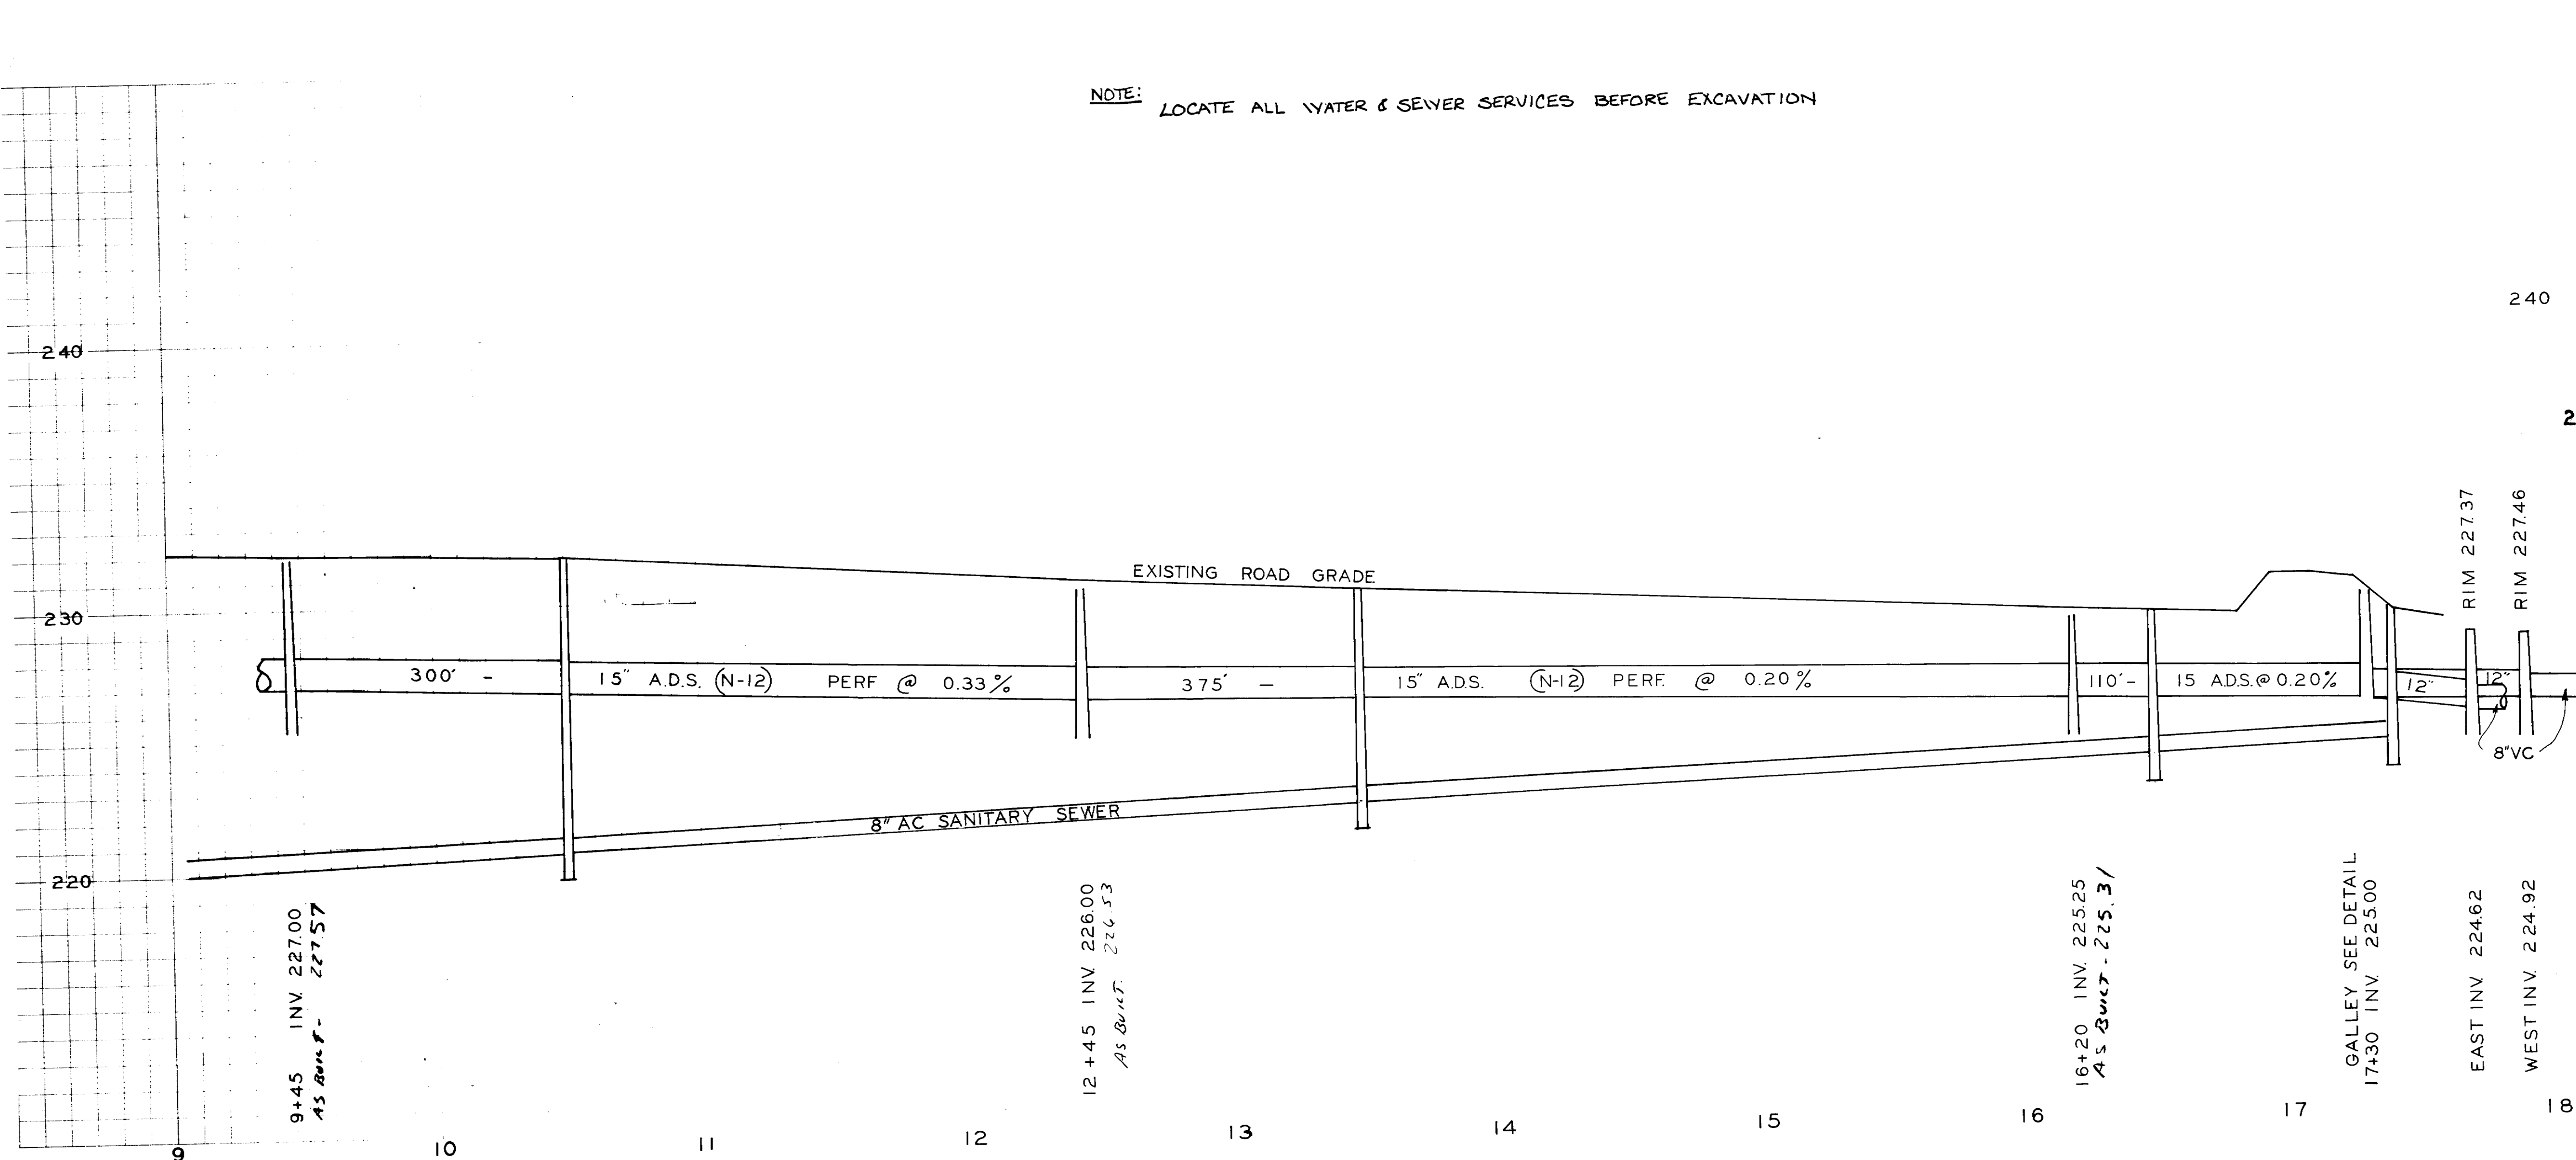

STORM DRAIN GALLEYS
3-4' x 4' GALLEYS WITH CENTER SECTIONS
(2" STONE AROUND GALLEYS)

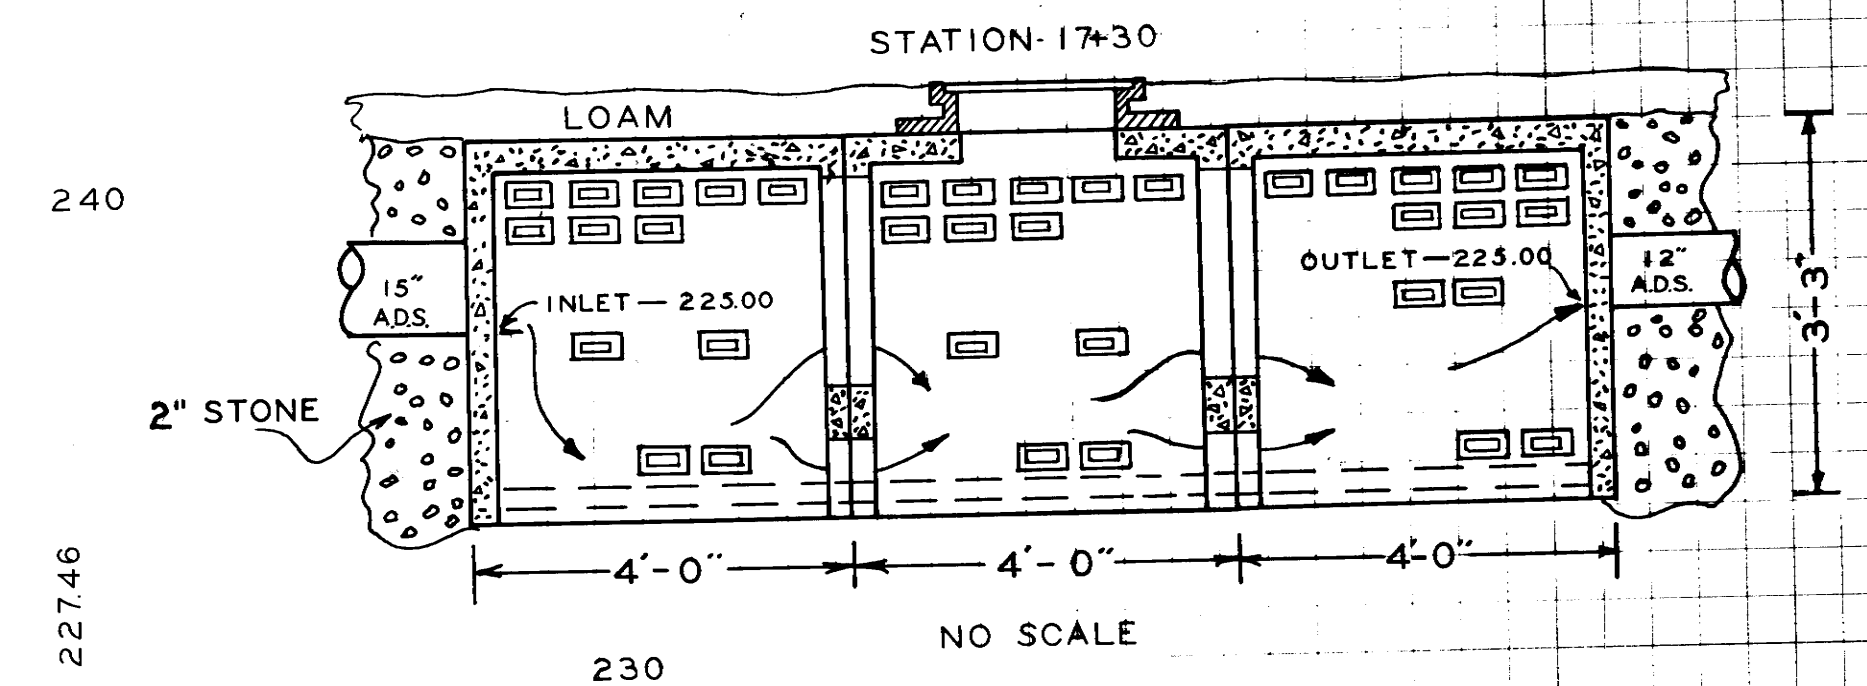

(NO SCALE) CROSS SECTION OF LAID PIPE

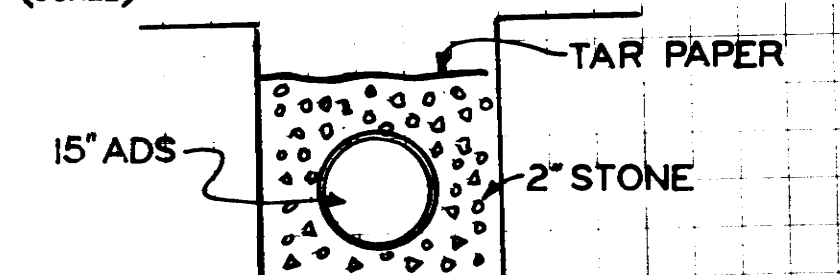

SD-237B