


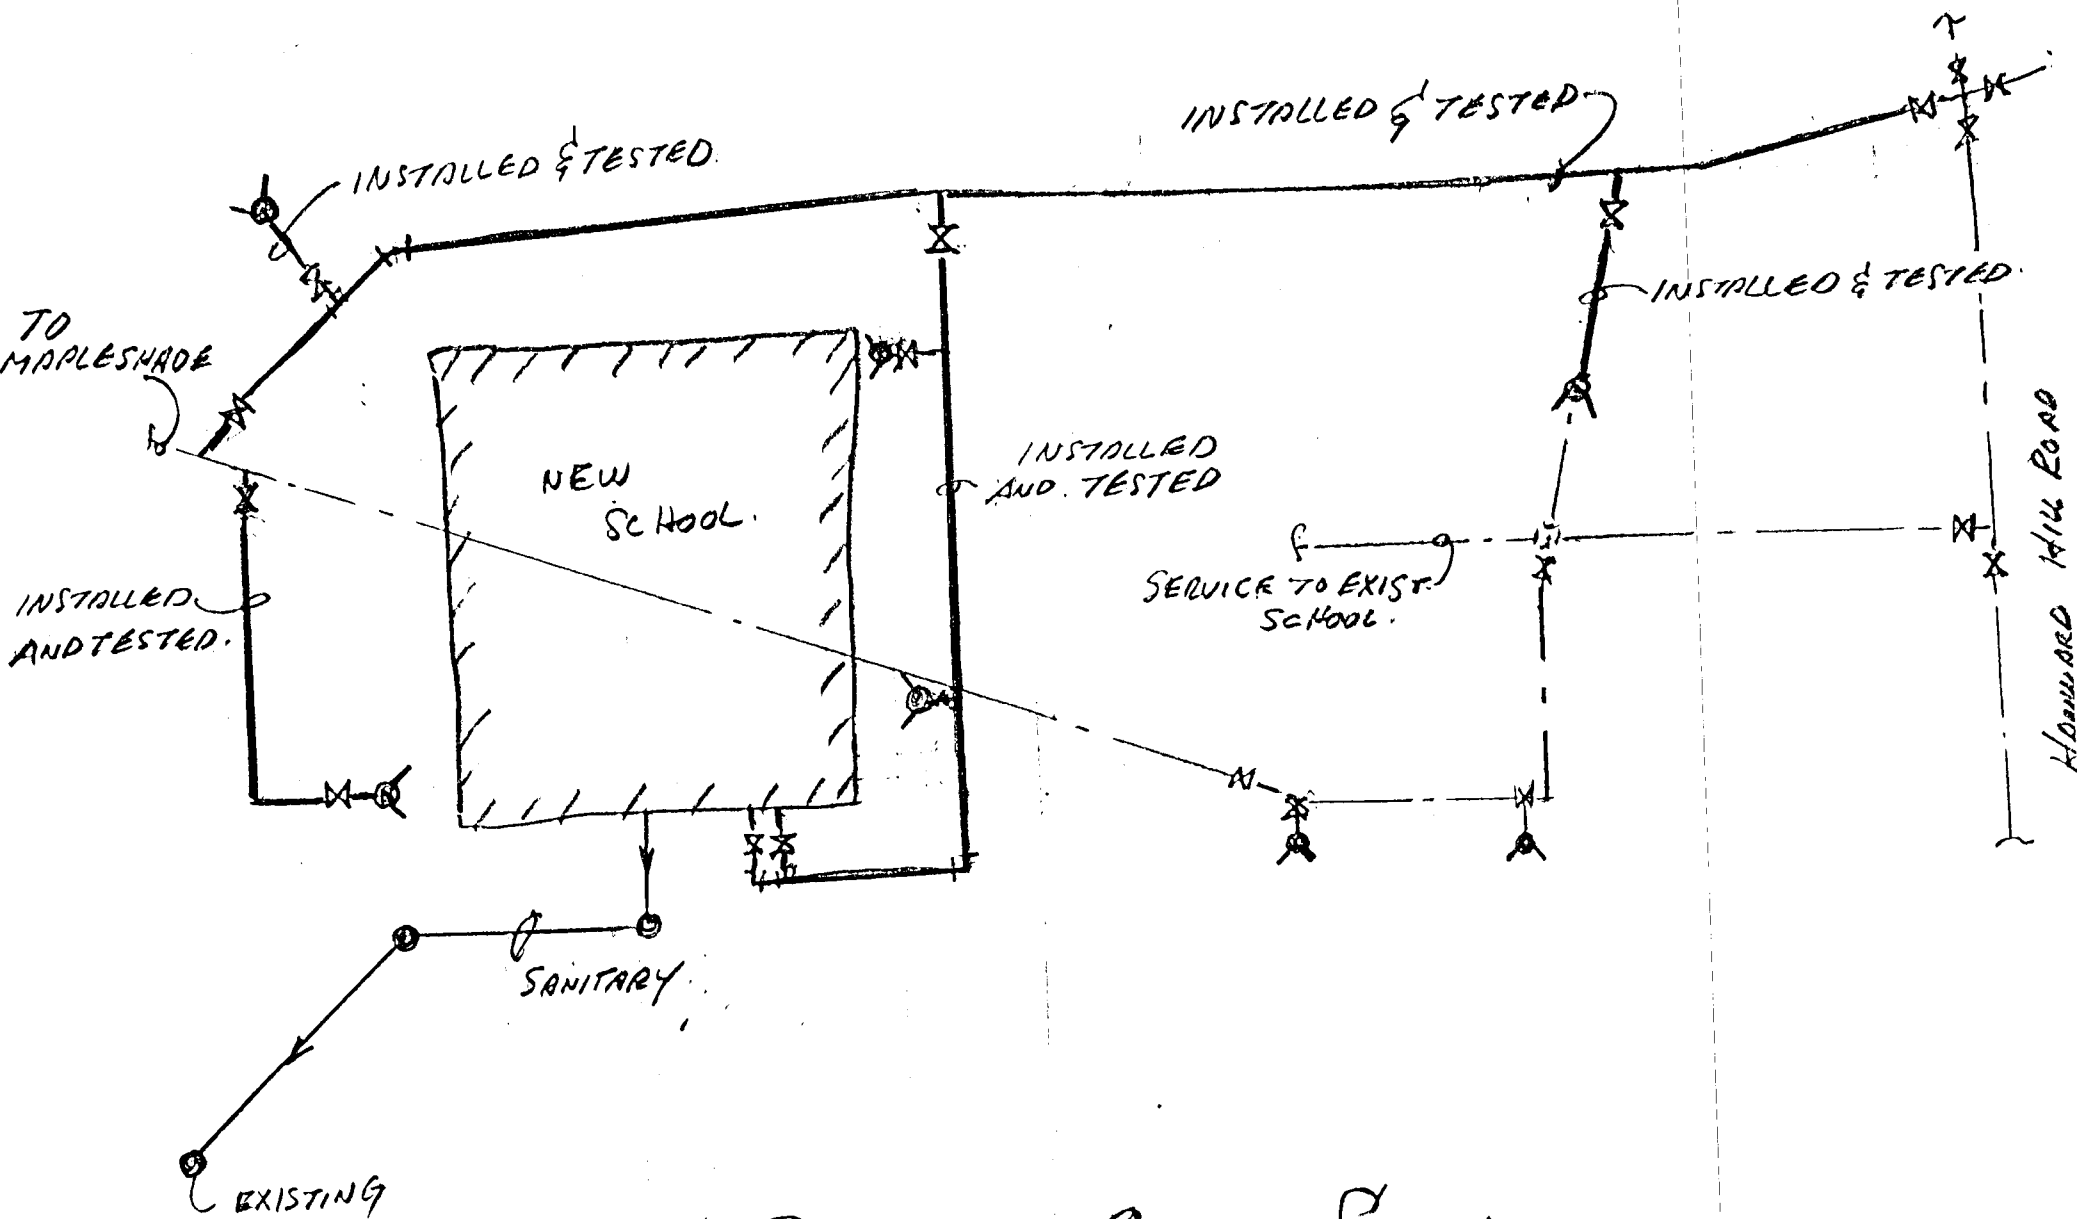

BIRCHLAND PARK SCHOOL

7/10/99