

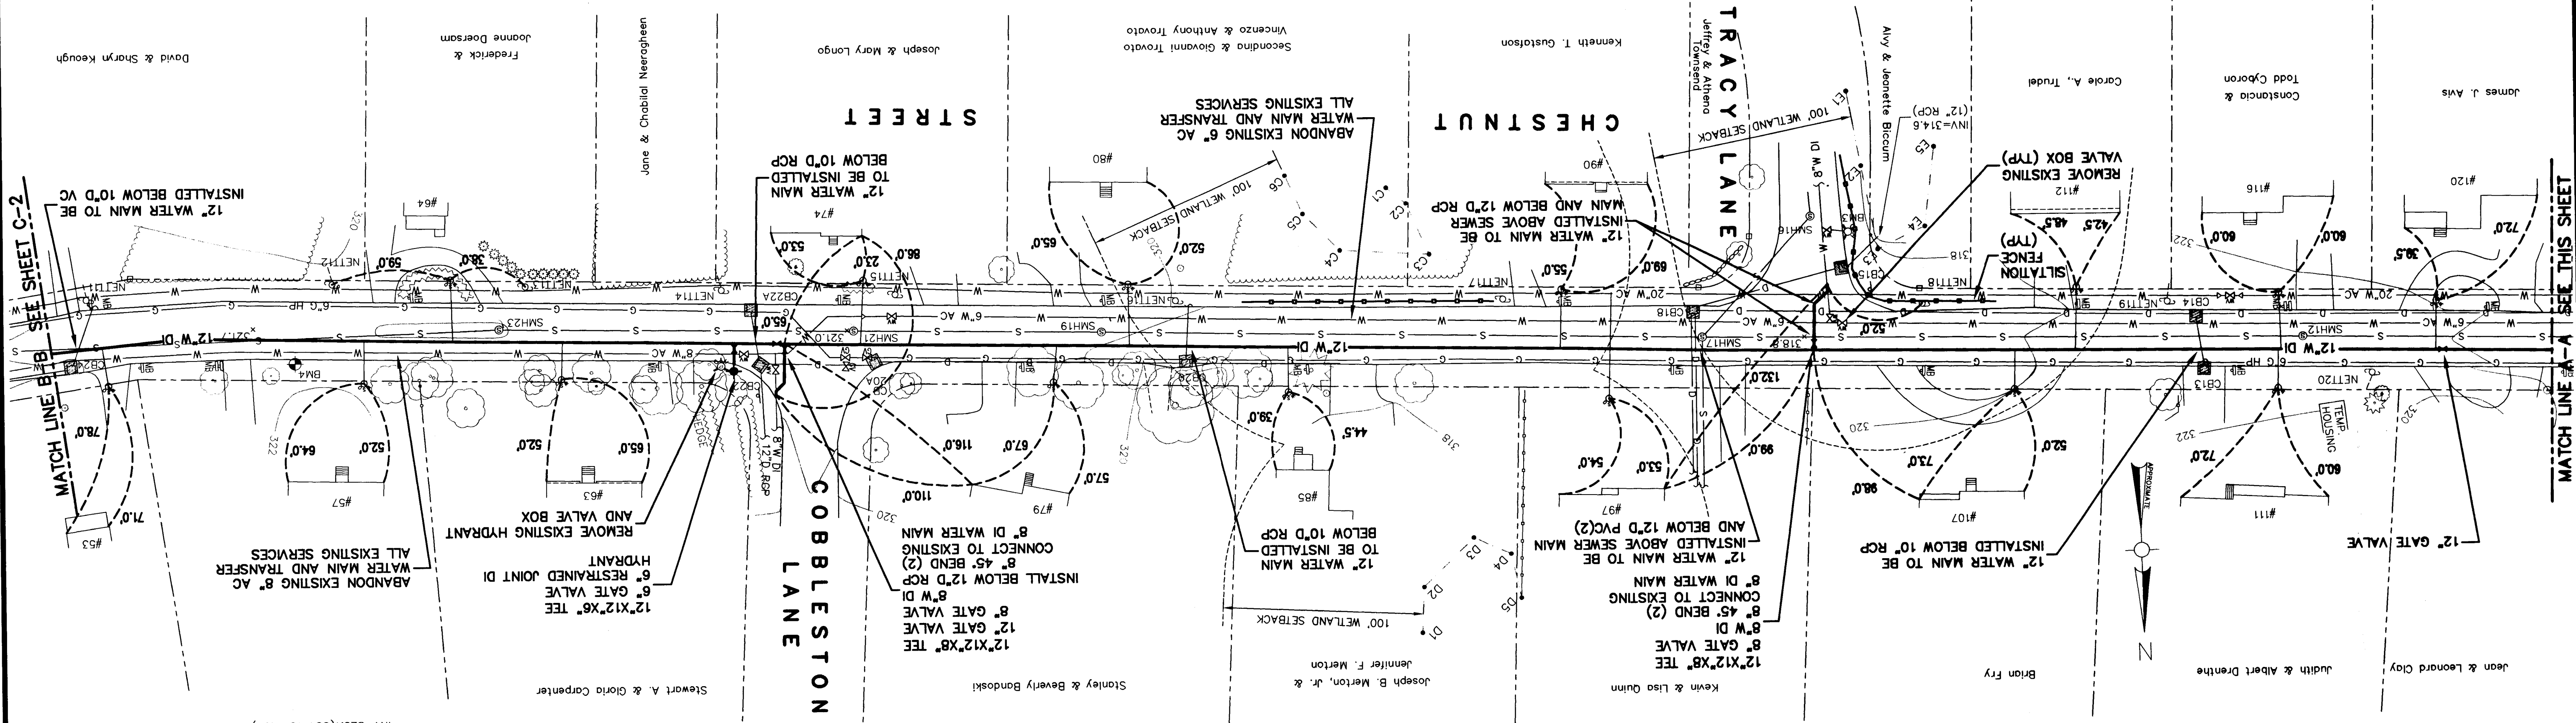
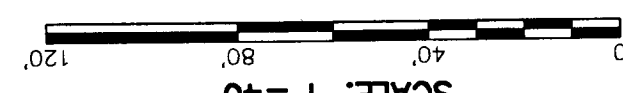


RECORD DRAWING


PLAN
SCALE: 1"=40'

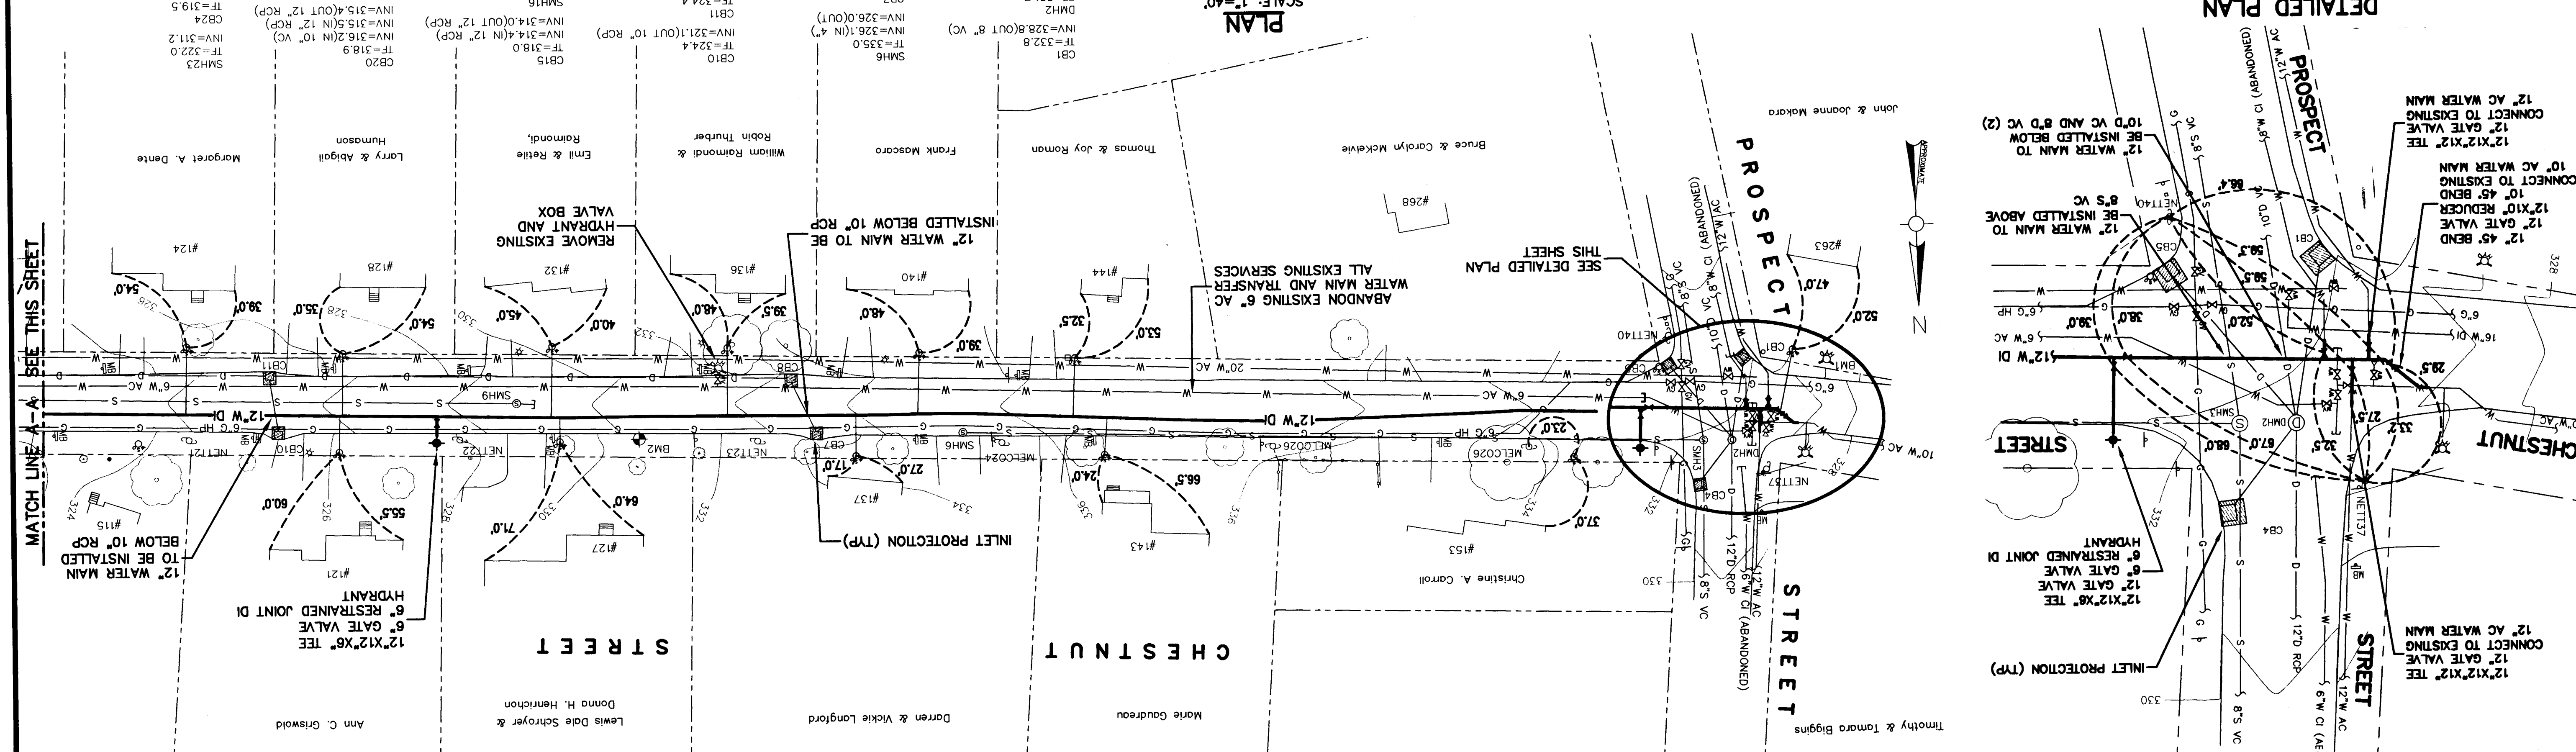

PLAN
SCALE: 1"=40'

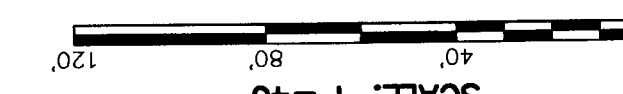

DETAILED PLAN
SCALE: 1"=20'

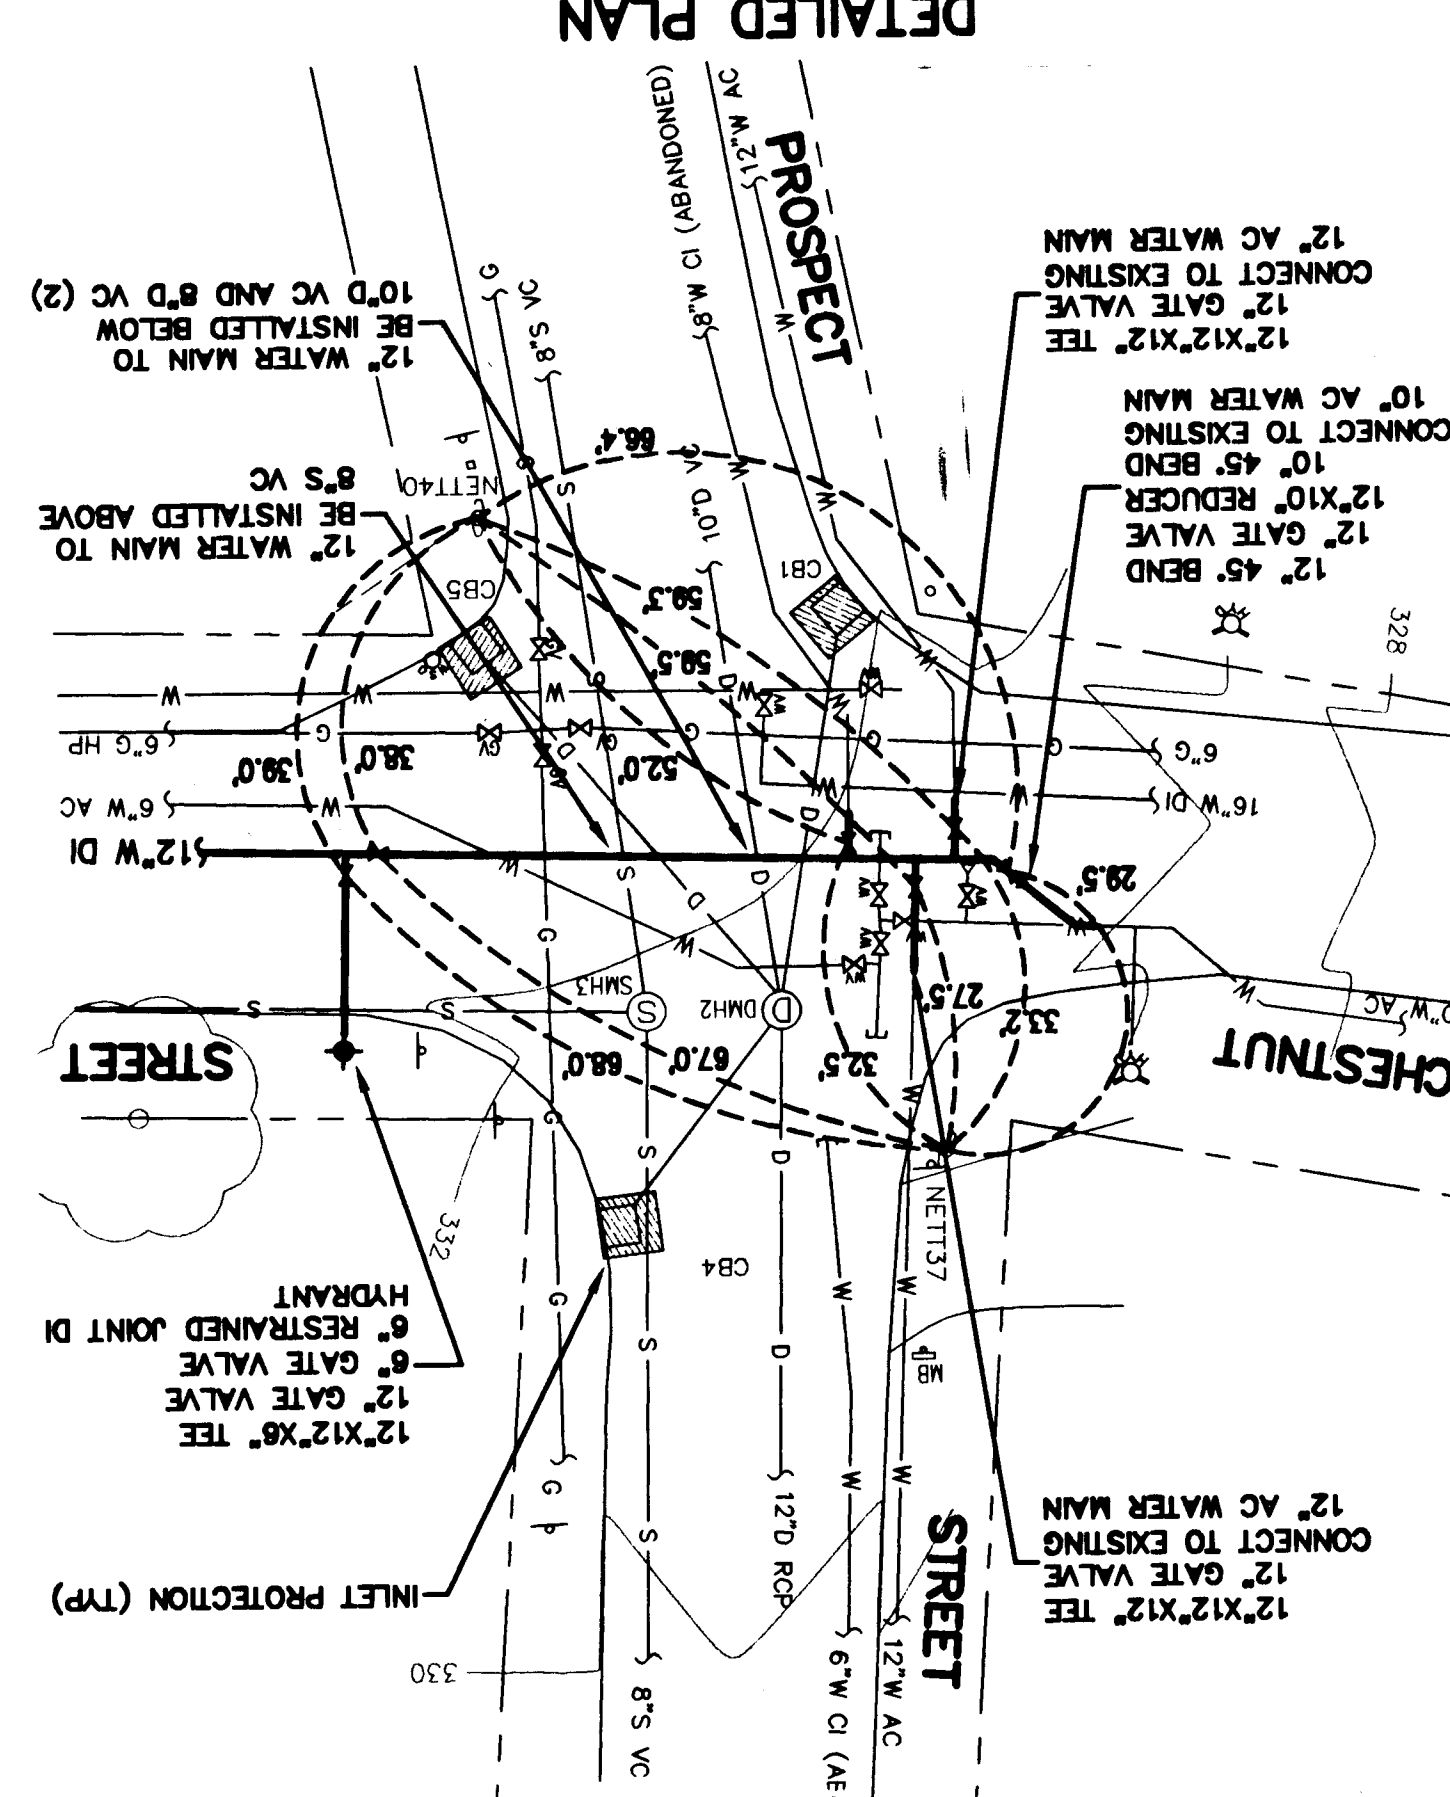

FILE NO. 133-39

CADD NO. CHESTNUT

SCALE: 1"=40'

CONTRACT: 201060

DR BY: WCS

CHK BY: WCS

APP BY: DRL

CHESTNUT STREET STA 0+00 TO 21+60

CHESTNUT STREET AND SOMERS ROAD WATER MAIN IMPROVEMENTS

TOWN OF EAST LONGMEADOW
DEPARTMENT OF PUBLIC WORKS

No.	Date	Dr. By	Ch. By	App. By	Description
1	01/03	WCS	DRL		RECORD DRAWING

REGISTERED PROFESSIONAL ENGINEER

DATE

Weston & Sampson
ENGINEERS, INC.

2929 Main Street, Eastonbury, Connecticut 06033