


EAST LONGMEADOW DEPARTMENT OF PUBLIC WORKS

Job: JOHN ST WATER

Sheet No: END OF MAIN @ MAPLE SHADE

Calculated By: T. LONGO Date 7. 16

Scale: _____

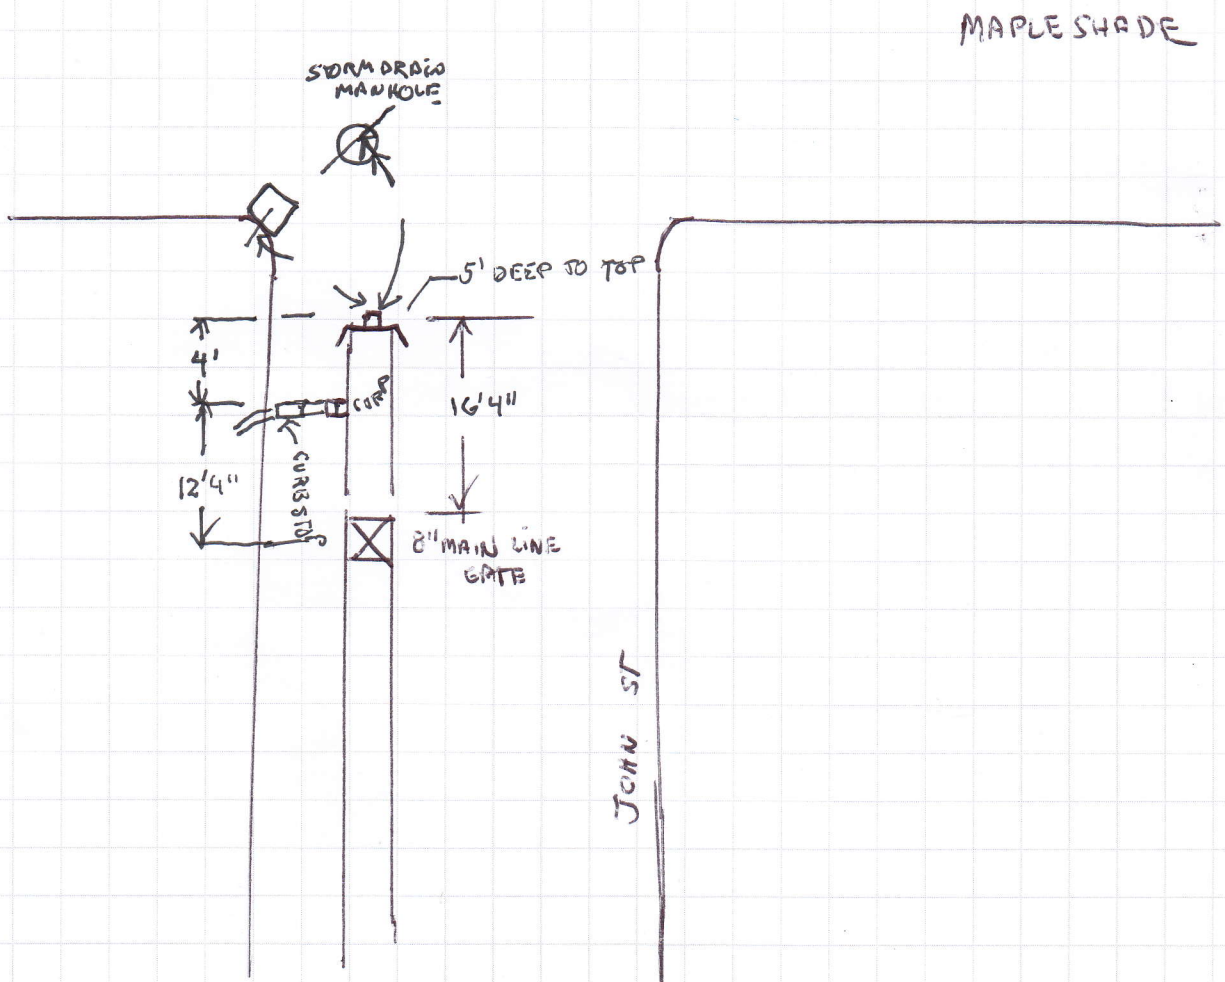




EAST LONGMEADOW DEPARTMENT OF PUBLIC WORKS

Job: JOHN @ ALVIN ST

Sheet No: MAIN LINE of

Calculated By: T. LONGO Date 7.20.16

Scale:

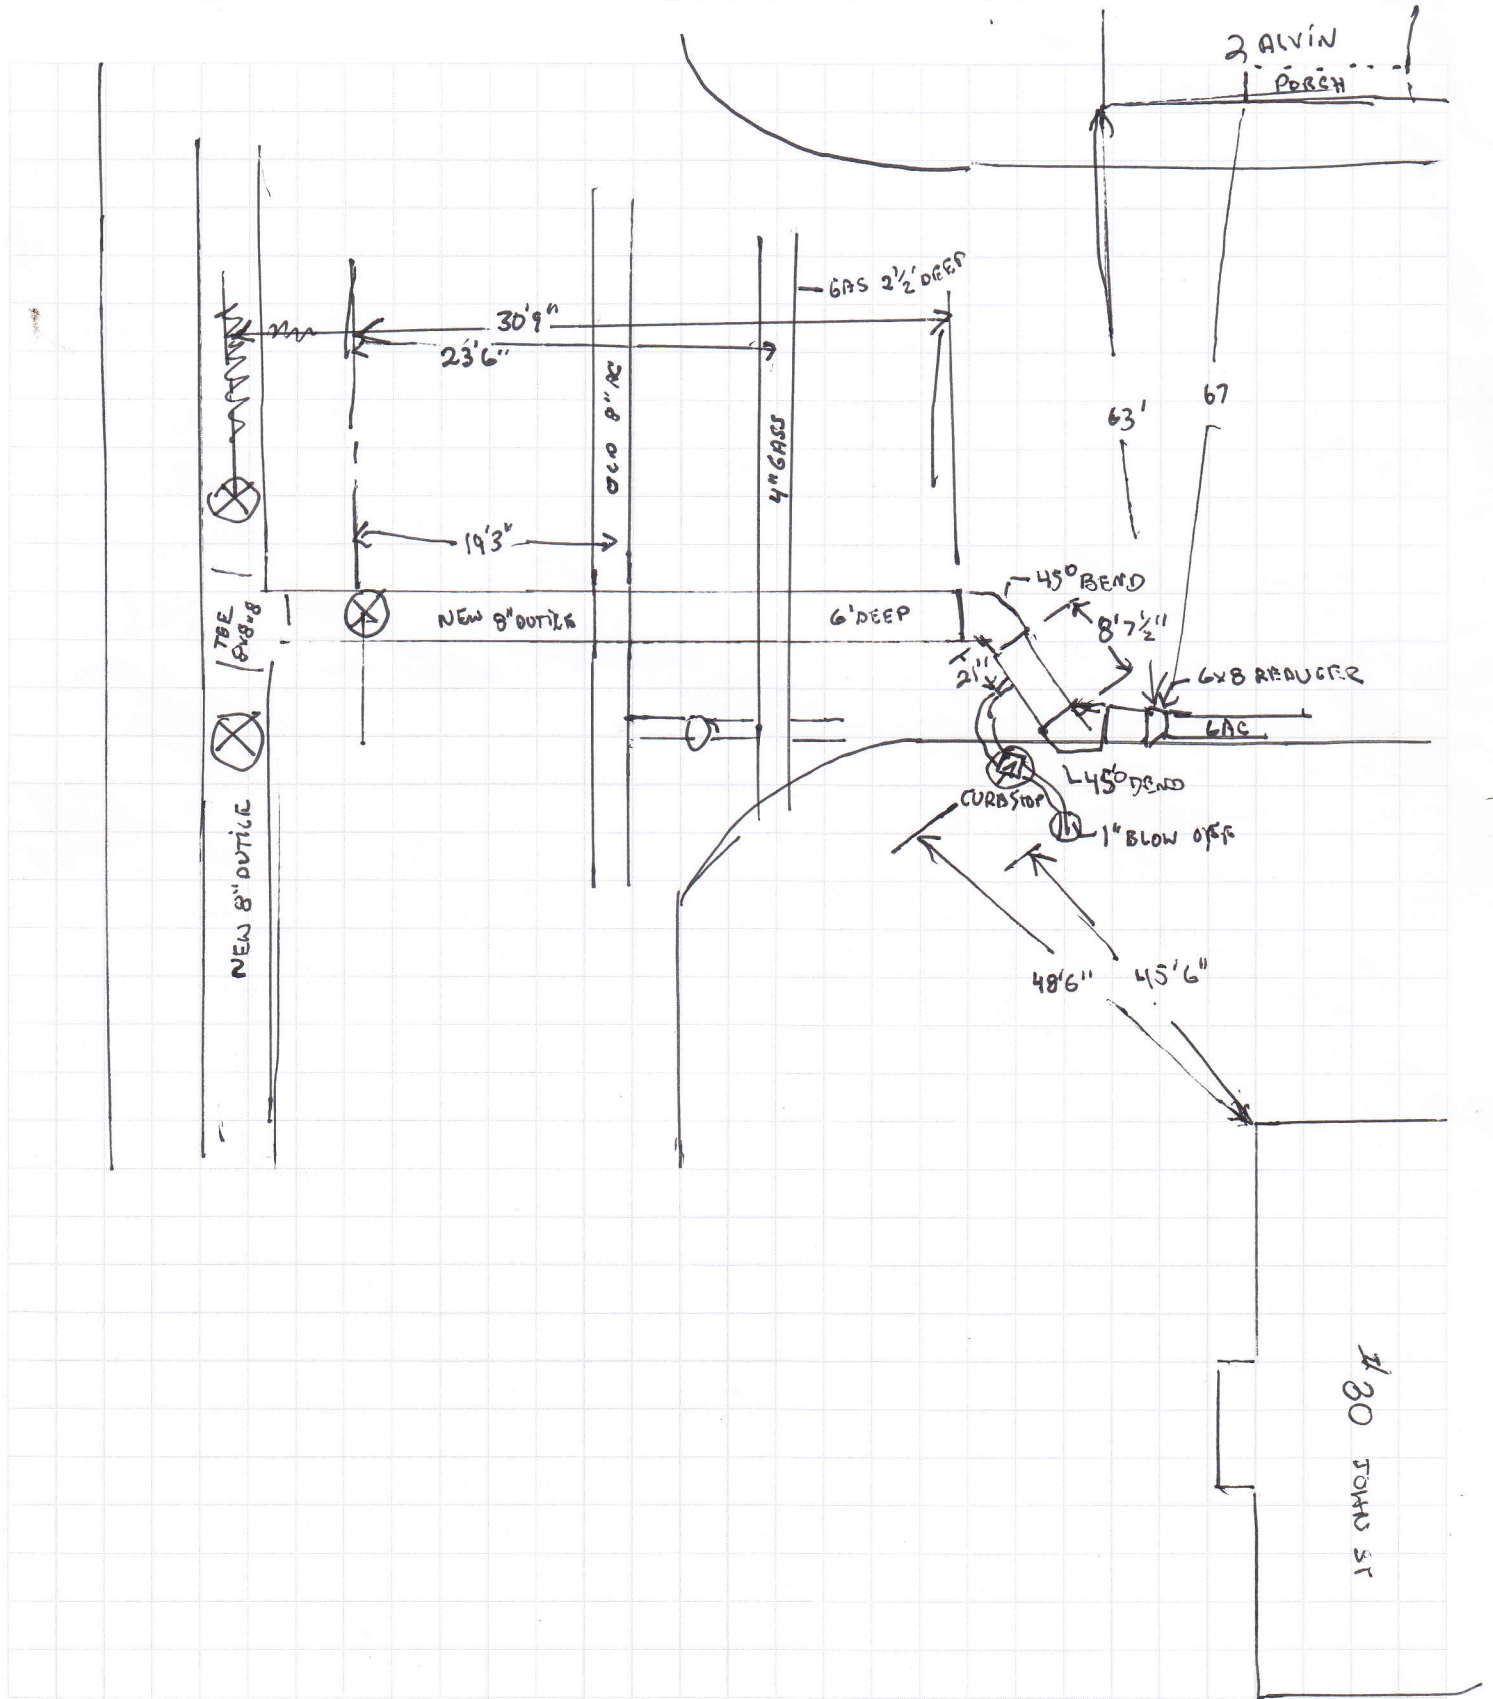




EAST LONGMEADOW DEPARTMENT OF PUBLIC WORKS

Job: JOHN ST @ ALVIN


Sheet No: 8" MAIN LINE ~~THE~~ GATES INTERSECTION

Calculated By: TILONGO Date 7.1.16

Scale: _____

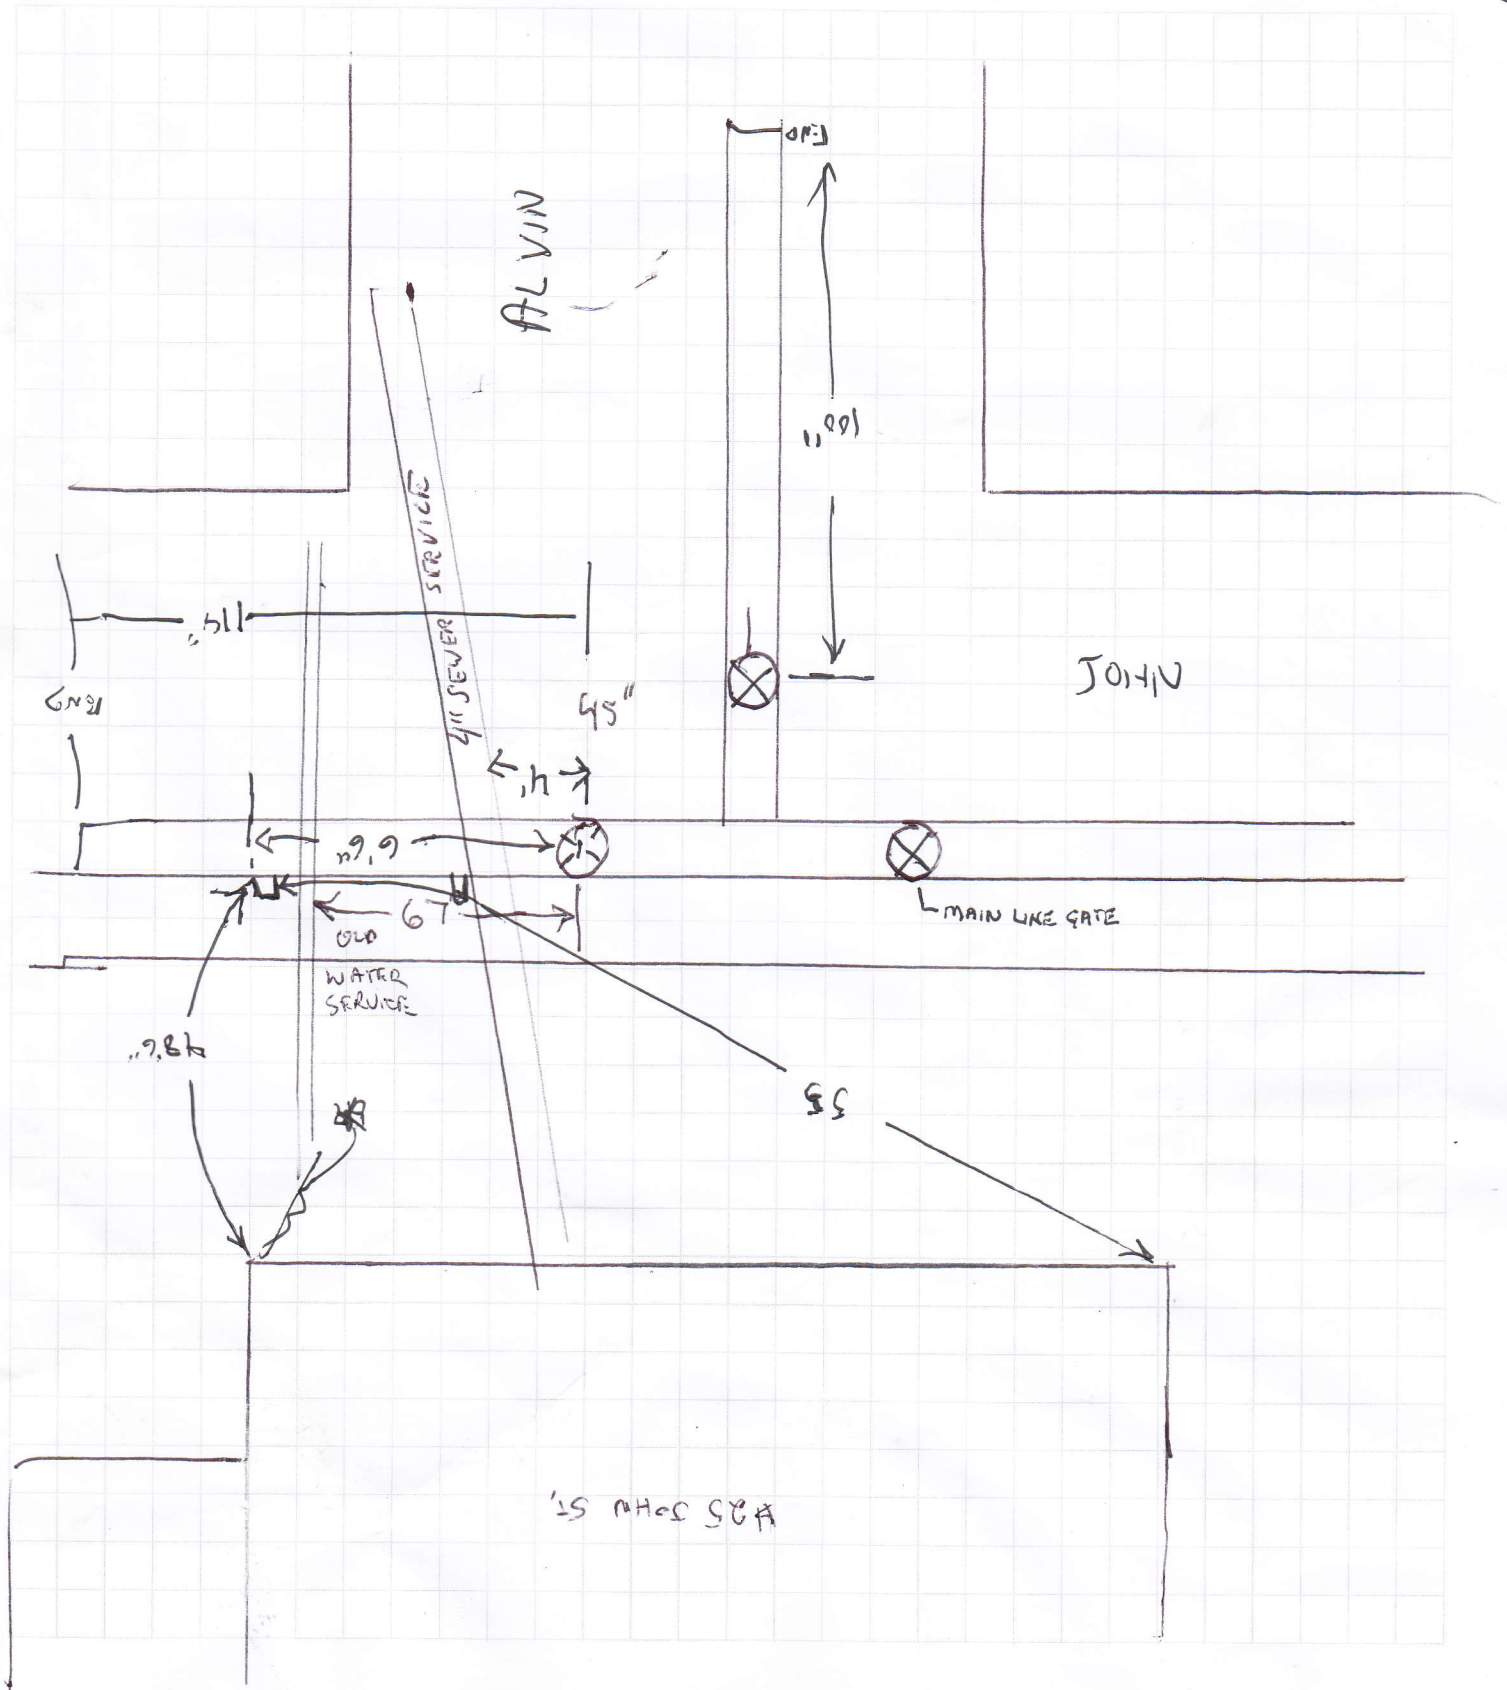



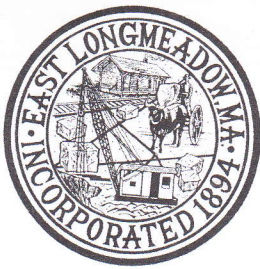

EAST LONGMEADOW DEPARTMENT OF PUBLIC WORKS

Job: JOHN ST @ HELEN CIR

Sheet No: MAIN LINE WATER of

Calculated By: (SOUTH) TILLOCO Date

Scale:

