
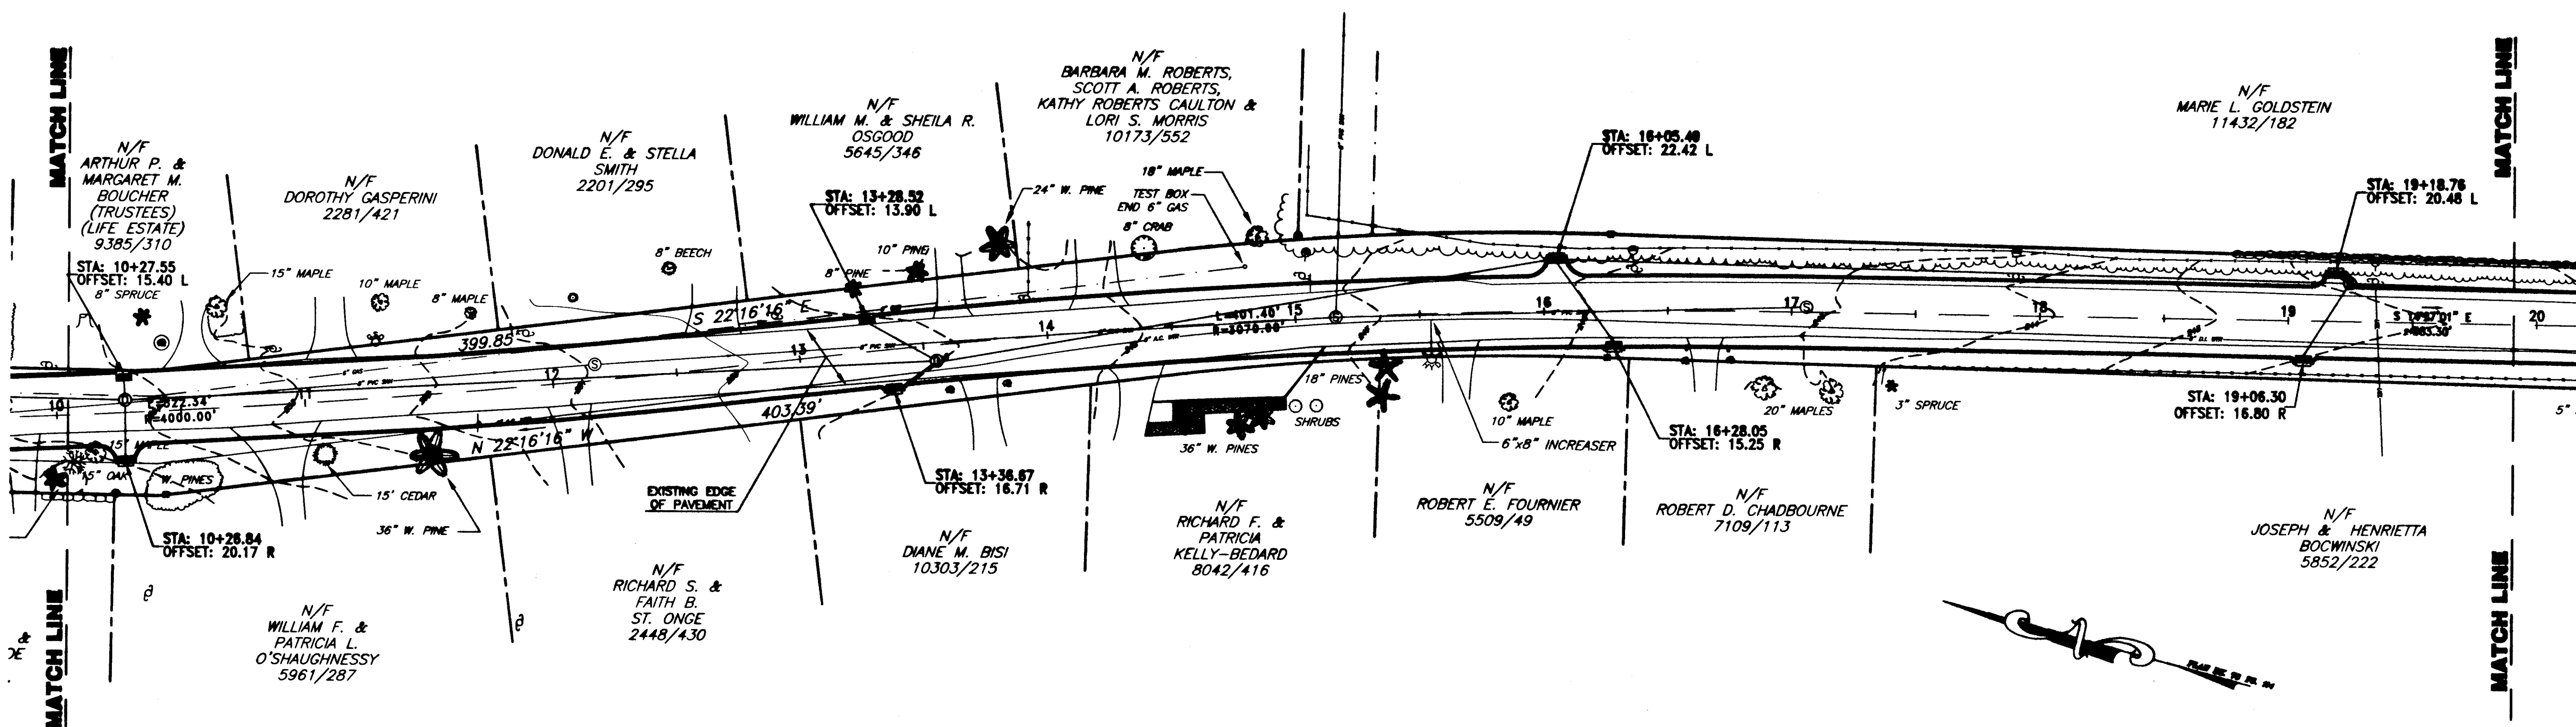


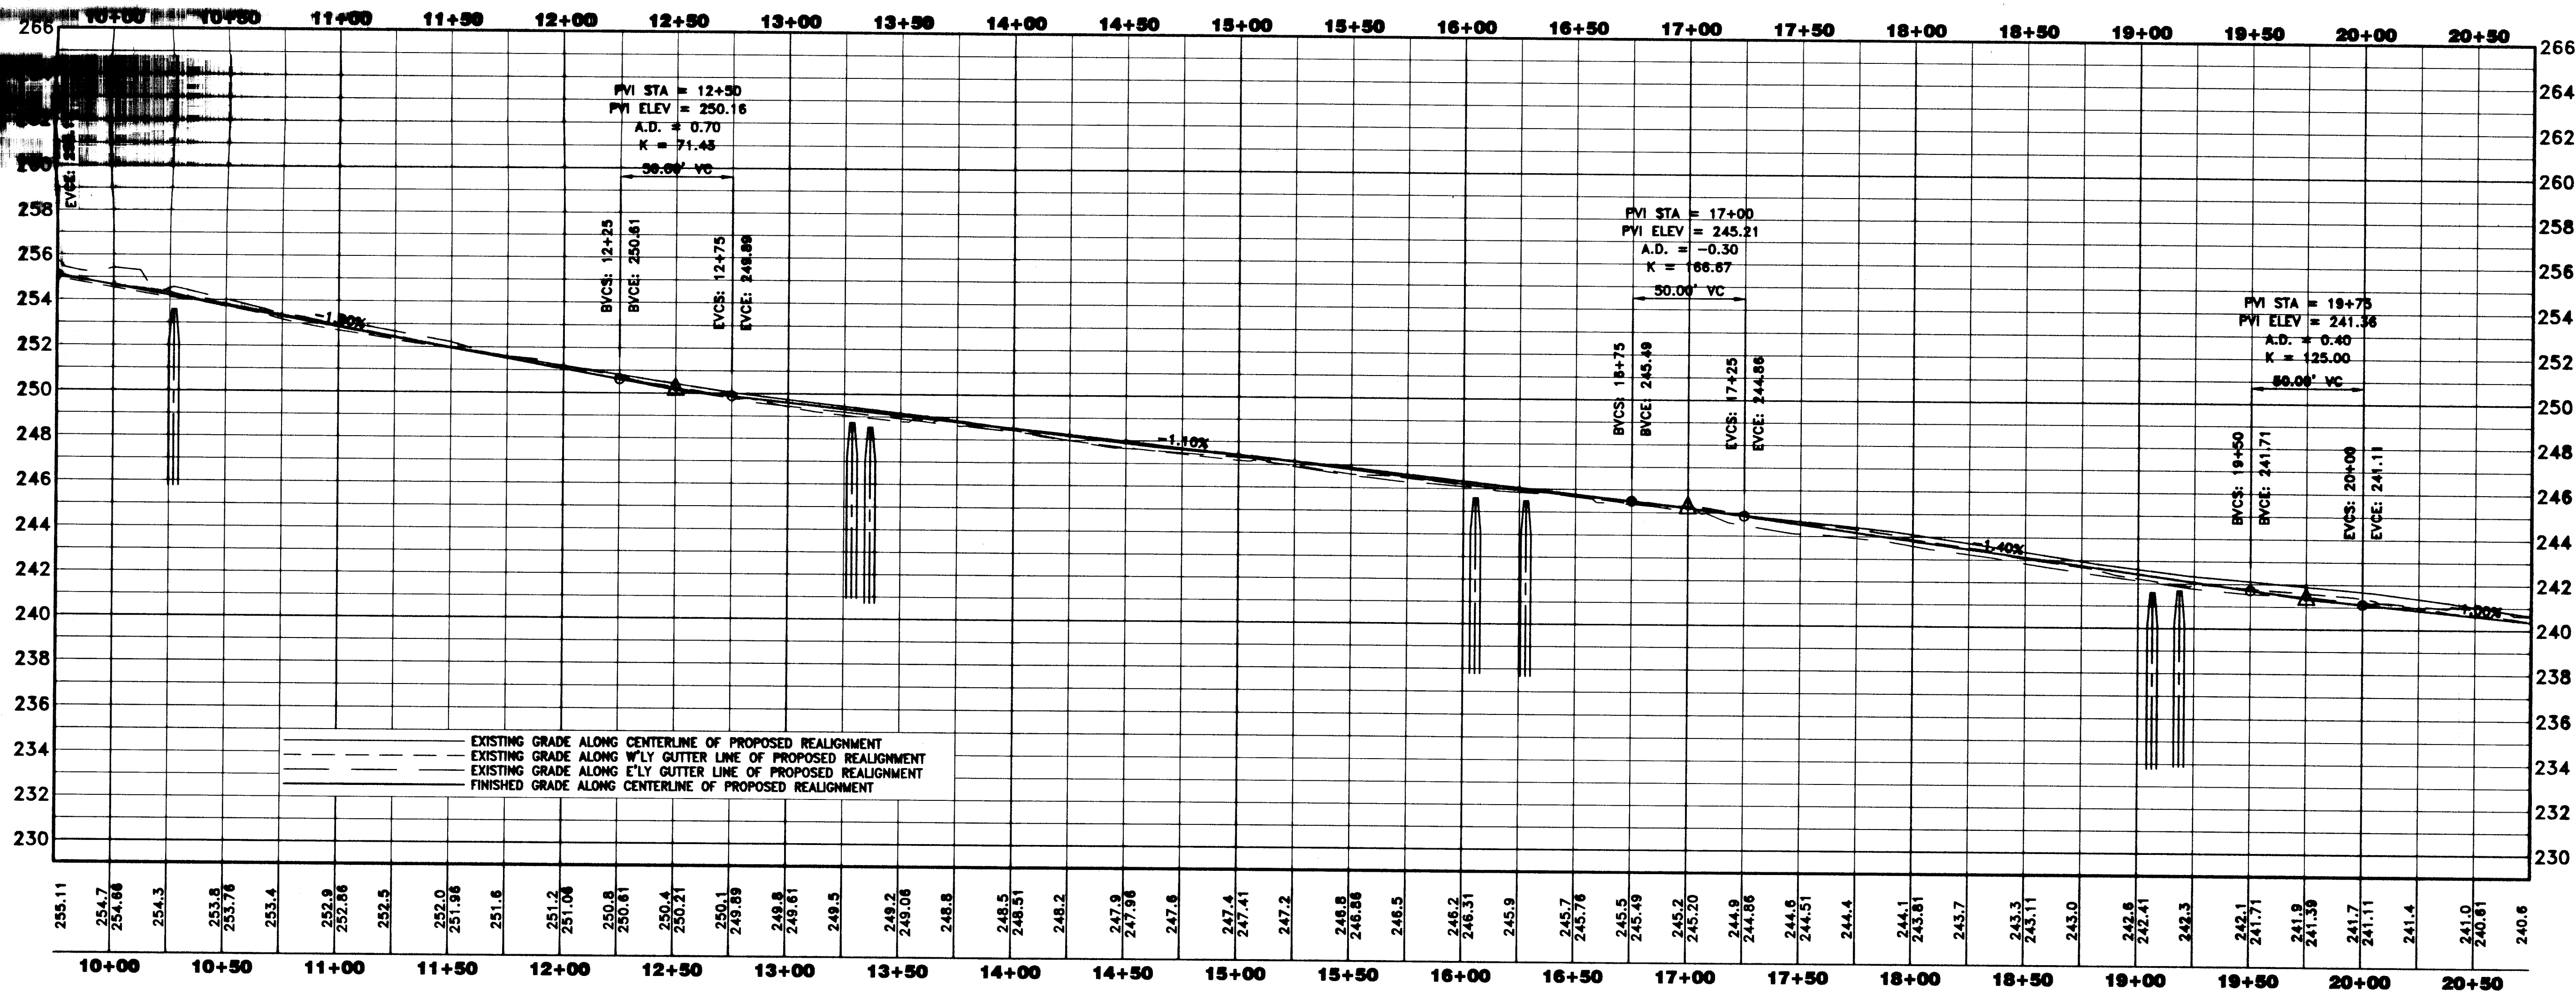

LEE STREET RECONSTRUCTION
 EAST LONGMEADOW, MA
 FOR THE
 EAST LONGMEADOW
 DEPARTMENT OF PUBLIC WORKS

ECOTEC ENVIRONMENTAL ASSOCIATES, INC.
 CIVIL ENGINEERING • LAND SURVEYS
 180 Denlow Road • P.O. Box 188 • East Longmeadow, MA 01028
 P. 413-525-6703 F. 413-525-3582 E. ecotec@inetmail.att.net

SCALE: PLAN 1"=40' PROFILE AS SHOWN DATE: MAY 2004
 DESIGNED BY: J.T. DRAWN BY: J.T. CHECKED BY: G.W.
 SURVEY BOOK: PROJECT NUMBER: