



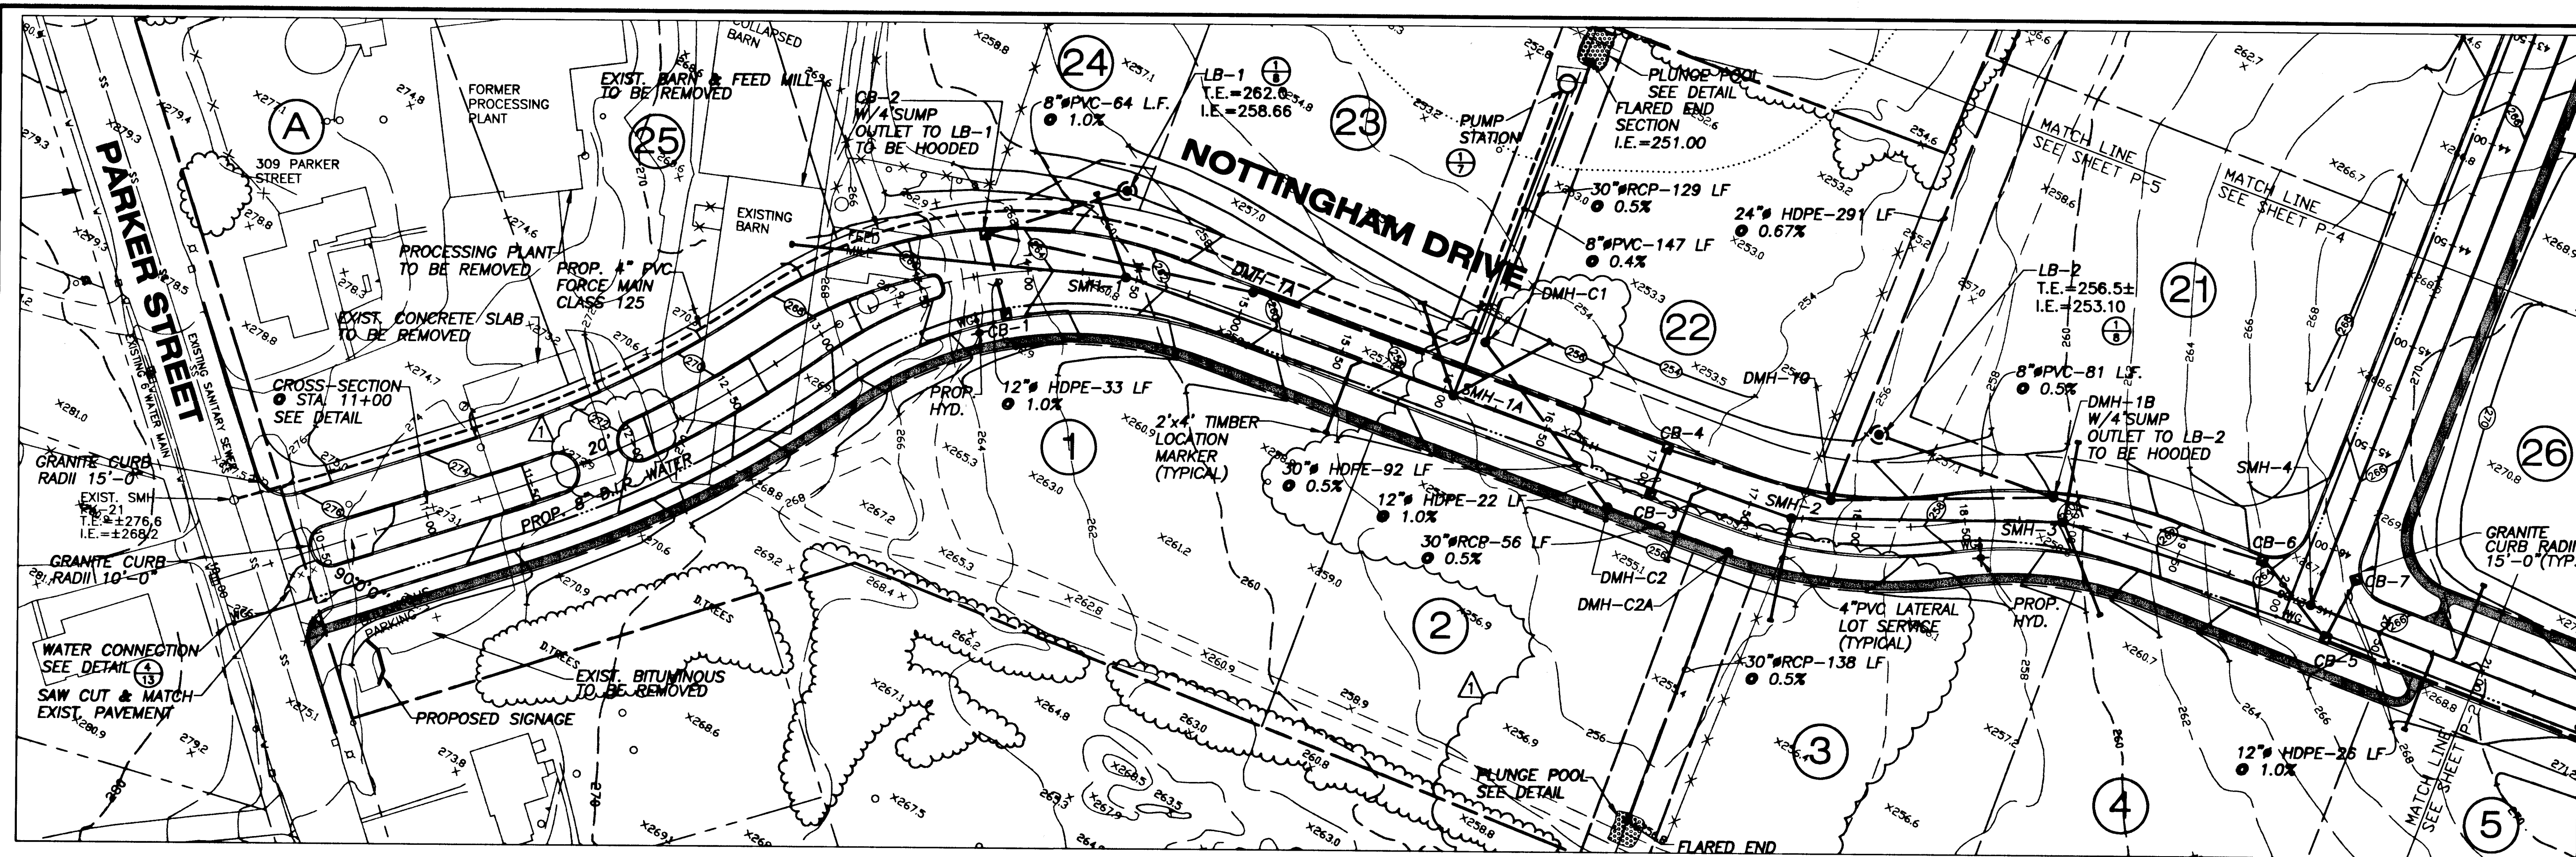

PLAN
1"=40'

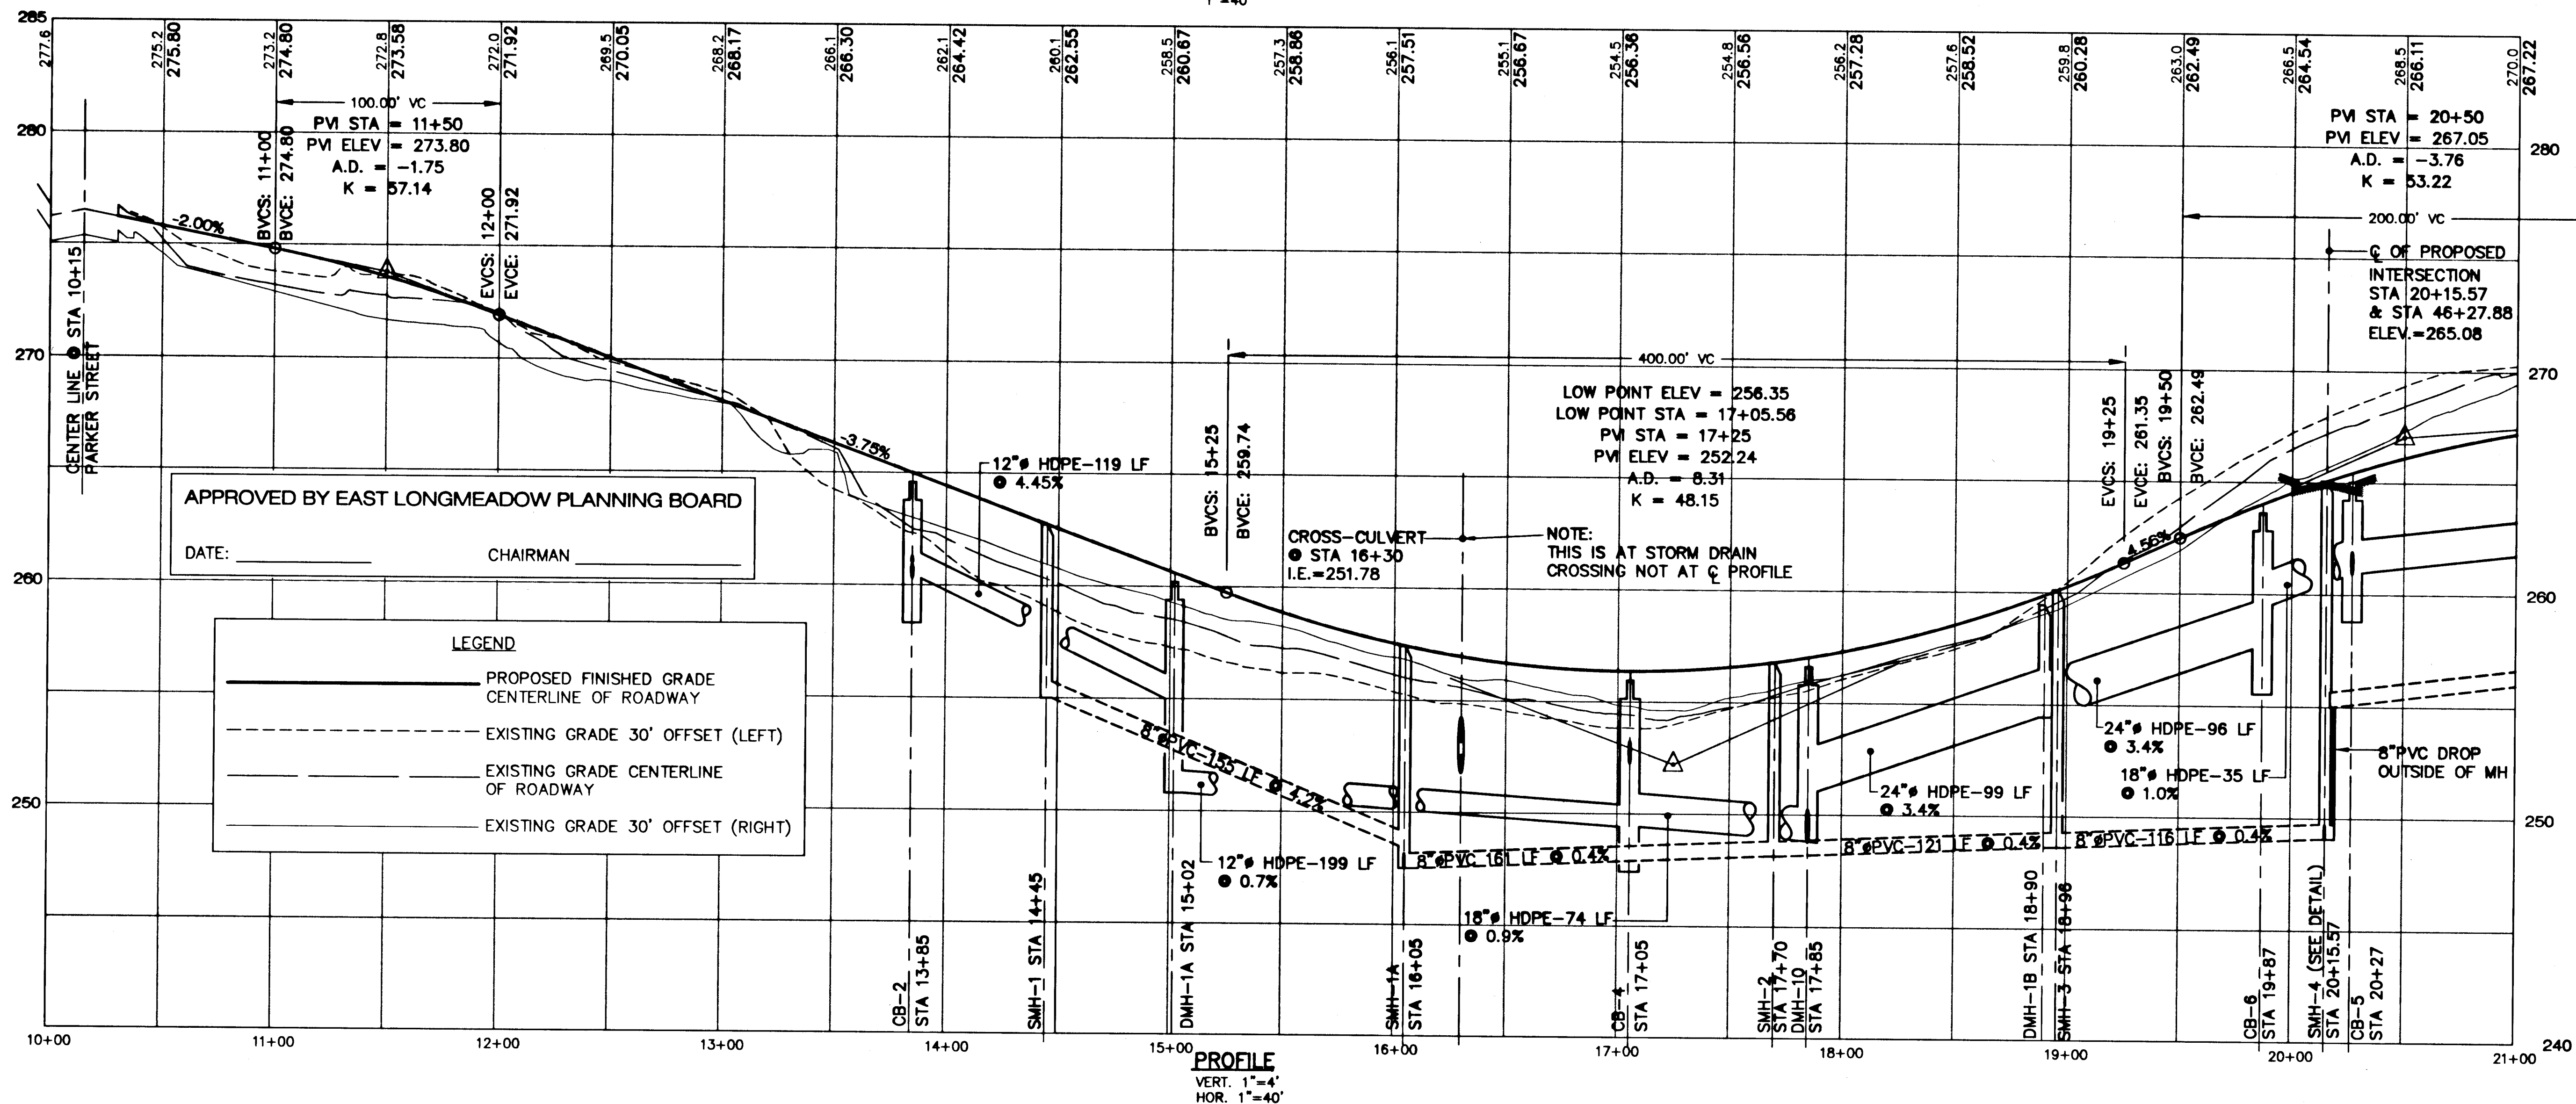


APPROVED BY EAST LONGMEADOW PLANNING BOARD

DATE: _____ CHAIRMAN _____

LEGEND


- PROPOSED FINISHED GRADE CENTERLINE OF ROADWAY
- EXISTING GRADE 30' OFFSET (LEFT)
- EXISTING GRADE CENTERLINE OF ROADWAY
- EXISTING GRADE 30' OFFSET (RIGHT)

No.	DATE	REVISION	BY
1	8/14/00	REVISED LOT LAYOUT, CROSS-CULVERT AND SEWER HOUSE CONNECTIONS	EDM
2	11/18/00	ADDED LOT "A"	EDM

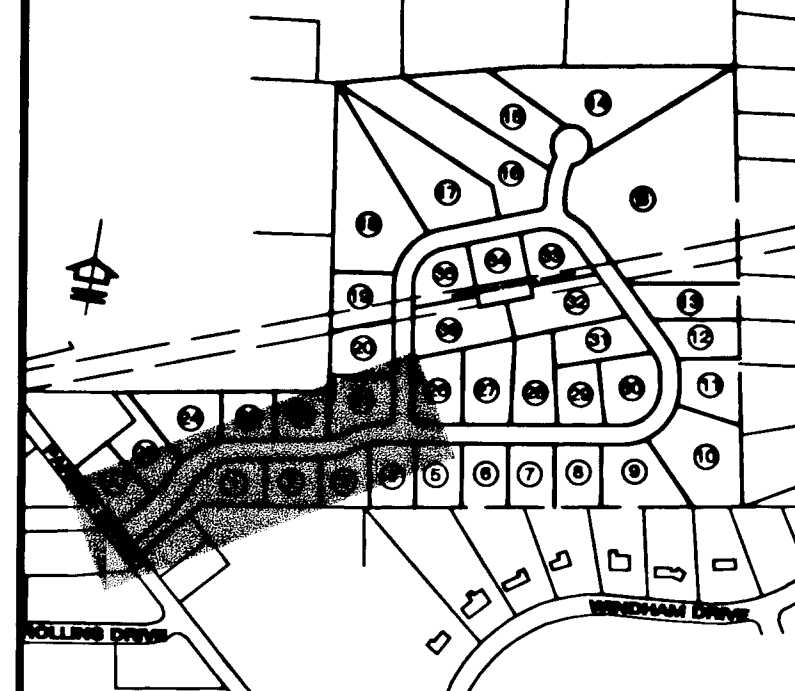

KEY MAP

SCALE: 1"=600'

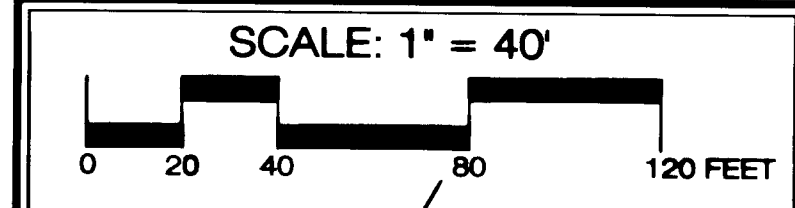

LEGEND

- PROPOSED PROPERTY LINE
- EXISTING PRIMARY PROPERTY LINE
- EXISTING 10' INTERVAL CONTOUR
- EXISTING 2' INTERVAL CONTOUR
- PROPOSED 2' INTERVAL CONTOUR
- EXISTING EDGE OF PAVEMENT
- PROPOSED BITUMINOUS CURB
- SOIL TEST BORING (APPROXIMATE LOCATION)
- PROPOSED ROADWAY CENTER LINE AND STATIONING
- PROPOSED LEACHING BASIN
- PROPOSED STORM DRAIN MANHOLE
- PROPOSED SEWER MANHOLE
- PROPOSED CATCH BASIN
- PROPOSED STORM DRAIN LINE
- PROPOSED SANITARY SEWER
- PROPOSED SEWER FORCE MAIN
- PROPOSED WATER LINE
- PROPOSED WATER GATE
- EXISTING SANITARY SEWER
- WETLAND BOUNDARY LINE
- 100 FT. WETLAND BUFFER

PLAN/PROFILE No. 1
NOTTINGHAM DRIVE
STA 10+00 - 21+00

PROJECT AND LOCATION:
NOTTINGHAM MEADOWS
EAST LONGMEADOW, MA

PREPARED FOR:
APPLE LAND DEVELOPMENT, INC.
296 NORTH MAIN STREET
EAST LONGMEADOW, MA

BAYSTATE ENVIRONMENTAL CONSULTANTS INC.

Civil Engineers Environmental Scientists
296 North Main Street East Longmeadow, MA 01028

PROJECT No. 99-1104
SCALE: VERT. 1"=4' HOR. 1"=40'
DATE: 6/2000
DESIGNED BY: F.A.D.
CHECKED BY: M.L.P.

SHEET No. **6**
6 of 13 SWS