


EAST LONGMEADOW DEPARTMENT OF PUBLIC WORKS


Job: JOHN ST @ SHAW ST TIE IN

Sheet No: _____ of 8.9.16

Calculated By: T. LONGO Date _____

Scale: _____

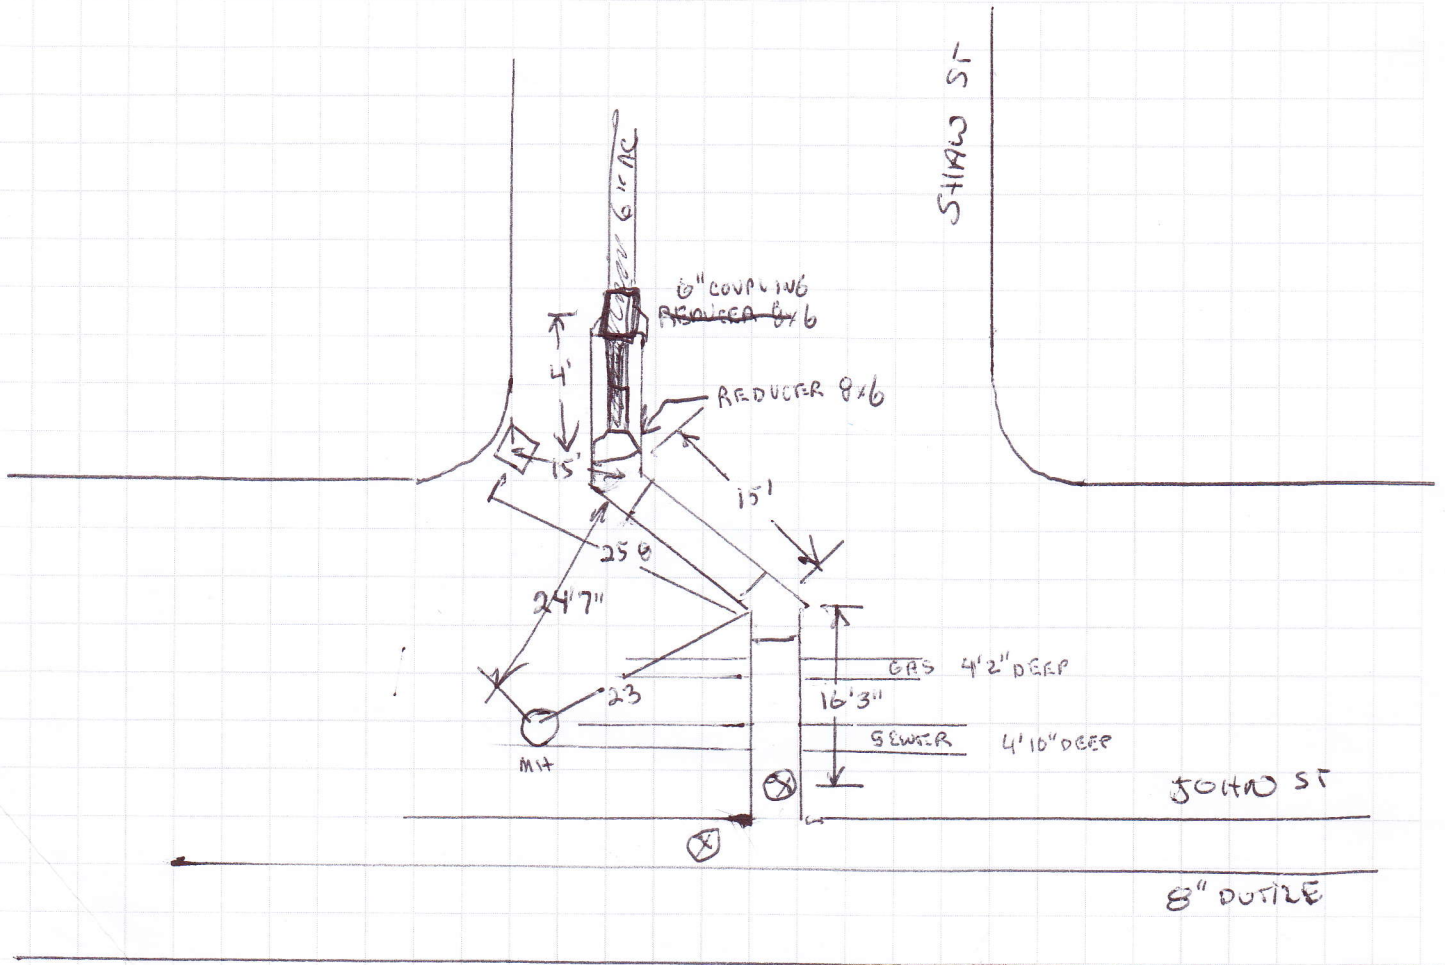

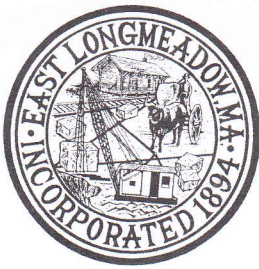


EAST LONGMEADOW DEPARTMENT OF PUBLIC WORKS


Job: JOHN @ HELEN CIR (TIE IN) NORTH

Sheet No: _____ of _____

Calculated By: T. LOWES Date 7.18.16

Scale: _____

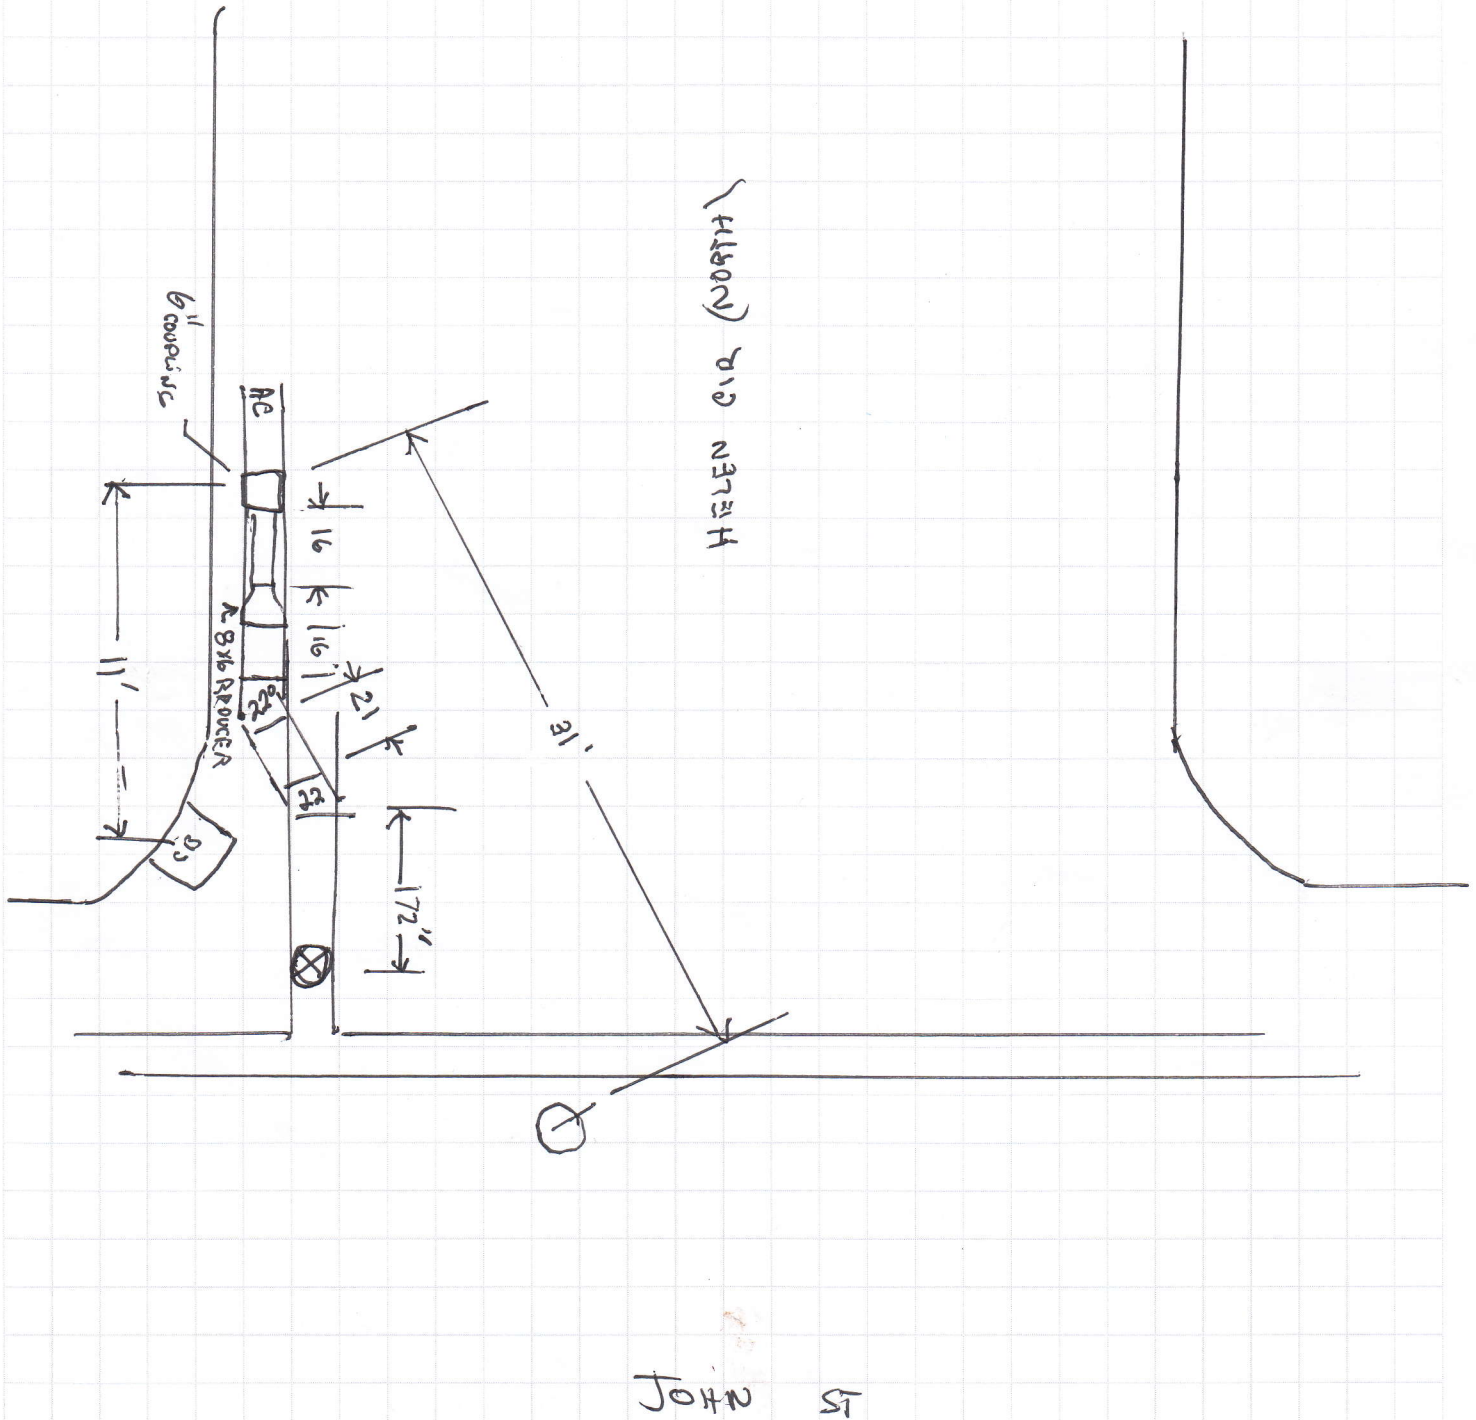

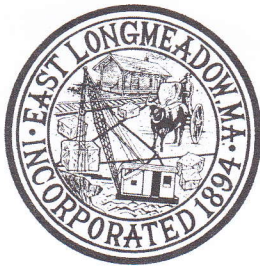

EAST LONGMEADOW DEPARTMENT OF PUBLIC WORKS

Job: JOHN ST TO VILLAGE GREEN TIE IN
Sheet No: 7/16 of _____
Calculated By: T. LONGO Date _____
Scale: _____

JOHN ST

