

STA. 0+00 MERRIAM ST. =
STA. 7+93 GREENACRE LANE

STA. 0+85 HYDRANT ASSEMBLY

1-8"x6" ANCHORING TEE, MJ, BLOCKED
1-6" GATE VALVE WITH BOX
1-6" NIPPLE, LENGTH AS REQUIRED
1-HYDRANT, BLOCKED

STA. 3+88 FRANKWYN STREET CONNECTION

ALONG MERRIAM STREET:
2-8" GATE VALVE & BOX
2-8" NIPPLE, 36" LENGTH
1-8"x8" TEE, MJ, BLOCKED

ALONG FRANKWYN STREET:
1-8" NIPPLE, 36" LENGTH
1-8" GATE VALVE & BOX
1-8" NIPPLE, LENGTH AS REQUIRED
1-8" COUPLING

STA. 7+25 HYDRANT ASSEMBLY

1-8"x6" ANCHORING TEE, MJ, BLOCKED
1-6" GATE VALVE WITH BOX
1-6" NIPPLE, LENGTH AS REQUIRED
1-HYDRANT, BLOCKED

STA. 9+65 HYDRANT ASSEMBLY


1-8"x6" ANCHORING TEE, MJ, BLOCKED
1-6" GATE VALVE WITH BOX
1-6" NIPPLE, LENGTH AS REQUIRED
1-HYDRANT, BLOCKED

STA. 10+18 MAPLESHADE AVENUE CONNECTION

1. PORTIONS OF EXISTING MAIN SHALL BE REMOVED TO ALLOW FOR CONNECTION

2. ALONG MERRIAM STREET:
1-8" NIPPLE, 36" LENGTH
1-8" GATE VALVE & BOX

3. ALONG MAPLESHADE AVENUE:
1-8"x8" TEE, MJ, BLOCKED
4-8" NIPPLES, 36" LENGTH
2-8" GATE VALVES & BOX
2-8"x6" REDUCERS, MJ
2-6" NIPPLES, 36" LENGTH
2-6" COUPLING

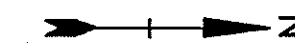

STA. 0+00 NORTH MAIN STREET CONNECTION

1. PORTIONS OF EXISTING MAIN SHALL BE REMOVED TO ALLOW FOR CONNECTION

2. ALONG GREENACRE LANE:
1-8" NIPPLE, 36" LENGTH
1-8" GATE VALVE & BOX

3. ALONG NORTH MAIN STREET:
1-8"x8" TEE, MJ, BLOCKED
4-8" NIPPLES, 36" LENGTH
2-8" GATE VALVES & BOX
2-8" COUPLING #2


STA. 0+00 MERRIAM ST. =
STA. 7+93 GREENACRE LANE

ALONG GREENACRE LANE:
2-8" GATE VALVE & BOX
2-8" NIPPLE, 36" LENGTH
1-8"x8" TEE, MJ, BLOCKED

ALONG MERRIAM STREET:
1-8" NIPPLE, 36" LENGTH
1-8" GATE VALVE & BOX

STA. 10+95 HYDRANT ASSEMBLY

1-8"x6" ANCHORING TEE, MJ, BLOCKED
1-6" GATE VALVE WITH BOX
1-6" NIPPLE, LENGTH AS REQUIRED
1-HYDRANT, BLOCKED

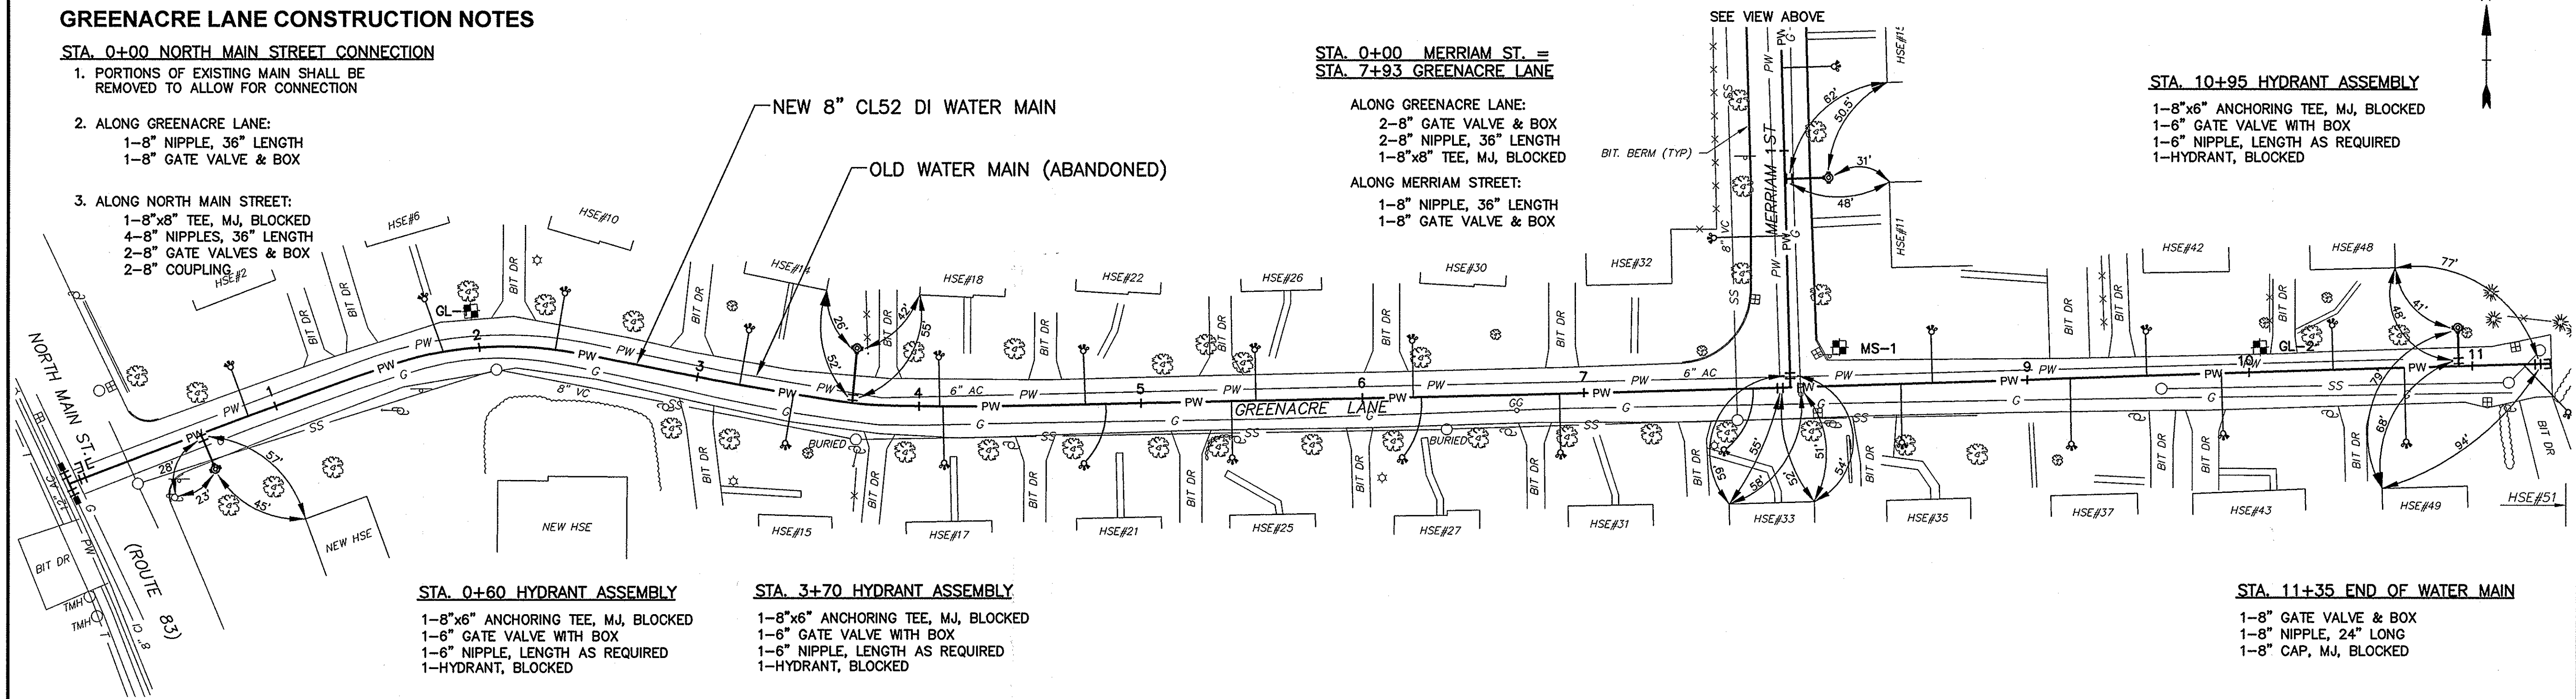

STA. 0+60 HYDRANT ASSEMBLY

1-8"x6" ANCHORING TEE, MJ, BLOCKED
1-6" GATE VALVE WITH BOX
1-6" NIPPLE, LENGTH AS REQUIRED
1-HYDRANT, BLOCKED

STA. 3+70 HYDRANT ASSEMBLY

1-8"x6" ANCHORING TEE, MJ, BLOCKED
1-6" GATE VALVE WITH BOX
1-6" NIPPLE, LENGTH AS REQUIRED
1-HYDRANT, BLOCKED

STA. 11+35 END OF WATER MAIN



1-8" GATE VALVE & BOX
1-8" NIPPLE, 24" LONG
1-8" CAP, MJ, BLOCKED

RECORD PLAN

THIS RECORD PLAN WAS PREPARED BASED ON LIMITED INFORMATION GATHERED DURING CONSTRUCTION OF THE PROJECT AND INDICATES ONLY SIGNIFICANT CHANGES MADE FROM THE DESIGN PLANS DURING CONSTRUCTION.

Tighe&Bond

Consulting Engineers
53 Southampton Road
Westfield, Massachusetts
(413) 562-1600
www.tighebond.com

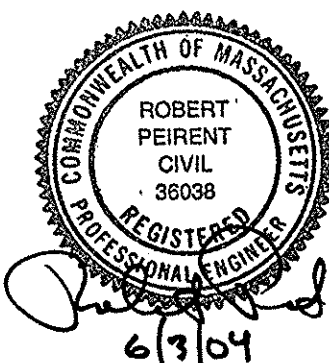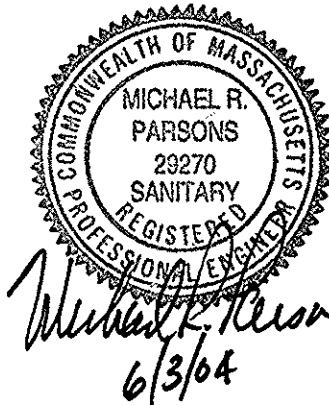

FY2004 Water Improvements

Department of
Public Works

East Longmeadow,
Massachusetts

1	1/05	RECORD PLAN
Mark	Date	Description
PROJECT NO:		E0451-3-02
FILE:		E0451WATER/C003
DRAWN BY:		TMF
CHECKED:		SMS
APPROVED BY:		RP, MRP

MERRIAM STREET,
GREENACRE LANE

SCALE: 1" = 40'

SHEET 4 OF 9