

STA. 0+00 MERRIAM ST. =  
STA. 7+93 GREENACRE LANE

ALONG GREENACRE LANE:  
2-8" GATE VALVE & BOX  
2-8" NIPPLE, 36" LENGTH  
1-8"x8" TEE, MJ, BLOCKED

ALONG MERRIAM STREET:  
1-8" NIPPLE, 36" LENGTH  
1-8" GATE VALVE & BOX

1-8"x6" ANCHORING TEE, MJ, BLOCKED  
1-6" GATE VALVE WITH BOX  
1-6" NIPPLE, LENGTH AS REQUIRED  
1-HYDRANT, BLOCKED

ALONG MERRIAM STREET:  
2-8" GATE VALVE & BOX  
2-8" NIPPLE, 36" LENGTH  
1-8"x8" TEE, MJ, BLOCKED

ALONG FRANKWYN STREET:  
1-8" NIPPLE, 36" LENGTH  
1-8" GATE VALVE & BOX  
1-8" NIPPLE, LENGTH AS REQUIRED  
1-8" COUPLING


1-8"x6" ANCHORING TEE, MJ, BLOCKED  
1-6" GATE VALVE WITH BOX  
1-6" NIPPLE, LENGTH AS REQUIRED  
1-HYDRANT, BLOCKED

1-8"x6" ANCHORING TEE, MJ, BLOCKED  
1-6" GATE VALVE WITH BOX  
1-6" NIPPLE, LENGTH AS REQUIRED  
1-HYDRANT, BLOCKED

1. PORTIONS OF EXISTING MAIN SHALL BE REMOVED TO ALLOW FOR CONNECTION

2. ALONG MERRIAM STREET:  
1-8" NIPPLE, 36" LENGTH  
1-8" GATE VALVE & BOX

3. ALONG MAPLESHADE AVENUE:  
1-8"x8" TEE, MJ, BLOCKED  
4-8" NIPPLES, 36" LENGTH  
2-8" GATE VALVES & BOX  
2-8"x6" REDUCERS, MJ  
2-6" NIPPLES, 36" LENGTH  
2-6" COUPLING

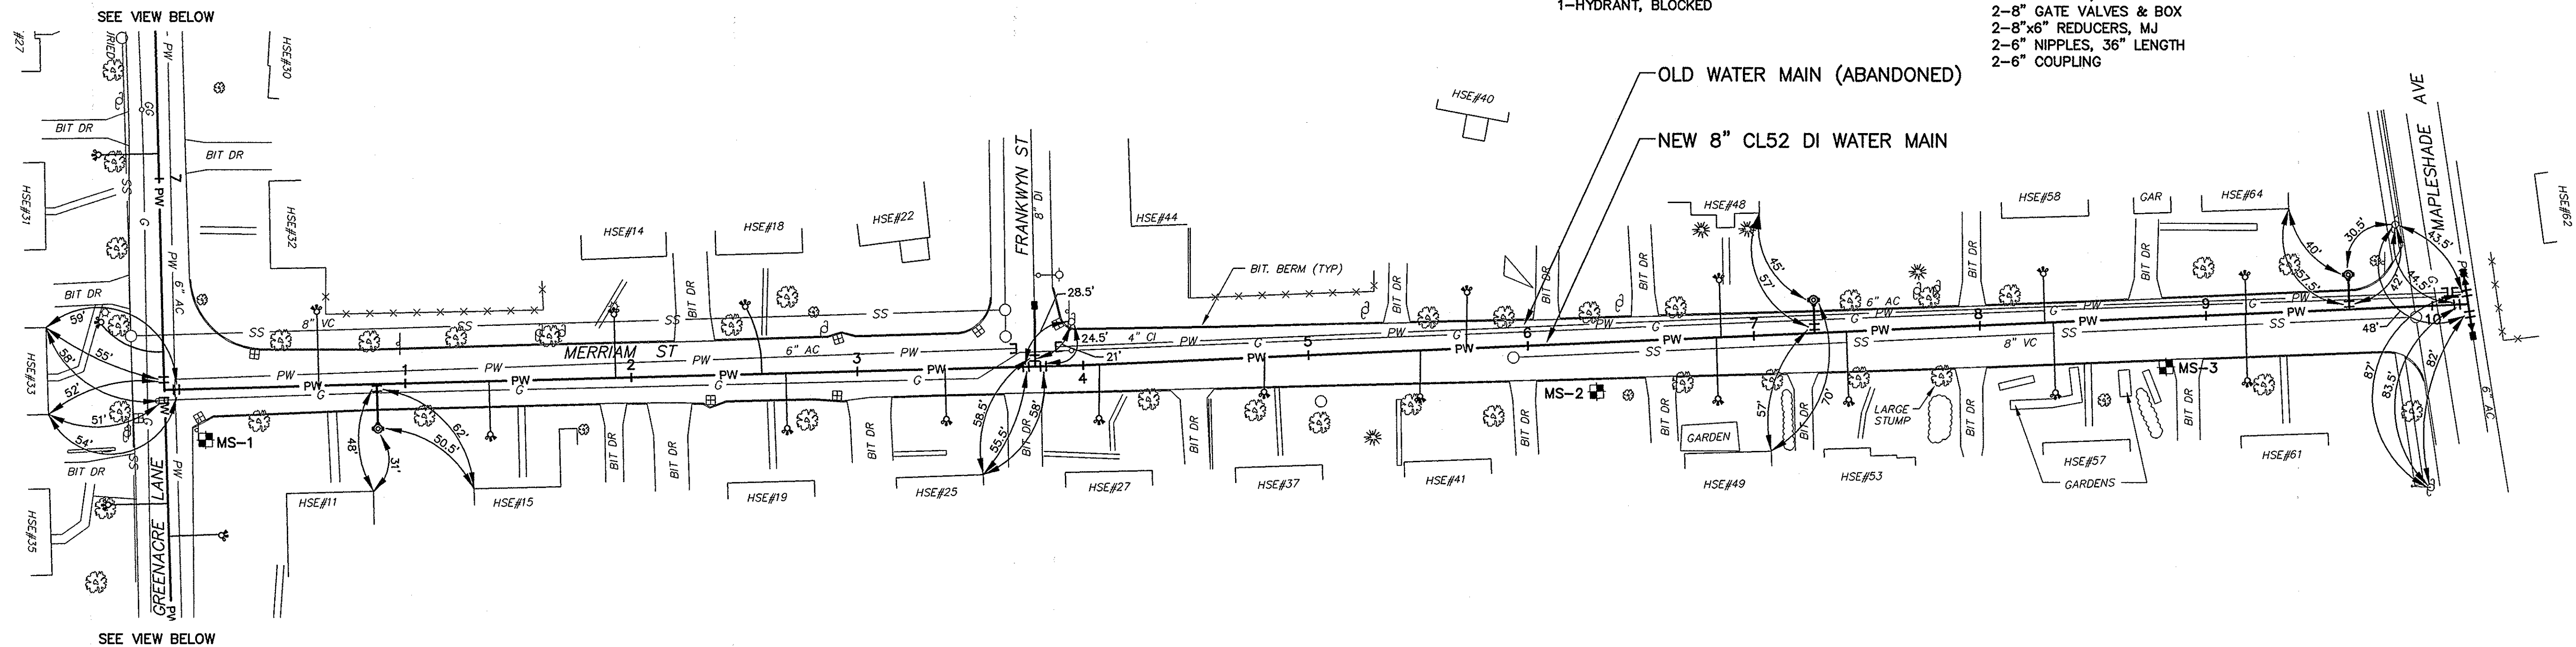

1. PORTIONS OF EXISTING MAIN SHALL BE REMOVED TO ALLOW FOR CONNECTION


2. ALONG GREENACRE LANE:  
1-8" NIPPLE, 36" LENGTH  
1-8" GATE VALVE & BOX

3. ALONG NORTH MAIN STREET:  
1-8"x8" TEE, MJ, BLOCKED  
4-8" NIPPLES, 36" LENGTH  
2-8" GATE VALVES & BOX  
2-8" COUPLING

ALONG GREENACRE LANE:  
2-8" GATE VALVE & BOX  
2-8" NIPPLE, 36" LENGTH  
1-8"x8" TEE, MJ, BLOCKED

ALONG MERRIAM STREET:  
1-8" NIPPLE, 36" LENGTH  
1-8" GATE VALVE & BOX

1-8"x6" ANCHORING TEE, MJ, BLOCKED  
1-6" GATE VALVE WITH BOX  
1-6" NIPPLE, LENGTH AS REQUIRED  
1-HYDRANT, BLOCKED

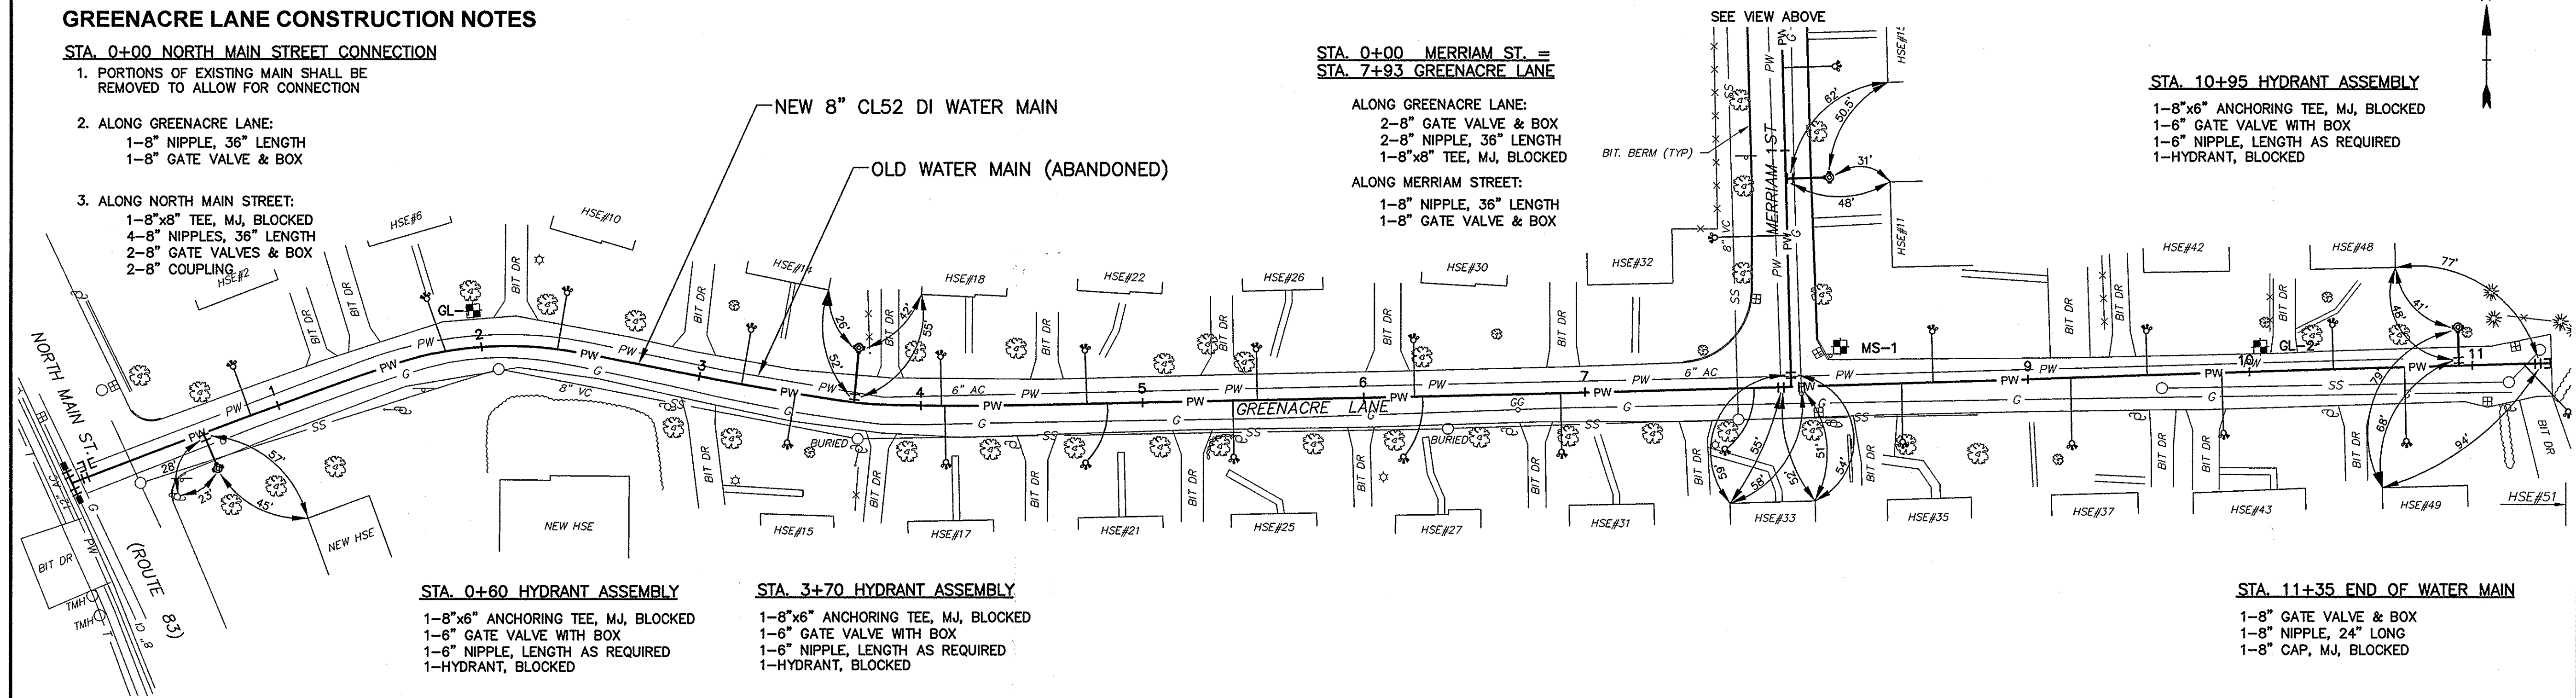

1-8"x6" ANCHORING TEE, MJ, BLOCKED  
1-6" GATE VALVE WITH BOX  
1-6" NIPPLE, LENGTH AS REQUIRED  
1-HYDRANT, BLOCKED

1-8"x6" ANCHORING TEE, MJ, BLOCKED  
1-6" GATE VALVE WITH BOX  
1-6" NIPPLE, LENGTH AS REQUIRED  
1-HYDRANT, BLOCKED



1-8" GATE VALVE & BOX  
1-8" NIPPLE, 24" LONG  
1-8" CAP, MJ, BLOCKED

## RECORD PLAN

THIS RECORD PLAN WAS PREPARED BASED ON LIMITED INFORMATION GATHERED DURING CONSTRUCTION OF THE PROJECT AND INDICATES ONLY SIGNIFICANT CHANGES MADE FROM THE DESIGN PLANS DURING CONSTRUCTION.

## Tighe&Bond

*Consulting Engineers*  
53 Southampton Road  
Westfield, Massachusetts  
(413) 562-1600  
[www.tighebond.com](http://www.tighebond.com)

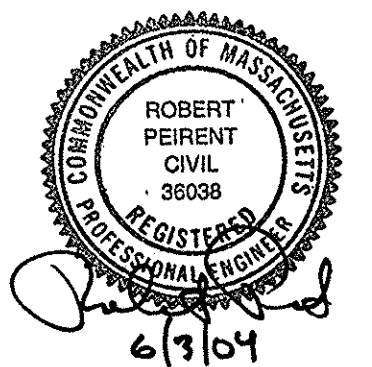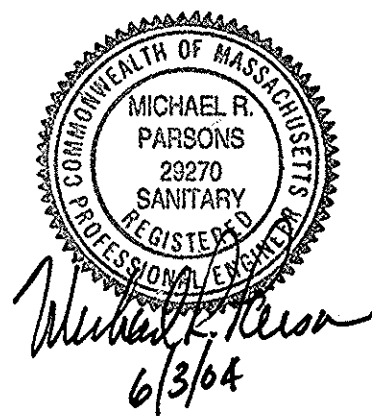

# FY2004 Water Improvements

Department of  
Public Works

East Longmeadow,  
Massachusetts

| 1            | 1/05 | RECORD PLAN      |
|--------------|------|------------------|
| Mark         | Date | Description      |
| PROJECT NO:  |      | E0451-3-02       |
| FILE:        |      | E0451\WATER\C003 |
| DRAWN BY:    |      | TMF              |
| CHECKED:     |      | SMS              |
| APPROVED BY: |      | RP, MRP          |

MERRIAM STREET,  
GREENACRE LANE

SCALE: 1" = 40'

SHEET 4 OF 9