


STA. 0+00 GERRARD AVENUE CONNECTION

- PORTIONS OF EXISTING 6" AC WATER MAIN SHALL BE REMOVED TO ALLOW FOR CONNECTION
- ALONG KELSEY AVENUE:
 - 1-8" NIPPLE, 36" LENGTH
 - 1-8" GATE VALVE & BOX
- ALONG GERRARD AVENUE:
 - 1-8"x8" TEE, MJ, BLOCKED
 - 3-8" NIPPLES, 36" LENGTH
 - 2-8" GATE VALVES & BOX
 - 1-8"x6" REDUCERS, MJ
 - 1-6" NIPPLES, 36" LENGTH
 - 1-6" COUPLING
 - EXTEND PIPING SOUTHERLY OF NEW TEE TO ALLOW FOR REMOVAL OF EXISTING 3/4" CONNECTION

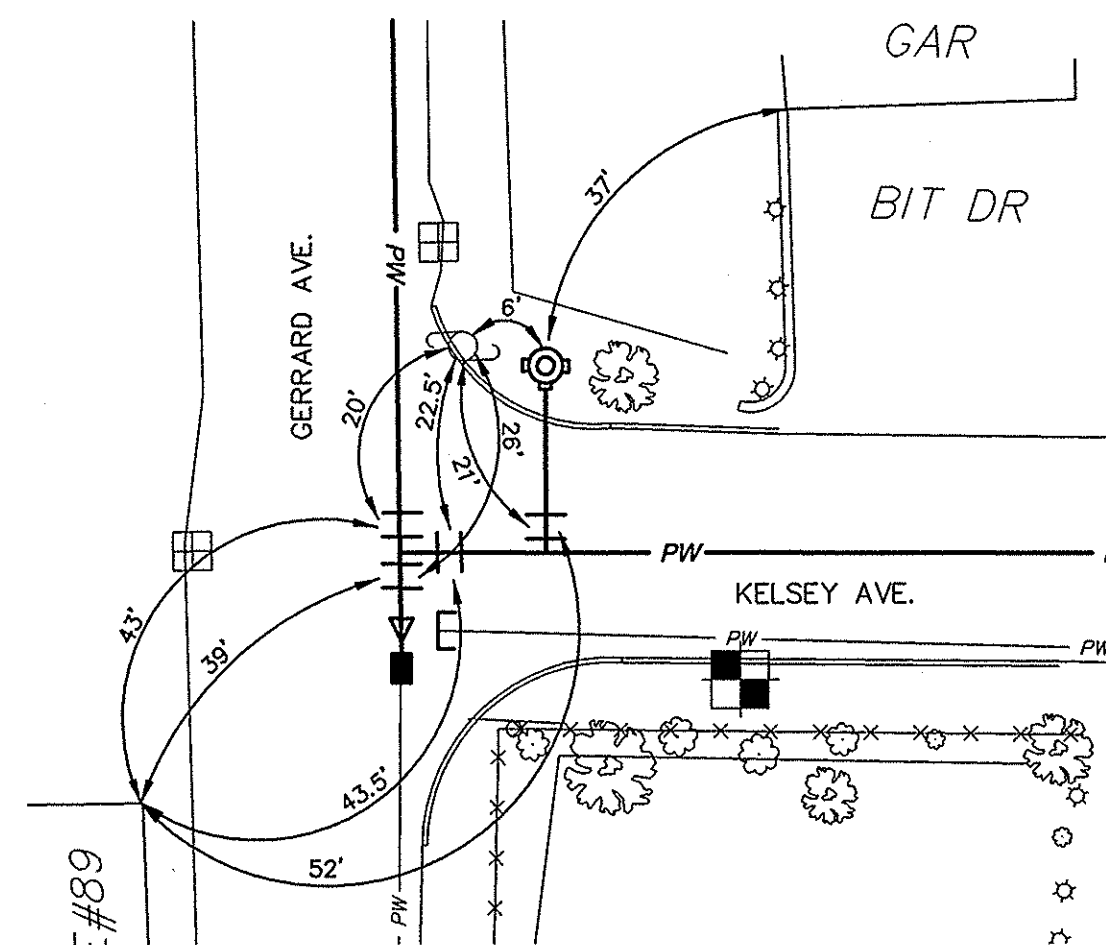

GERRARD AVENUE - KELSEY AVENUE
1"=20'

EUCLID AVENUE
CONSTRUCTION NOTES

STA. 1+89 TEE CONNECTION


- 1-8"x8" TEE, MJ, BLOCKED
- ALONG GERRARD AVENUE:
 - 3-8" NIPPLE, LENGTH AS REQUIRED
 - 1-8" GATE VALVE & BOX
 - 1-8"x6" REDUCER, MJ
 - 1-6" COUPLING
- ALONG EUCLID AVENUE:
 - 1-8" NIPPLE, 24" LENGTH
 - 1-8" GATE VALVE & BOX

STA. 2+05 HYDRANT ASSEMBLY

- 1-8"x6" ANCHORING TEE, MJ, BLOCKED
- 1-6" GATE VALVE WITH BOX
- 1-6" NIPPLE, LENGTH AS REQUIRED
- 1-6" HYDRANT, BLOCKED

STA. 7+60 HYDRANT ASSEMBLY

- 1-8"x6" ANCHORING TEE, MJ, BLOCKED
- 1-6" GATE VALVE WITH BOX
- 1-6" NIPPLE, LENGTH AS REQUIRED
- 1-6" HYDRANT, BLOCKED

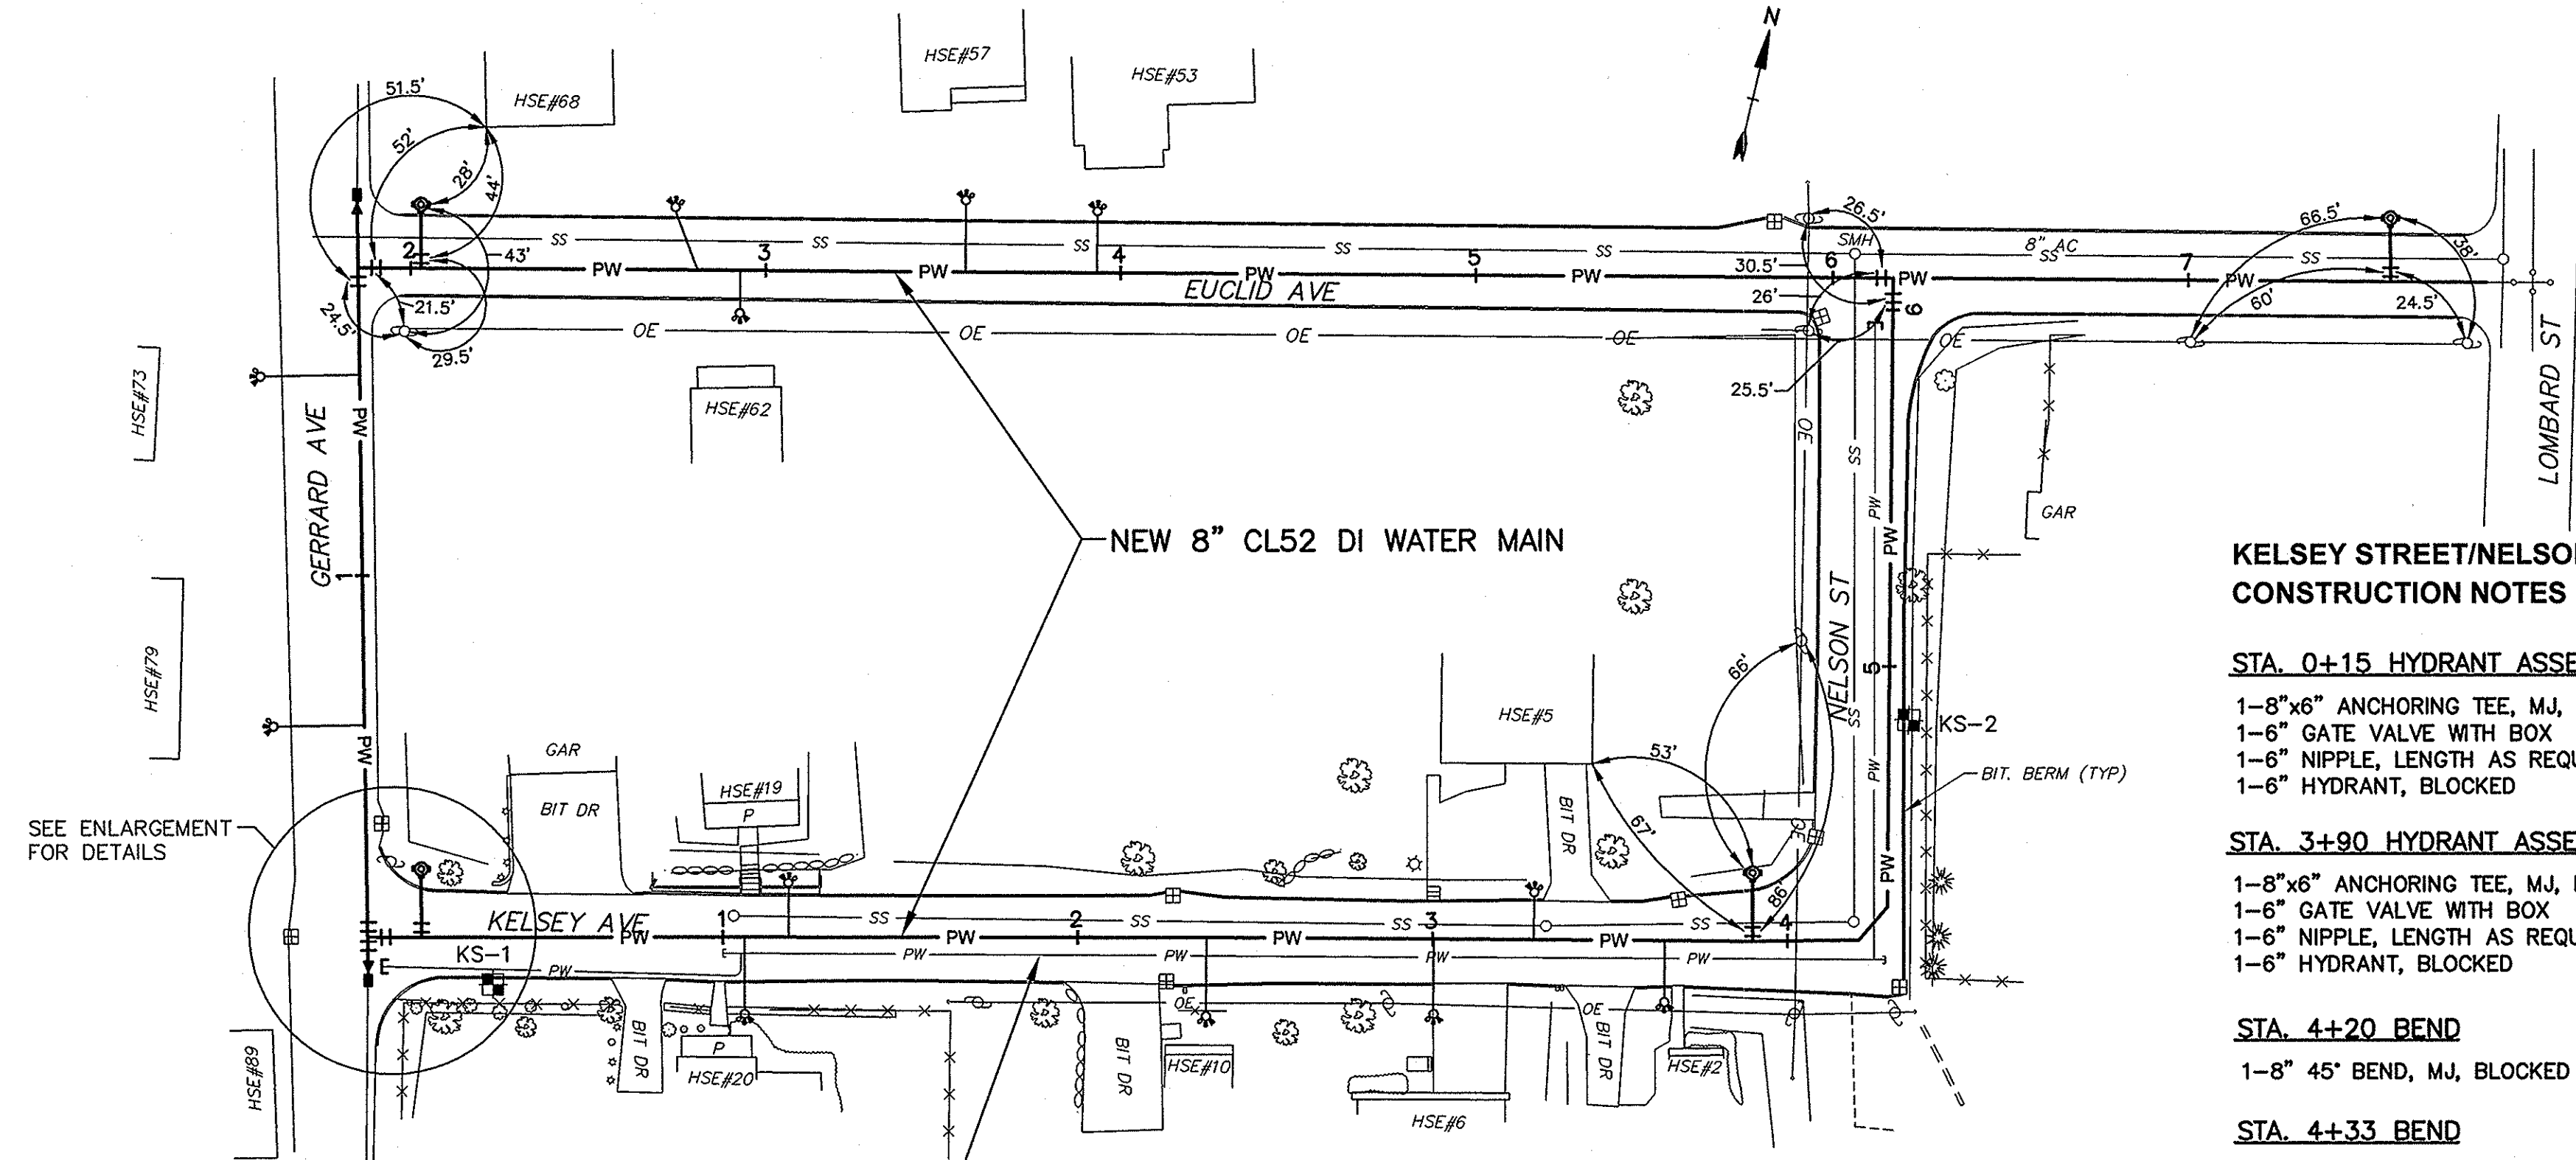

OLD WATER MAIN (ABANDONED)

NOTE:

WATER MAIN WORK ALONG GERRARD AVENUE AND EUCLID AVENUE WAS ADDED DURING CONSTRUCTION. MAPPING FOR THESE TWO STREETS WAS TAKEN FROM BAY STATE GAS AERIAL MAPPING.

KELSEY STREET/NELSON STREET
CONSTRUCTION NOTES

STA. 0+15 HYDRANT ASSEMBLY

- 1-8"x6" ANCHORING TEE, MJ, BLOCKED
- 1-6" GATE VALVE WITH BOX
- 1-6" NIPPLE, LENGTH AS REQUIRED
- 1-6" HYDRANT, BLOCKED

STA. 3+90 HYDRANT ASSEMBLY

- 1-8"x6" ANCHORING TEE, MJ, BLOCKED
- 1-6" GATE VALVE WITH BOX
- 1-6" NIPPLE, LENGTH AS REQUIRED
- 1-6" HYDRANT, BLOCKED

STA. 4+20 BEND


- 1-8" 45° BEND, MJ, BLOCKED

STA. 4+33 BEND


- 1-8" 45° BEND, MJ, BLOCKED

STA. 6+10 TEE CONNECTION

- 1-8"x8" TEE, MJ, BLOCKED
- 2-8" NIPPLES, 24" LENGTH
- 2-8" GATE VALVE & BOX

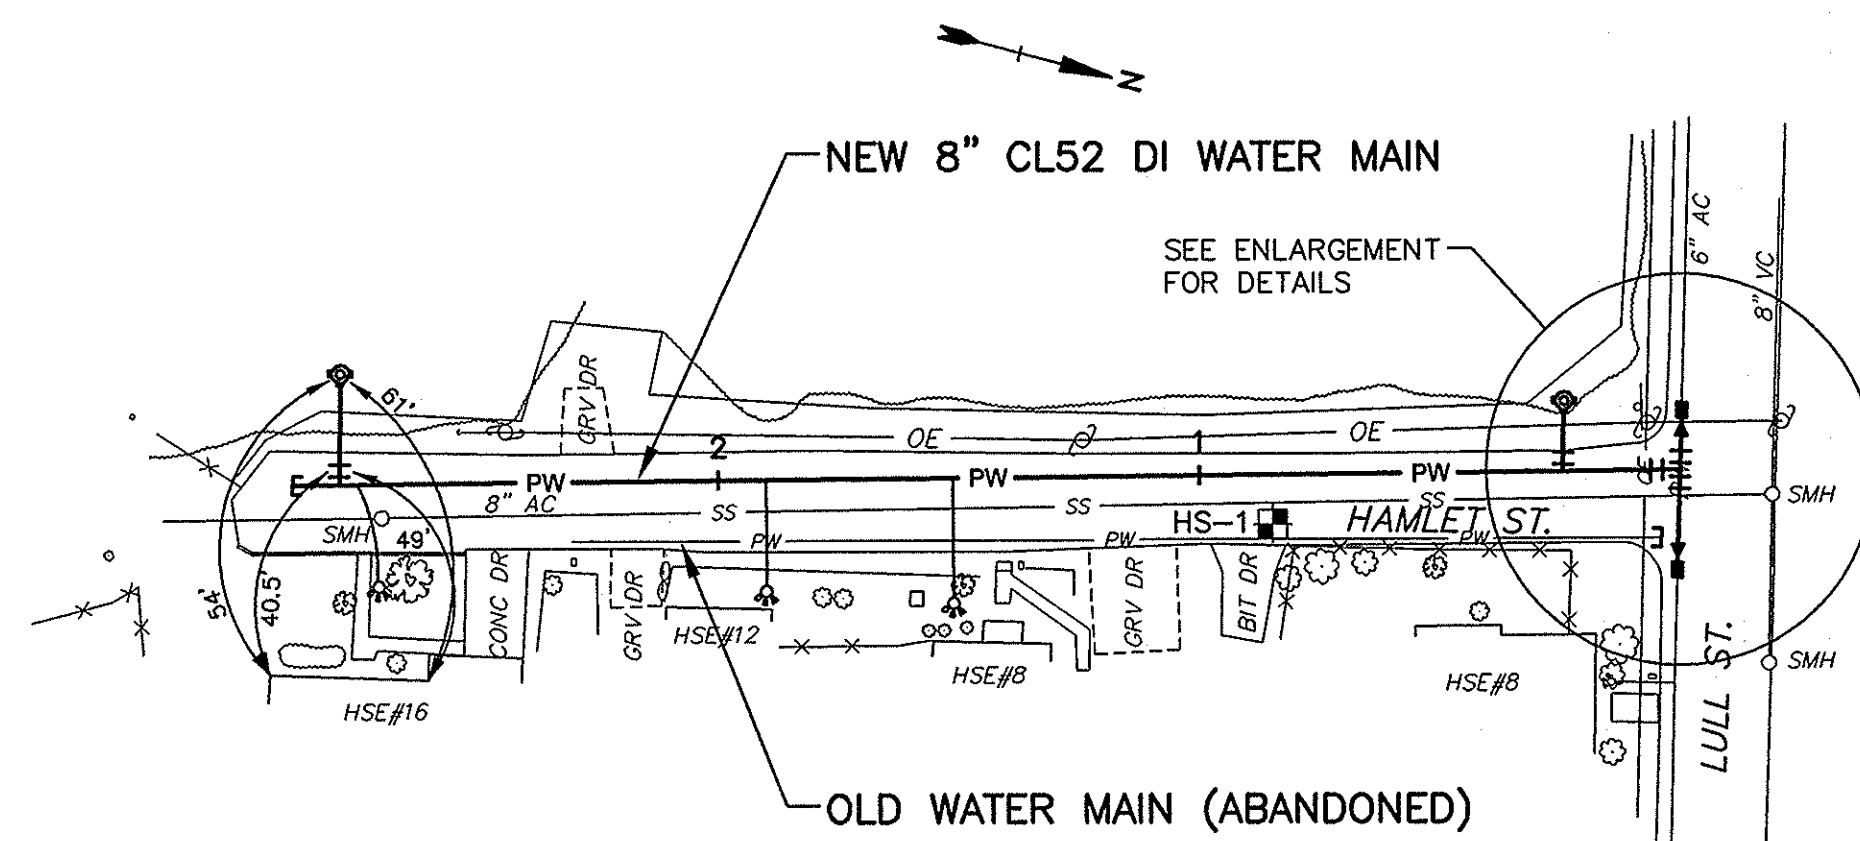

OLD WATER MAIN (ABANDONED)

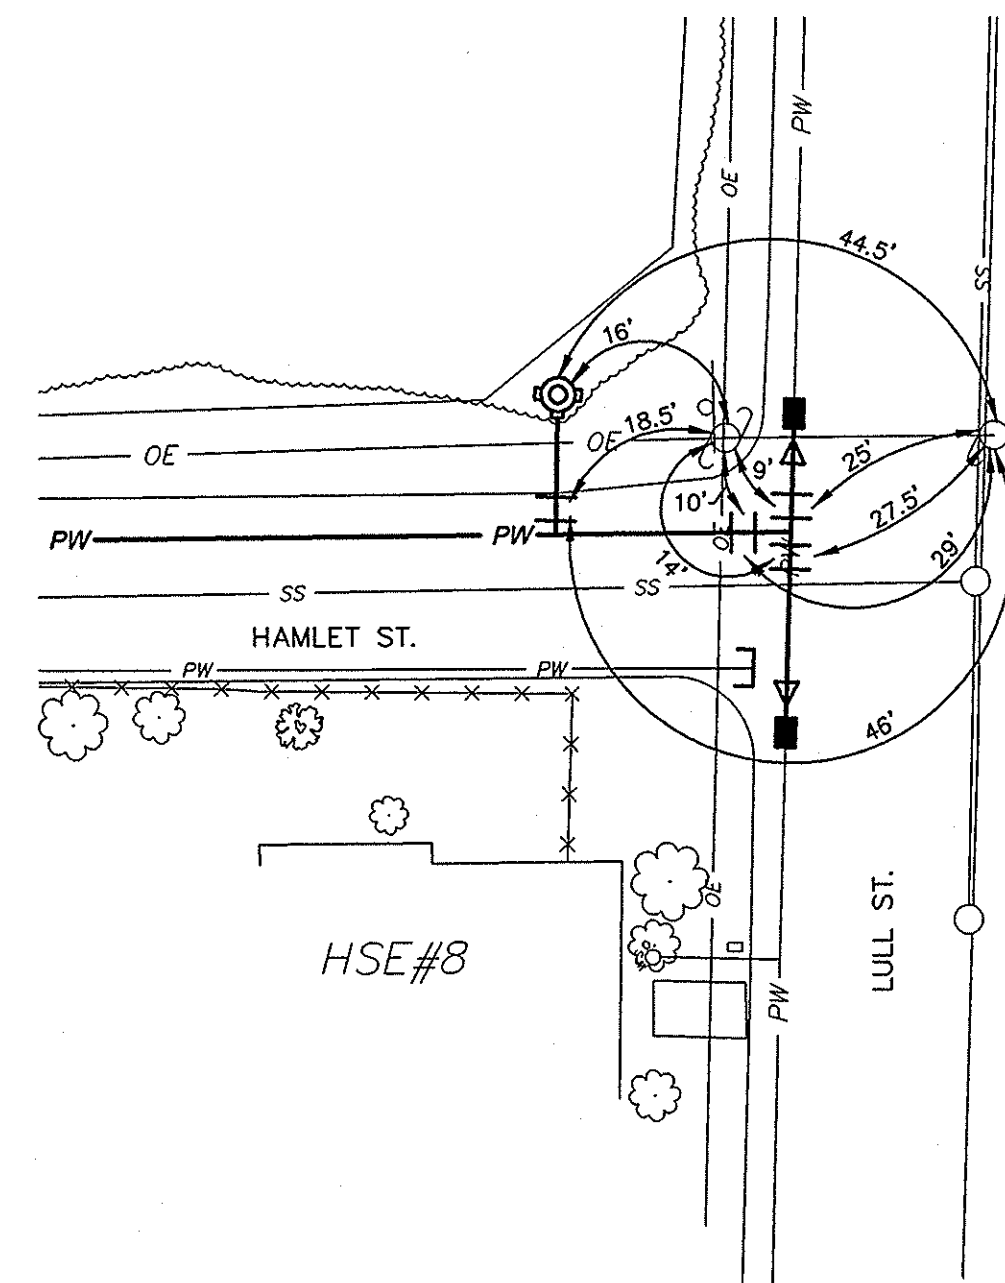

HAMLET STREET - LULL STREET
1"=20'

STA. 0+00 LULL STREET CONNECTION

- PORTIONS OF EXISTING 6" AC WATER MAIN SHALL BE REMOVED TO ALLOW FOR CONNECTION
 - 1-8" NIPPLE, 24" LENGTH
 - 1-8" GATE VALVE & BOX
- ALONG HAMLET STREET:
 - 1-8"x8" TEE, MJ, BLOCKED
 - 4-8" NIPPLES, 24" LENGTH
 - 2-8" GATE VALVES & BOX
 - 2-8"x6" REDUCERS, MJ
 - 2-6" NIPPLES, LENGTH AS REQUIRED
 - 2-6" COUPLING
- ALONG LULL STREET:
 - 1-8"x8" TEE, MJ, BLOCKED
 - 4-8" NIPPLES, 24" LENGTH
 - 2-8" GATE VALVES & BOX
 - 2-8"x6" REDUCERS, MJ
 - 2-6" NIPPLES, LENGTH AS REQUIRED
 - 2-6" COUPLING

STA. 0+26 HYDRANT ASSEMBLY



- 1-8"x6" ANCHORING TEE, MJ, BLOCKED
- 1-6" GATE VALVE WITH BOX
- 1-6" NIPPLE, LENGTH AS REQUIRED
- 1-6" HYDRANT, BLOCKED

STA. 2+89 HYDRANT ASSEMBLY

- 1-8"x6" ANCHORING TEE, MJ, BLOCKED
- 1-6" GATE VALVE WITH BOX
- 1-6" NIPPLE, LENGTH AS REQUIRED
- 1-6" HYDRANT, BLOCKED
- 1-8" NIPPLE, 36" LENGTH
- 1-8" CAP, MJ, BLOCKED

RECORD PLAN

THIS RECORD PLAN WAS PREPARED BASED ON LIMITED INFORMATION GATHERED DURING CONSTRUCTION OF THE PROJECT AND INDICATES ONLY SIGNIFICANT CHANGES MADE FROM THE DESIGN PLANS DURING CONSTRUCTION.

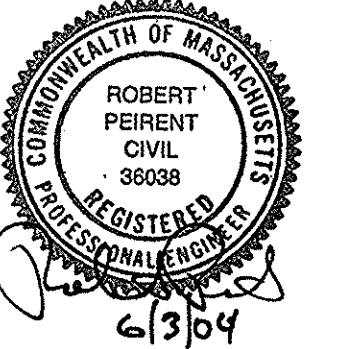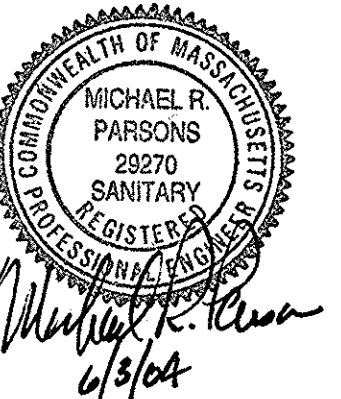

FY2004
Water
Improvements

Department of
Public Works

East Longmeadow,
Massachusetts

1	1/05	RECORD PLAN
Mark	Date	Description
PROJECT NO:	E0451-3-02	
FILE:	E0451/KellHamC002	
DRAWN BY:	TMF	
CHECKED:	SMS	
APPROVED BY:	RP, MRP	
HAMLET STREET, KELSEY AVENUE, NELSON STREET		
SCALE:	1" = 40'	
SHEET 6 OF 9		