


TOWN OF EAST LONGMEADOW, MASSACHUSETTS

BOARD OF PUBLIC WORKS

SOMERS ROAD HIGH SERVICE WATER MAIN REPLACEMENT

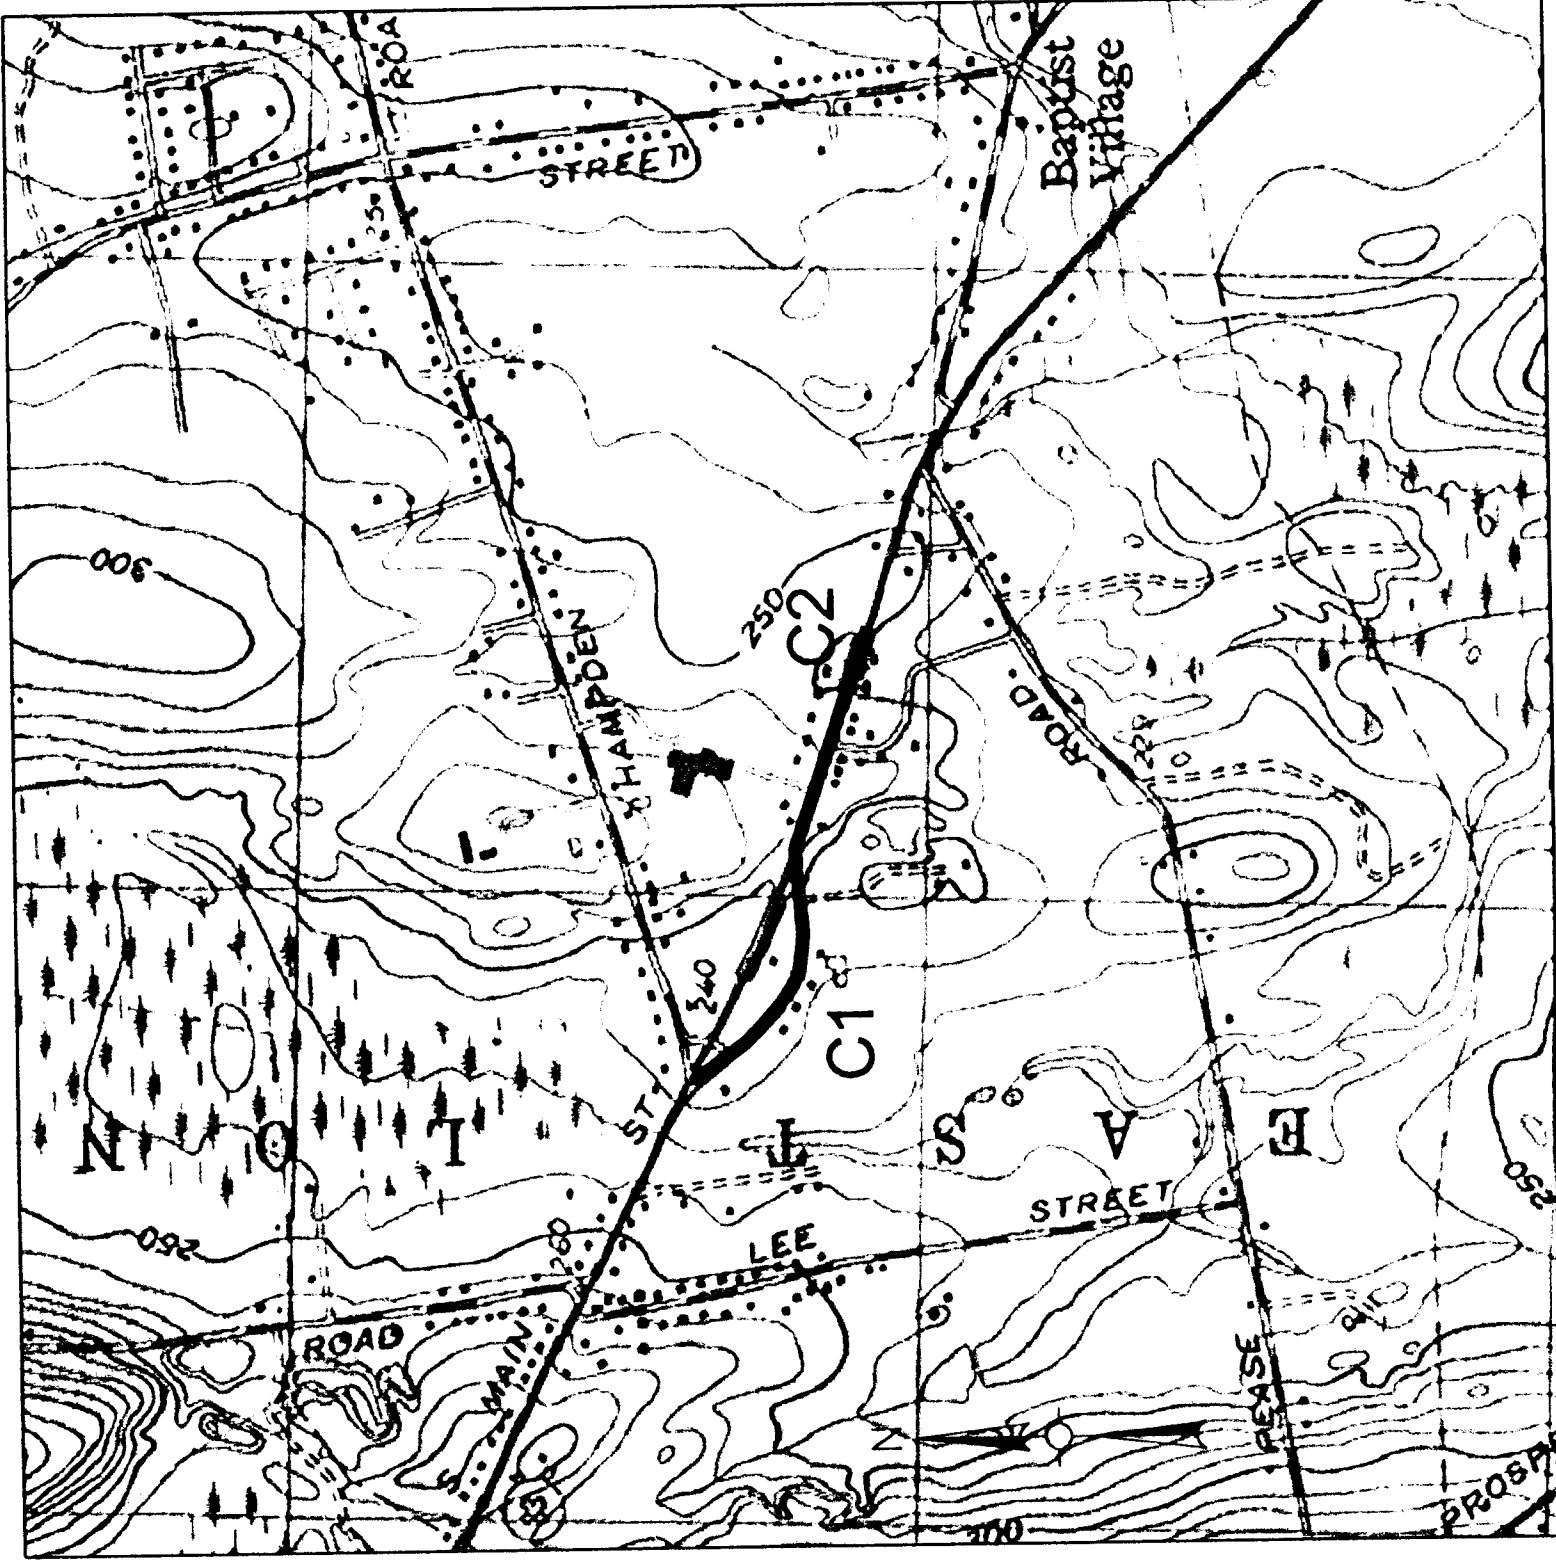


LOCATION MAP
SCALE: 1"=1000'

DRAWING INDEX

<u>SHEET NO.</u>	<u>TITLE</u>
G-1	ABBREVIATIONS, NOTES, AND LEGEND
C-1	SOUTH BEND ROAD - STATION 0+00 TO 14+80 SOMERS ROAD - STATION 0+00 TO 7+65
C-2	SOMERS ROAD - STATION 7+65 TO 11+47 DETAILS
C-3	DETAILS

JUNE 2000

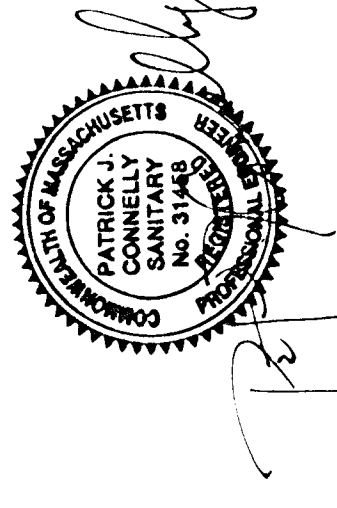

**WESTON & SAMPSON
ENGINEERS, INC.**

Five Centennial Drive, Peabody, Massachusetts 01960

RECORD DRAWING