
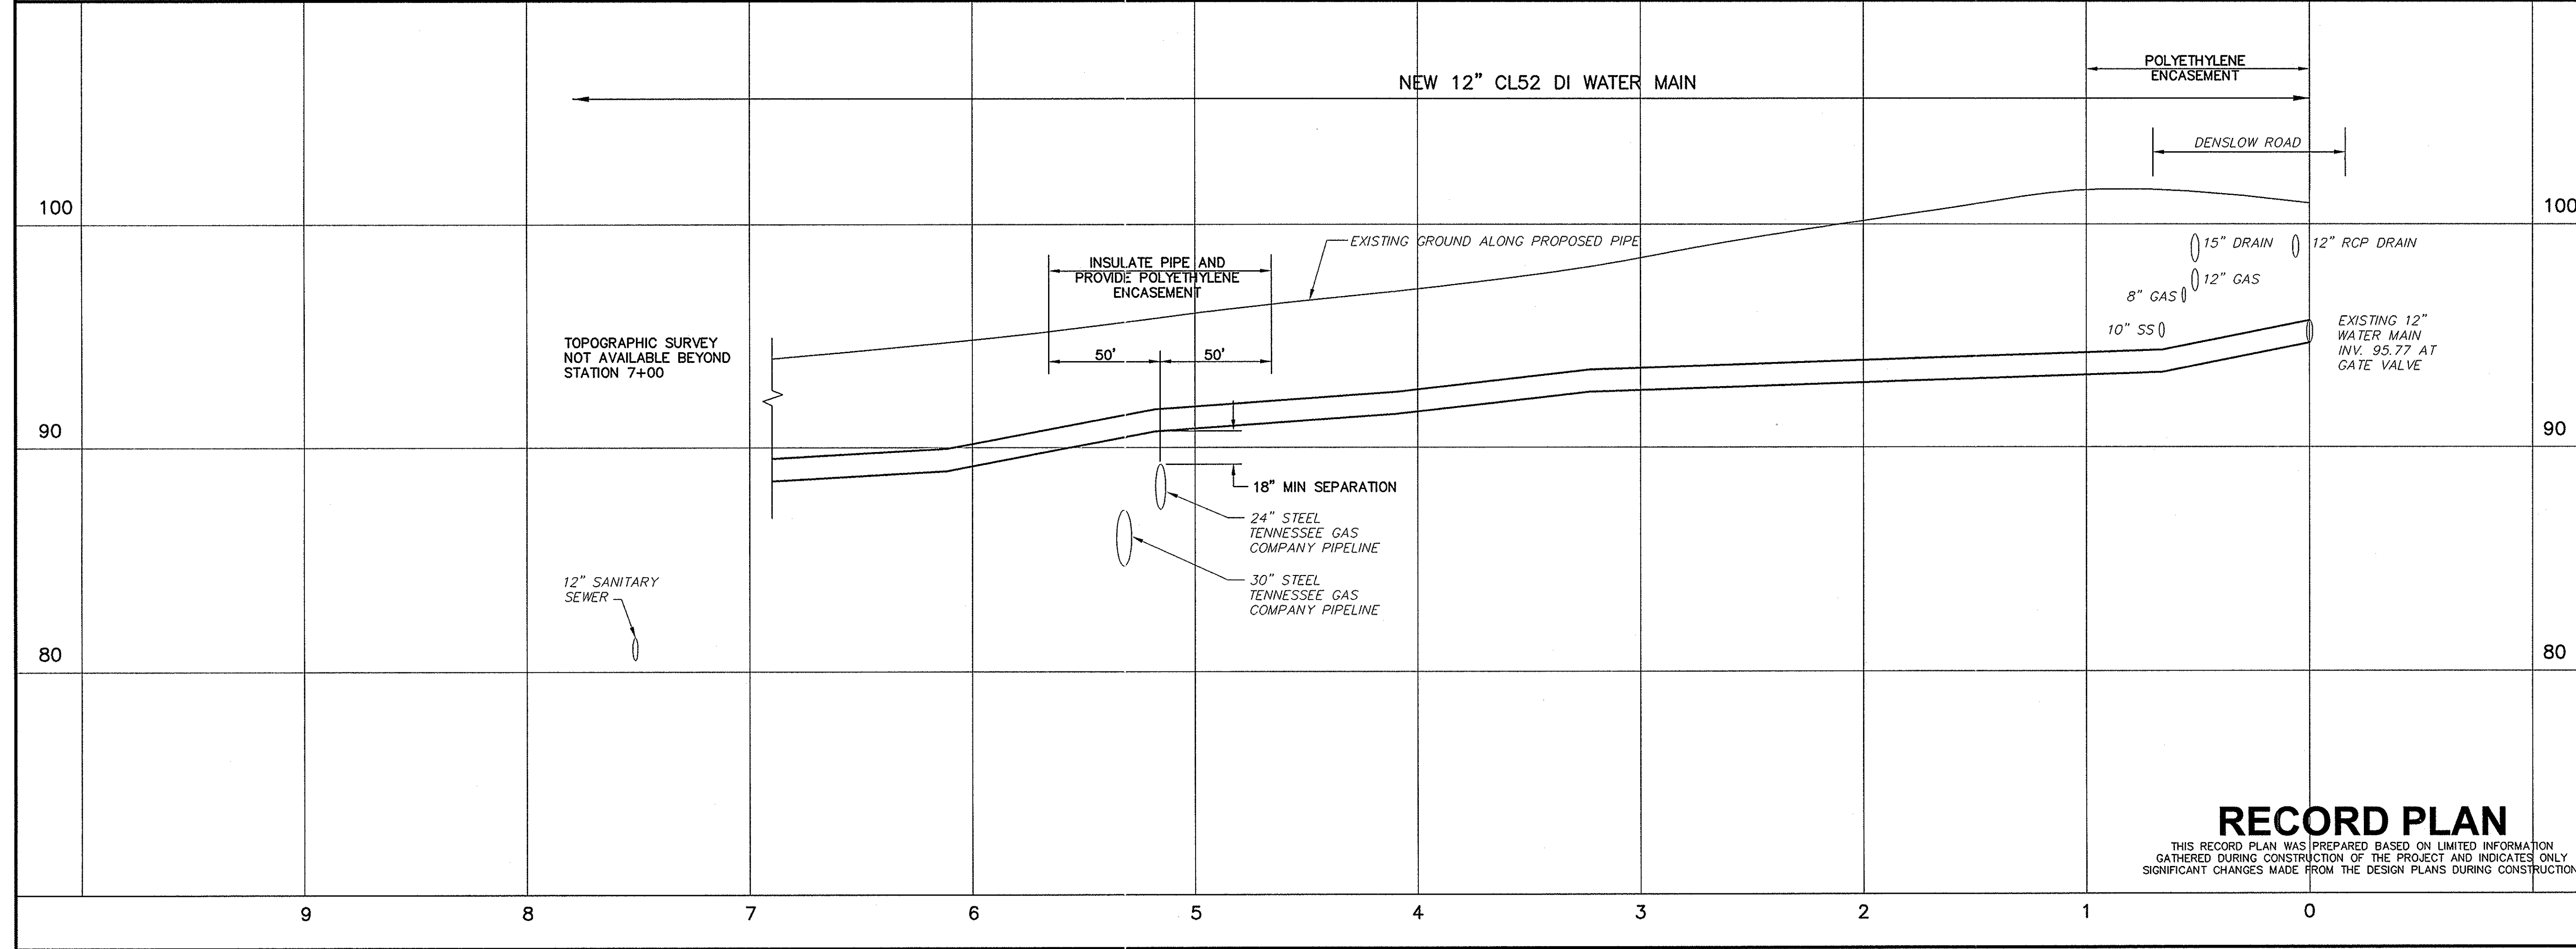
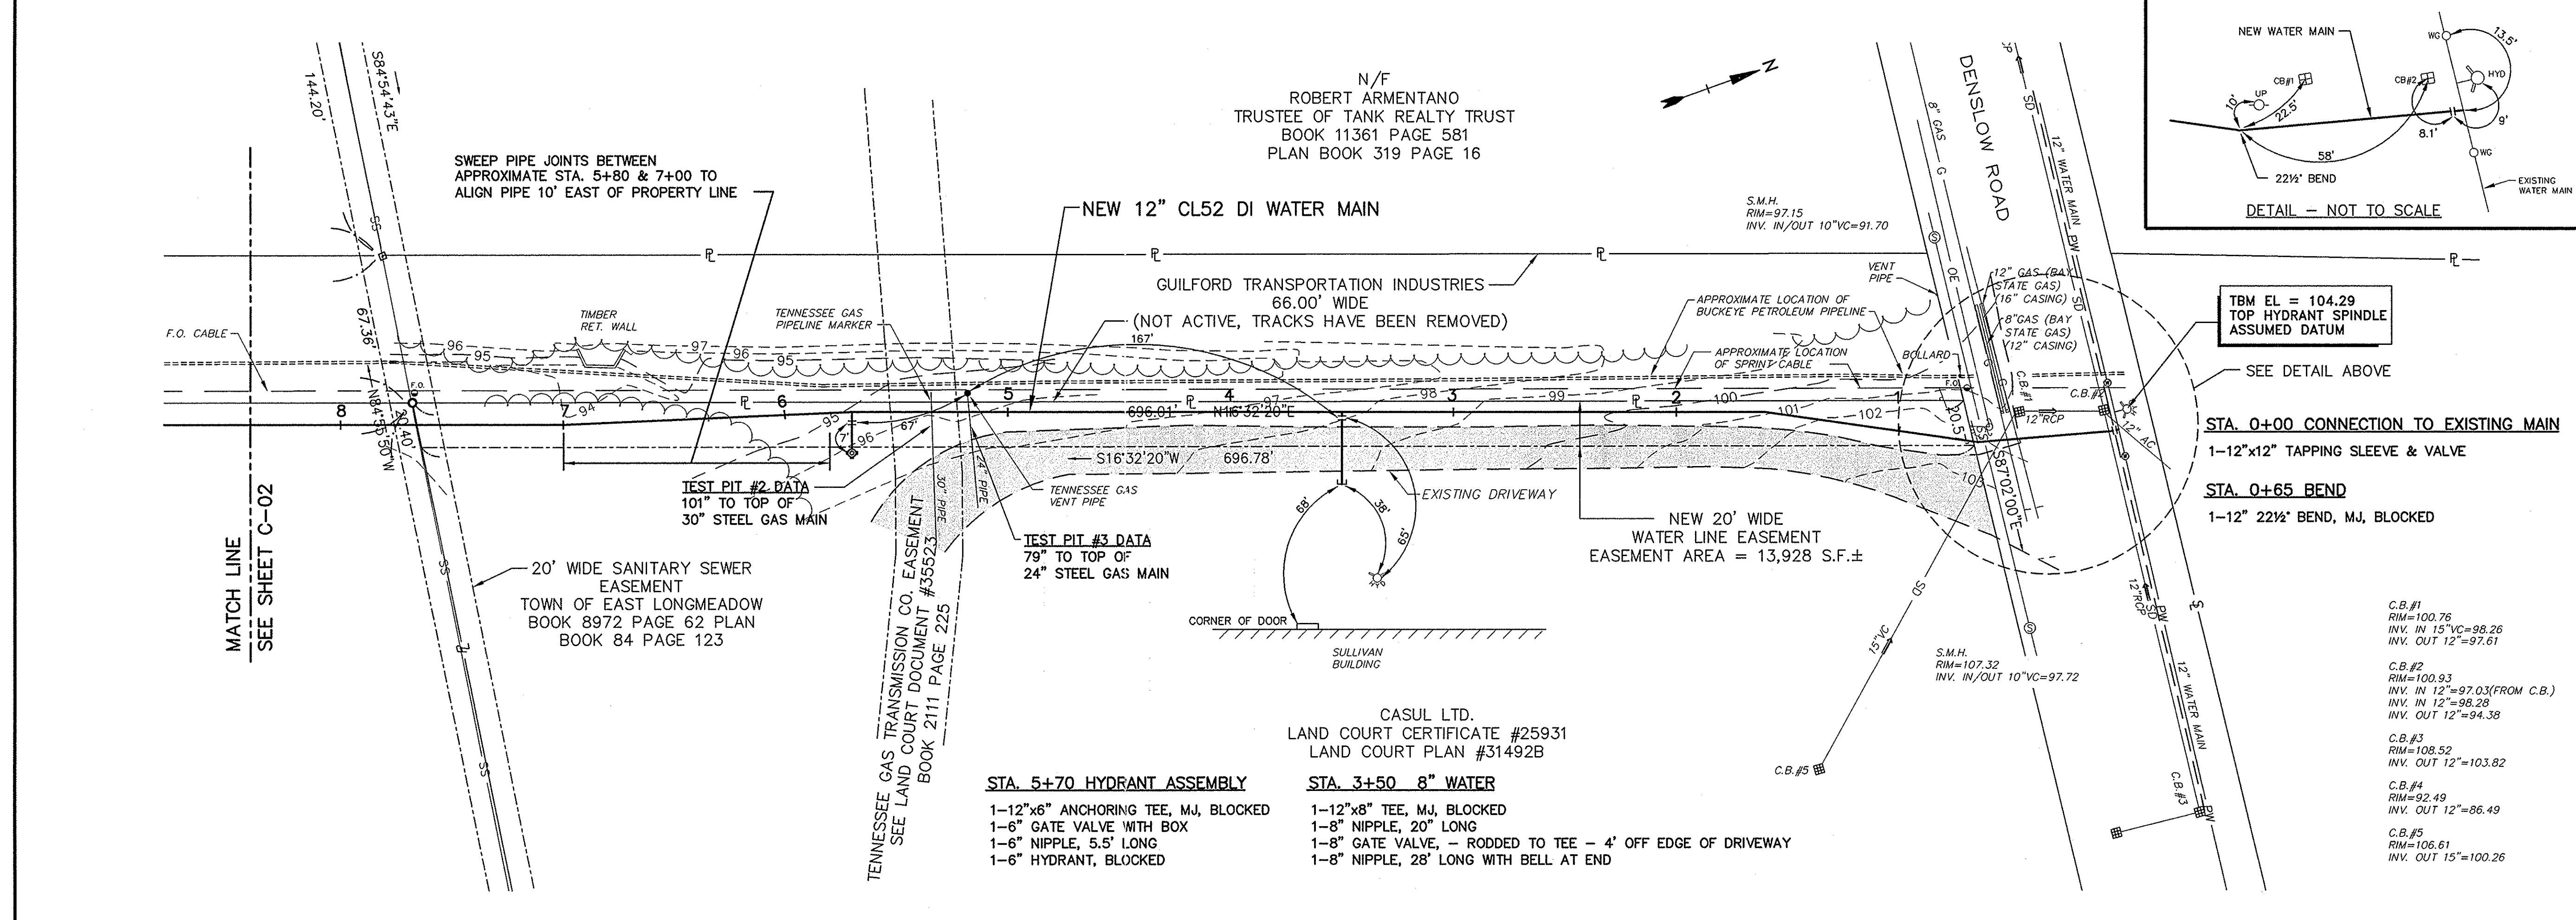
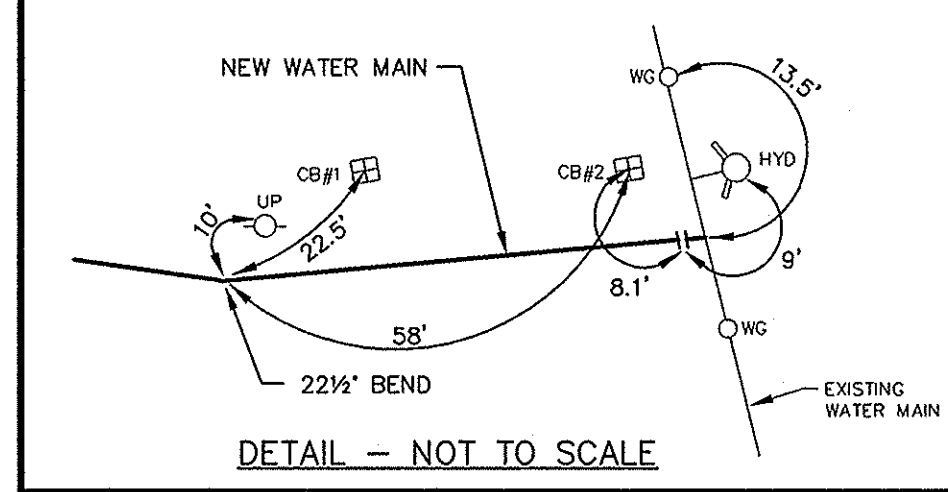


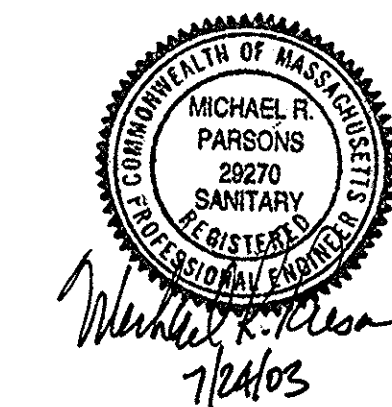

**Westmass Area
Development
Corporation**

**New Water
Main Extension**

East Longmeadow,
Massachusetts

Mark	Date	Description
1	7/04	RECORD PLAN

PROJECT NO:	E0469/2
FILE:	E0469/SHEET1AND2
DRAWN BY:	TMF
CHECKED:	EGB
APPROVED BY:	MRP

RECORD PLAN

THIS RECORD PLAN WAS PREPARED BASED ON LIMITED INFORMATION GATHERED DURING CONSTRUCTION OF THE PROJECT AND INDICATES ONLY SIGNIFICANT CHANGES MADE FROM THE DESIGN PLANS DURING CONSTRUCTION.

STA. 0+00 TO STA. 8+00

SCALE: 1"=40' HORIZ. 1"=4' VERT.