


# FY 2007 WATER MAIN IMPROVEMENTS DEPARTMENT OF PUBLIC WORKS EAST LONGMEADOW, MASSACHUSETTS

MARCH 2007

## BOARD OF PUBLIC WORKS

JOHN F. MAYBURY, CHAIRMEN  
DANIEL S. BURACK  
MICHAEL A. PERKINS


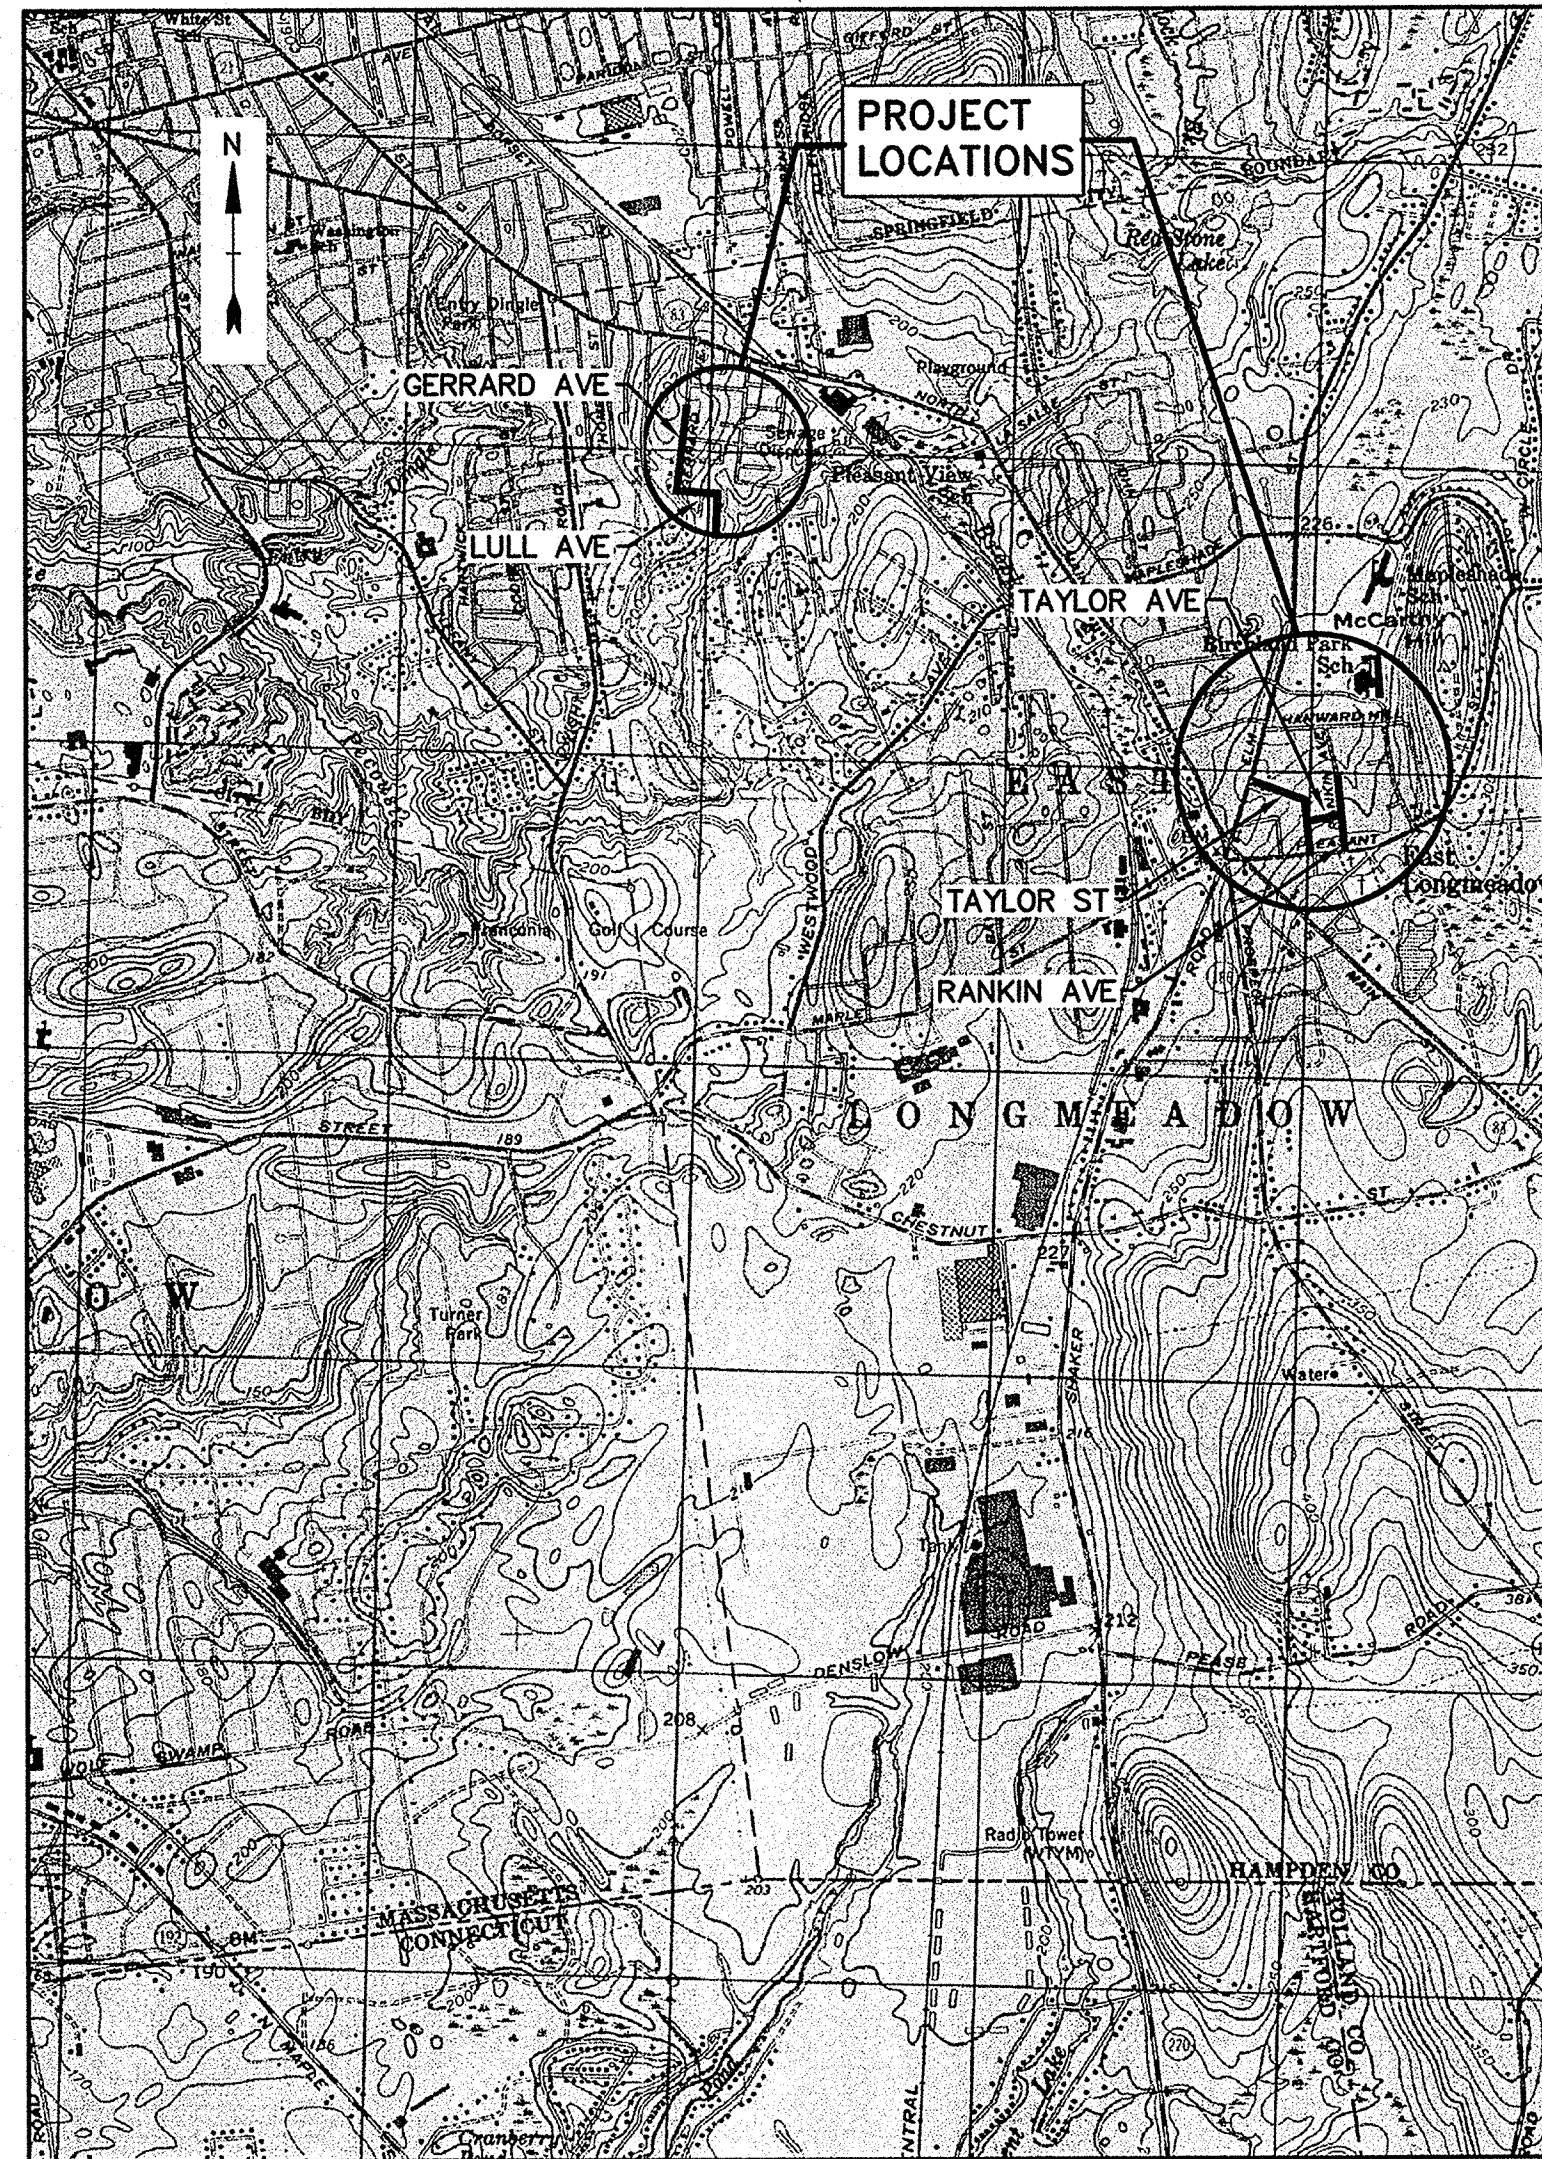


SCALE: 1:25000

## TOWN ENGINEER / DPW DIRECTOR

DAVID J. GROMASKI, P.E.

**Tighe & Bond**  
Consulting Engineers

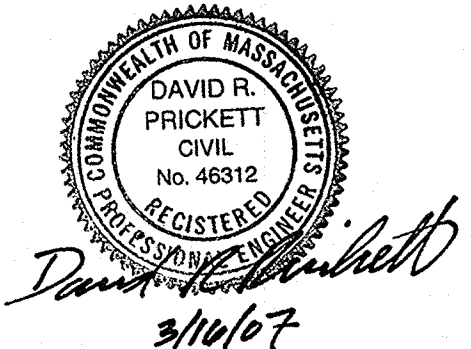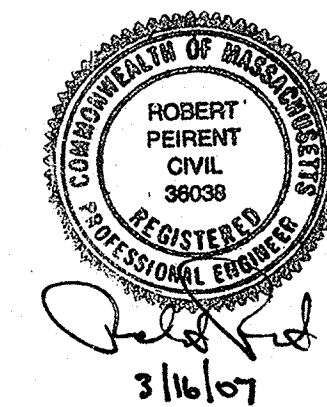

## RECORD PLAN

THIS RECORD PLAN WAS PREPARED BASED ON LIMITED INFORMATION  
GATHERED DURING CONSTRUCTION OF THE PROJECT AND INDICATES ONLY  
SIGNIFICANT CHANGES MADE FROM THE DESIGN PLANS DURING CONSTRUCTION.

COMPLETE SET 8 SHEETS