

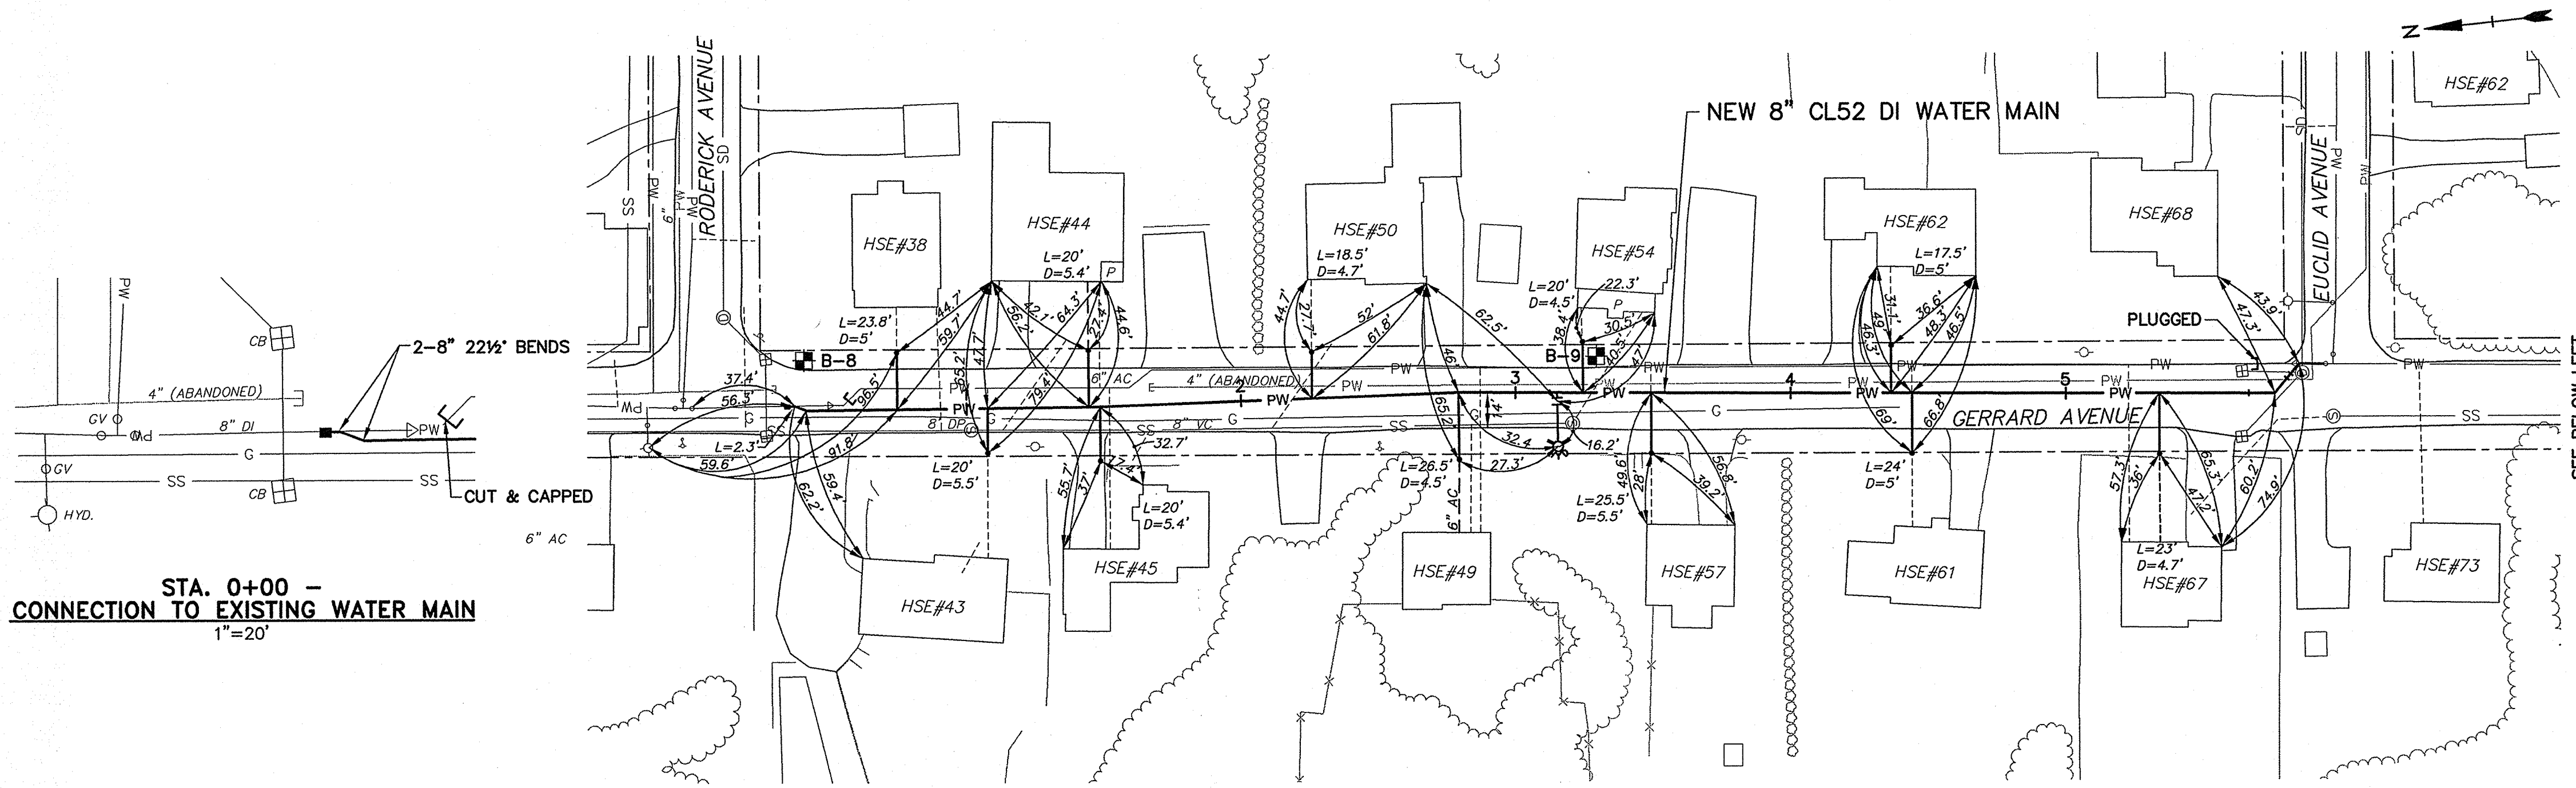
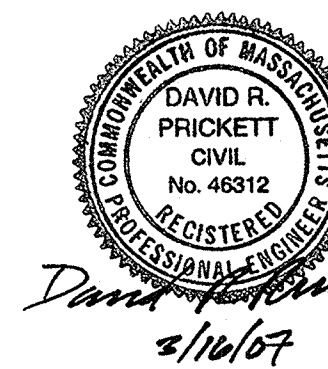


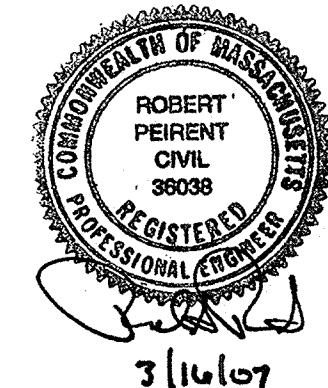



**STA. 0+00 -
CONNECTION TO EXISTING WATER MAIN**
1"=20'

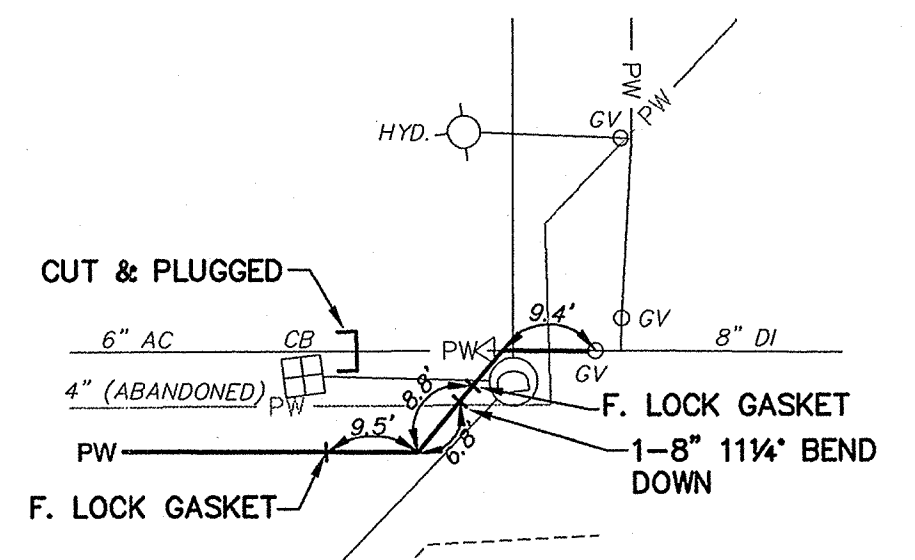

**STA. 5+50±-
CONNECTION TO EXISTING WATER MAIN**
1"=20'

1-8" 45° BEND, MJ, BLOCKED (TBD) 9.4' FROM G.V. - STA. 5+92.6
1-8" NIPPLE, 16' LONG
1-8" 45° BEND, MJ, BLOCKED (TBD)-STA. 5+76.0
NEW 8" DI WATER MAIN IS OVER 12" CONC DRAIN WITH 4.2' OF COVER

STA. 3+15 HYDRANT:
INSTALLED HYDRANT ASSEMBLY AT HIGH POINT ON WATER MAIN
SEE DETAIL 1/6

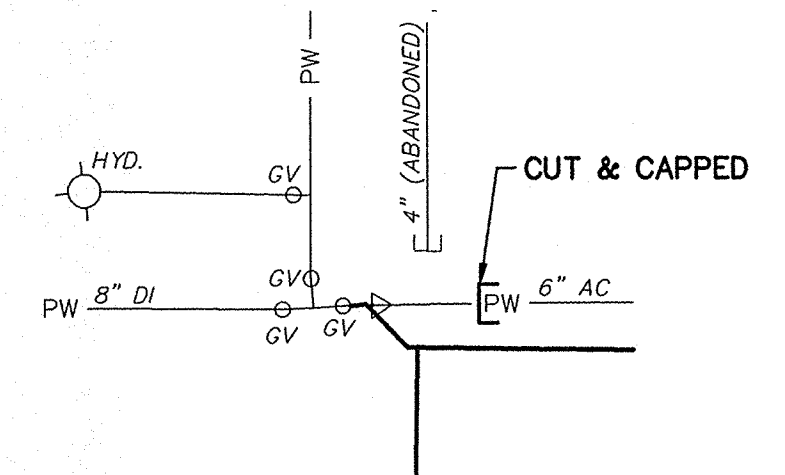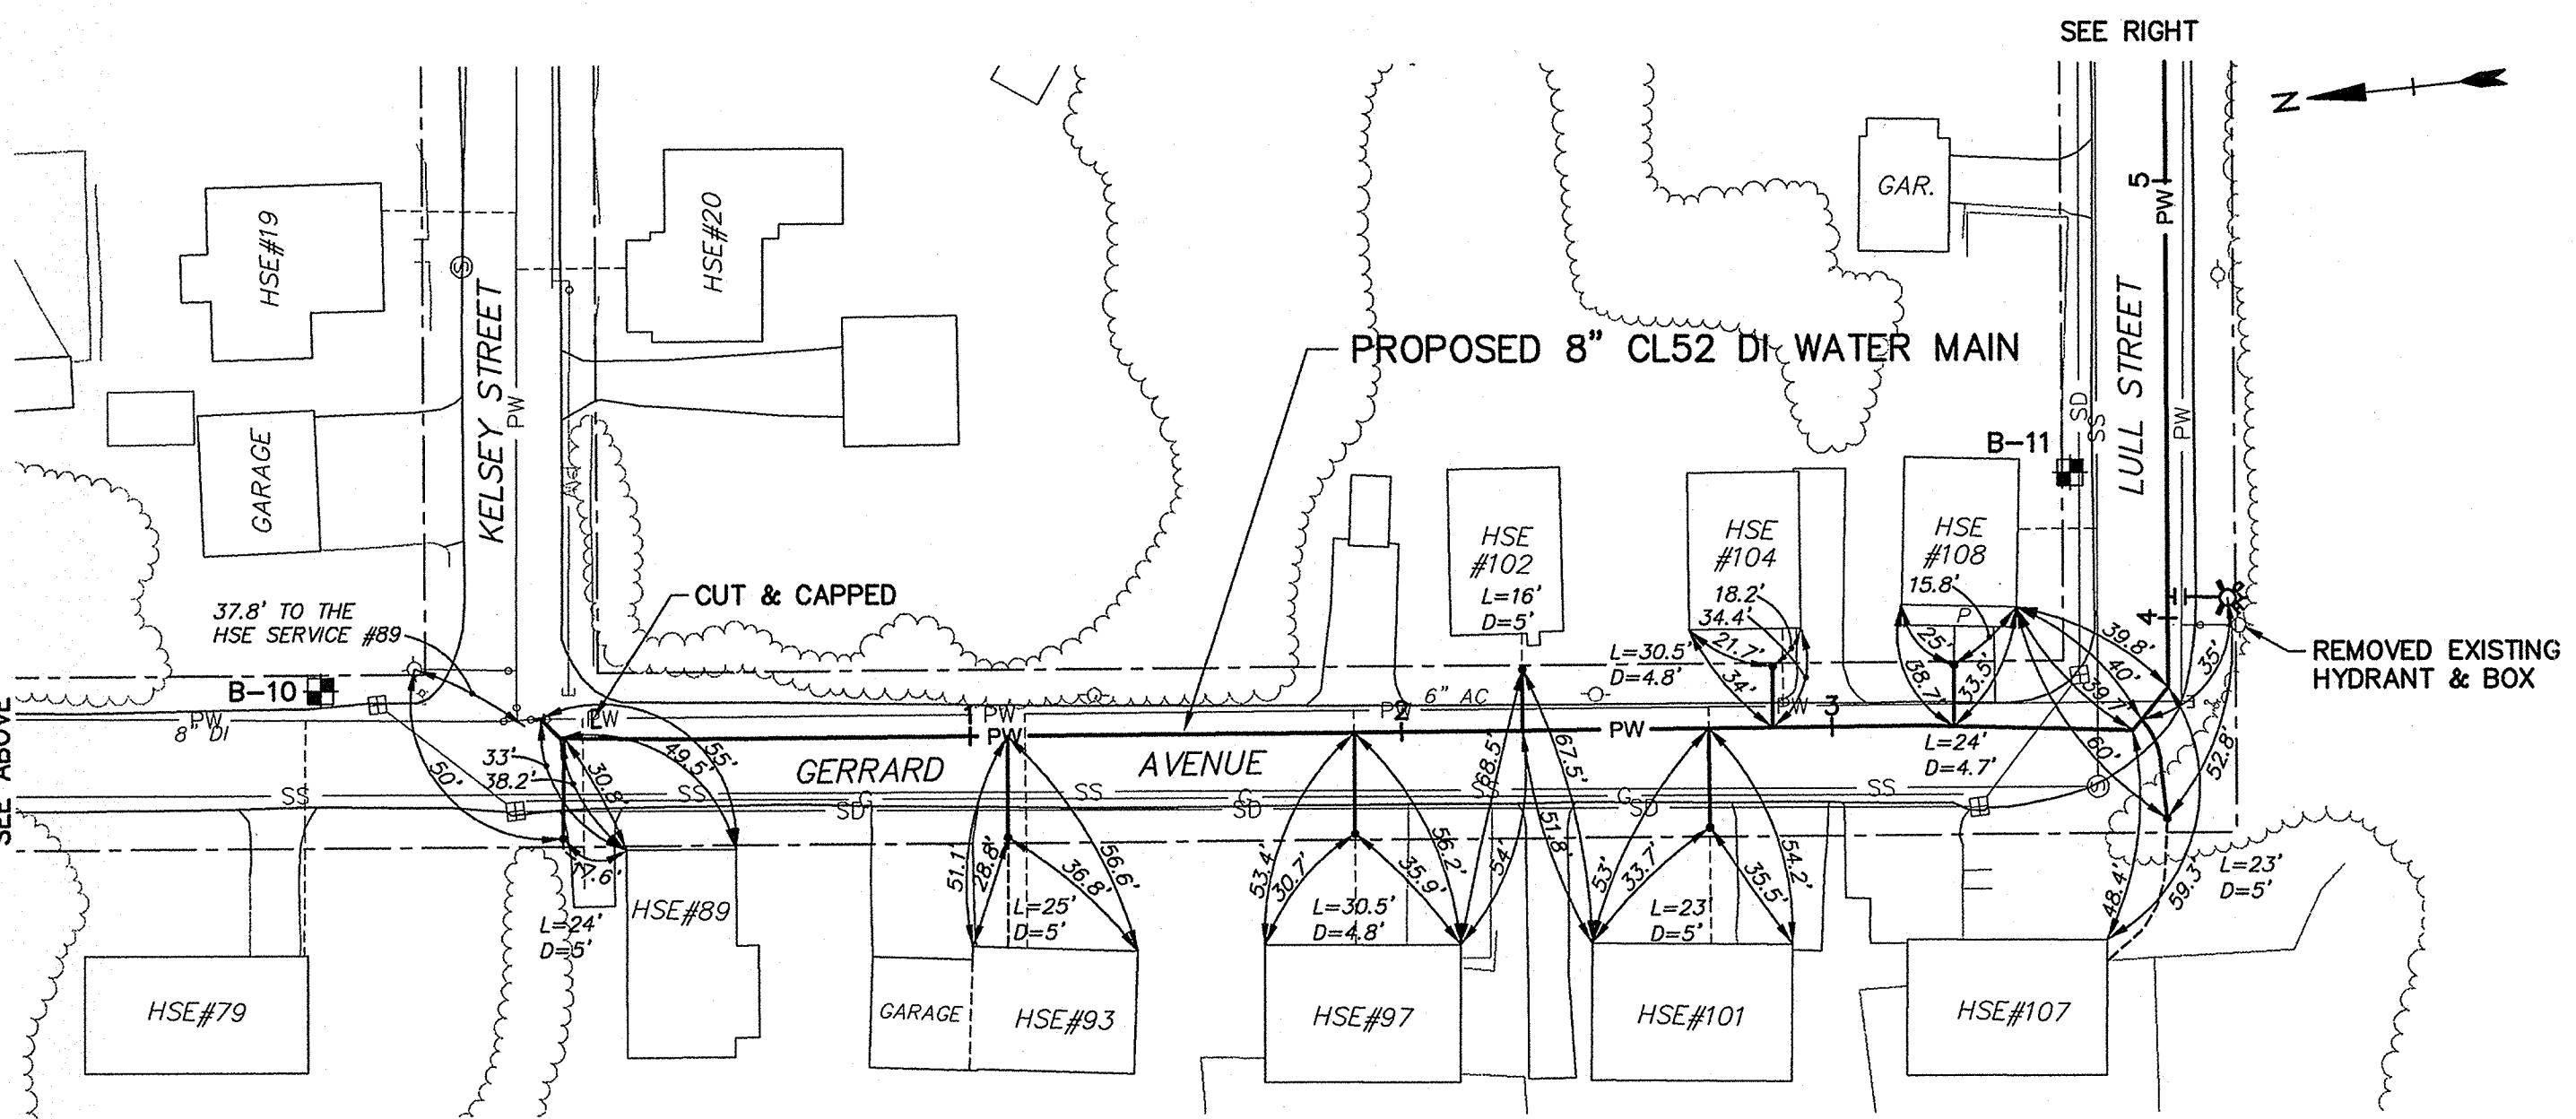

**STA. 0+00 -
CONNECTION TO EXISTING WATER MAIN**
1"=20'


EXCAVATED TO AND REMOVED ALL PIPE TO GATE VALVE OF EXISTING WATER MAIN AND FROM EXISTING GATE VALVE INSTALLED:
1-8" NIPPLE, 1.8' (GV TO FITTING)
1-8" 45° BEND, MJ, BLOCKED (TBD)
1-8" NIPPLE, 5.6' C TO C FITTINGS
1-8" 45° BEND, MJ, BLOCKED (TBD)
8" DI PIPE

STA. 3+69.5 BEND:
1-8" 45° BEND, MJ, BLOCKED (TBD)
STA. 3+83.3 BEND:
1-8" 45° BEND, MJ, BLOCKED (TBD) (6.0' COVER)
STA. 4+05 HYDRANT:
INSTALLED HYDRANT ASSEMBLY,
SEE DETAIL 1/6

RECORD PLAN



THIS RECORD PLAN WAS PREPARED BASED ON LIMITED INFORMATION GATHERED DURING CONSTRUCTION OF THE PROJECT AND INDICATES ONLY SIGNIFICANT CHANGES MADE FROM THE DESIGN PLANS DURING CONSTRUCTION.

STA. 7+80 BEND:
1-8" 45° BEND, MJ, BLOCKED (TBD)
STA. 8+14 BEND:
1-8" 45° BEND, MJ, BLOCKED (TBD)
STA. 8+20 HYDRANT:
INSTALL HYDRANT ASSEMBLY,
SEE DETAIL 1/6

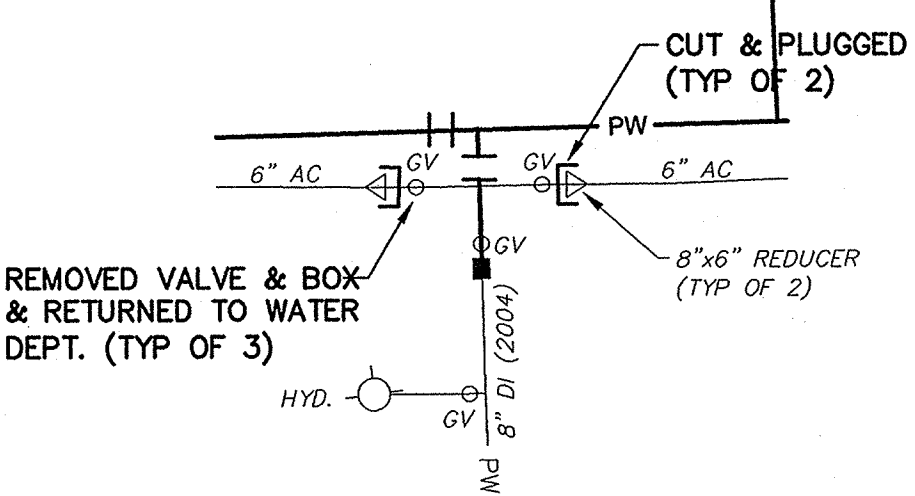

**STA. 6+10
HAMLET ST. - LULL ST. CONNECTION**
1"=20'

ALONG LULL ST. WESTERLY:
1-8" TEE
1-8" NIPPLE, 2' LONG
1-8" GATE VALVE & BOX
SOUTHERLY FROM TEE:
1-8" NIPPLE, 2' LONG
1-8" GATE VALVE & BOX
1-8" NIPPLE, 7.7' LPNG, PAST EXISTING GATE VALVE
1-8" SOLID SLEEVE

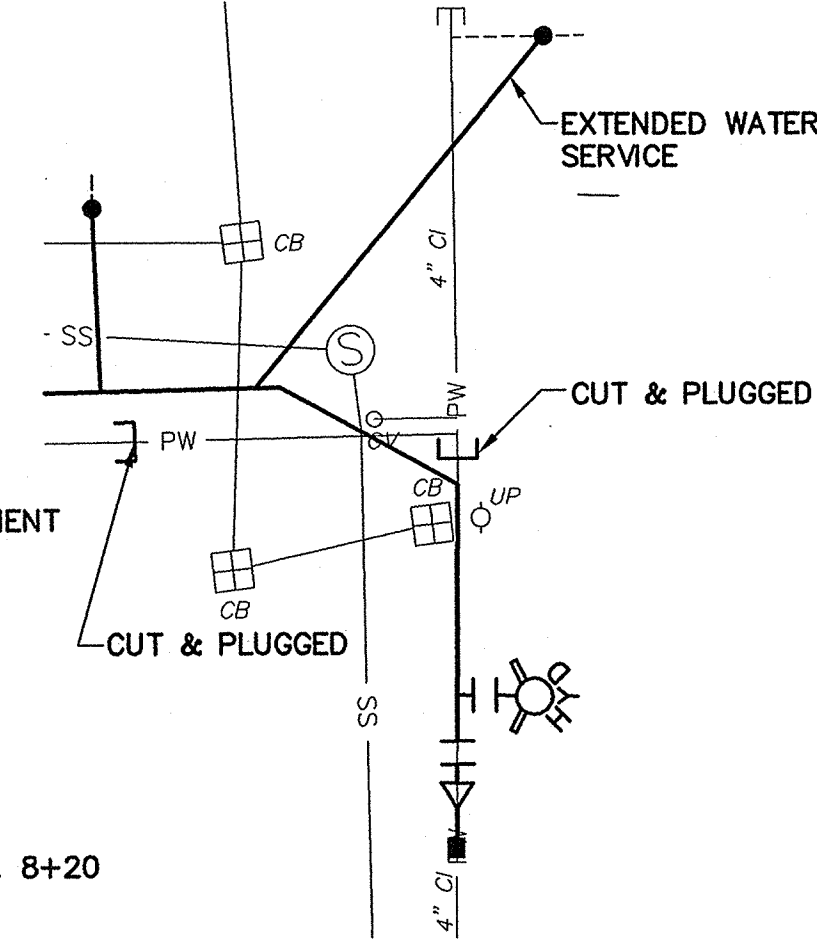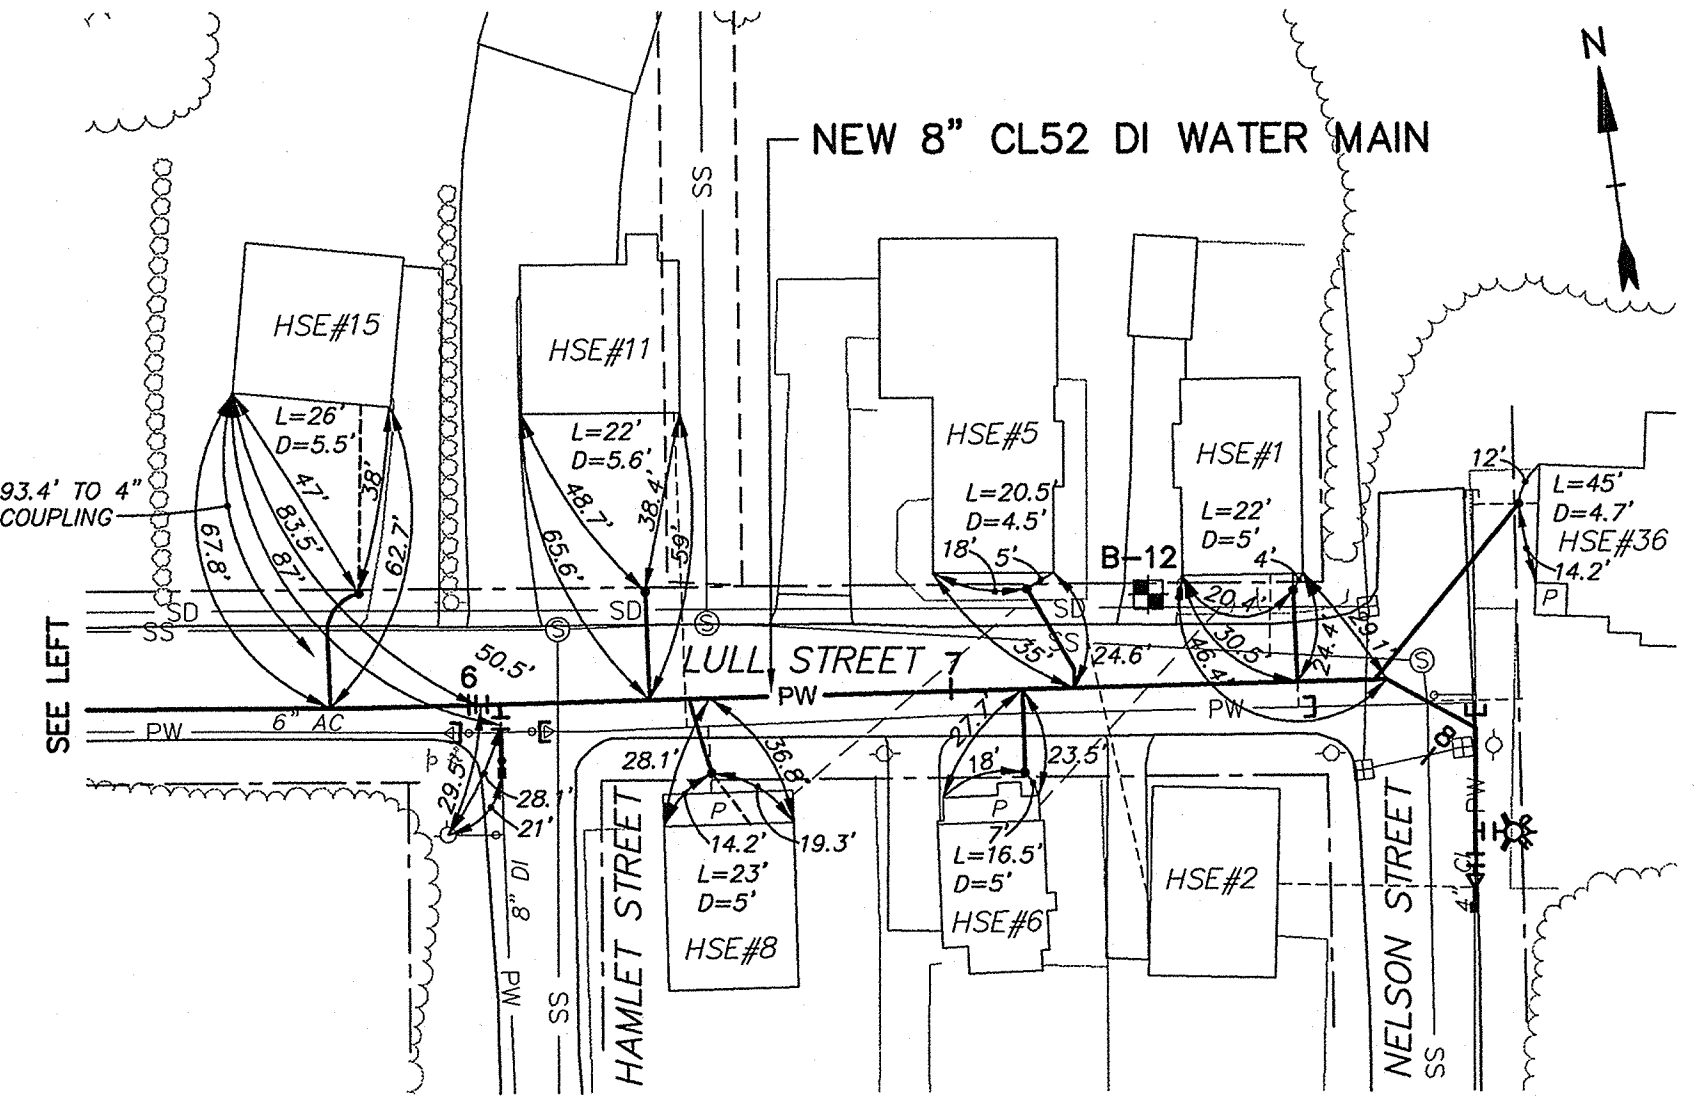

**STA. 8+37 -
CONNECTION TO EXISTING WATER MAIN**
1"=20'

EXCAVATED TO AND REMOVED SUFFICIENT LENGTH OF EXISTING WATER MAIN TO INSTALL NORTHERLY:
1-4" COUPLING
1-4" NIPPLE, 1' LONG
1-4"x8" INCREASER
1-8" NIPPLE, 3' LONG
1-8" GATE VALVE & BOX-STA. 8+25
1-8" NIPPLE, 4.5' LONG
1-TEE FOR HYDRANT ASSEMBLY-STA. 8+20

FY 2007 Water Main Improvements

Town of East Longmeadow

East Longmeadow,
Massachusetts

Mark	Date	Description
B	12/07	Record Plans
A	12/06	Initial Issue
Mark	Date	Description
PROJECT NO:	E526/1	
FILE:	SHEETS	
DRAWN BY:	LPT, RFB	
CHECKED:	SMS, DRP	
APPROVED BY:	RP	
GERRARD AVENUE - STA. 0+00 TO STA. 5+55		
GERRARD AVENUE/LULL STREET STA. 0+00 TO STA. 8+37		
SCALE:	1"=40'	