

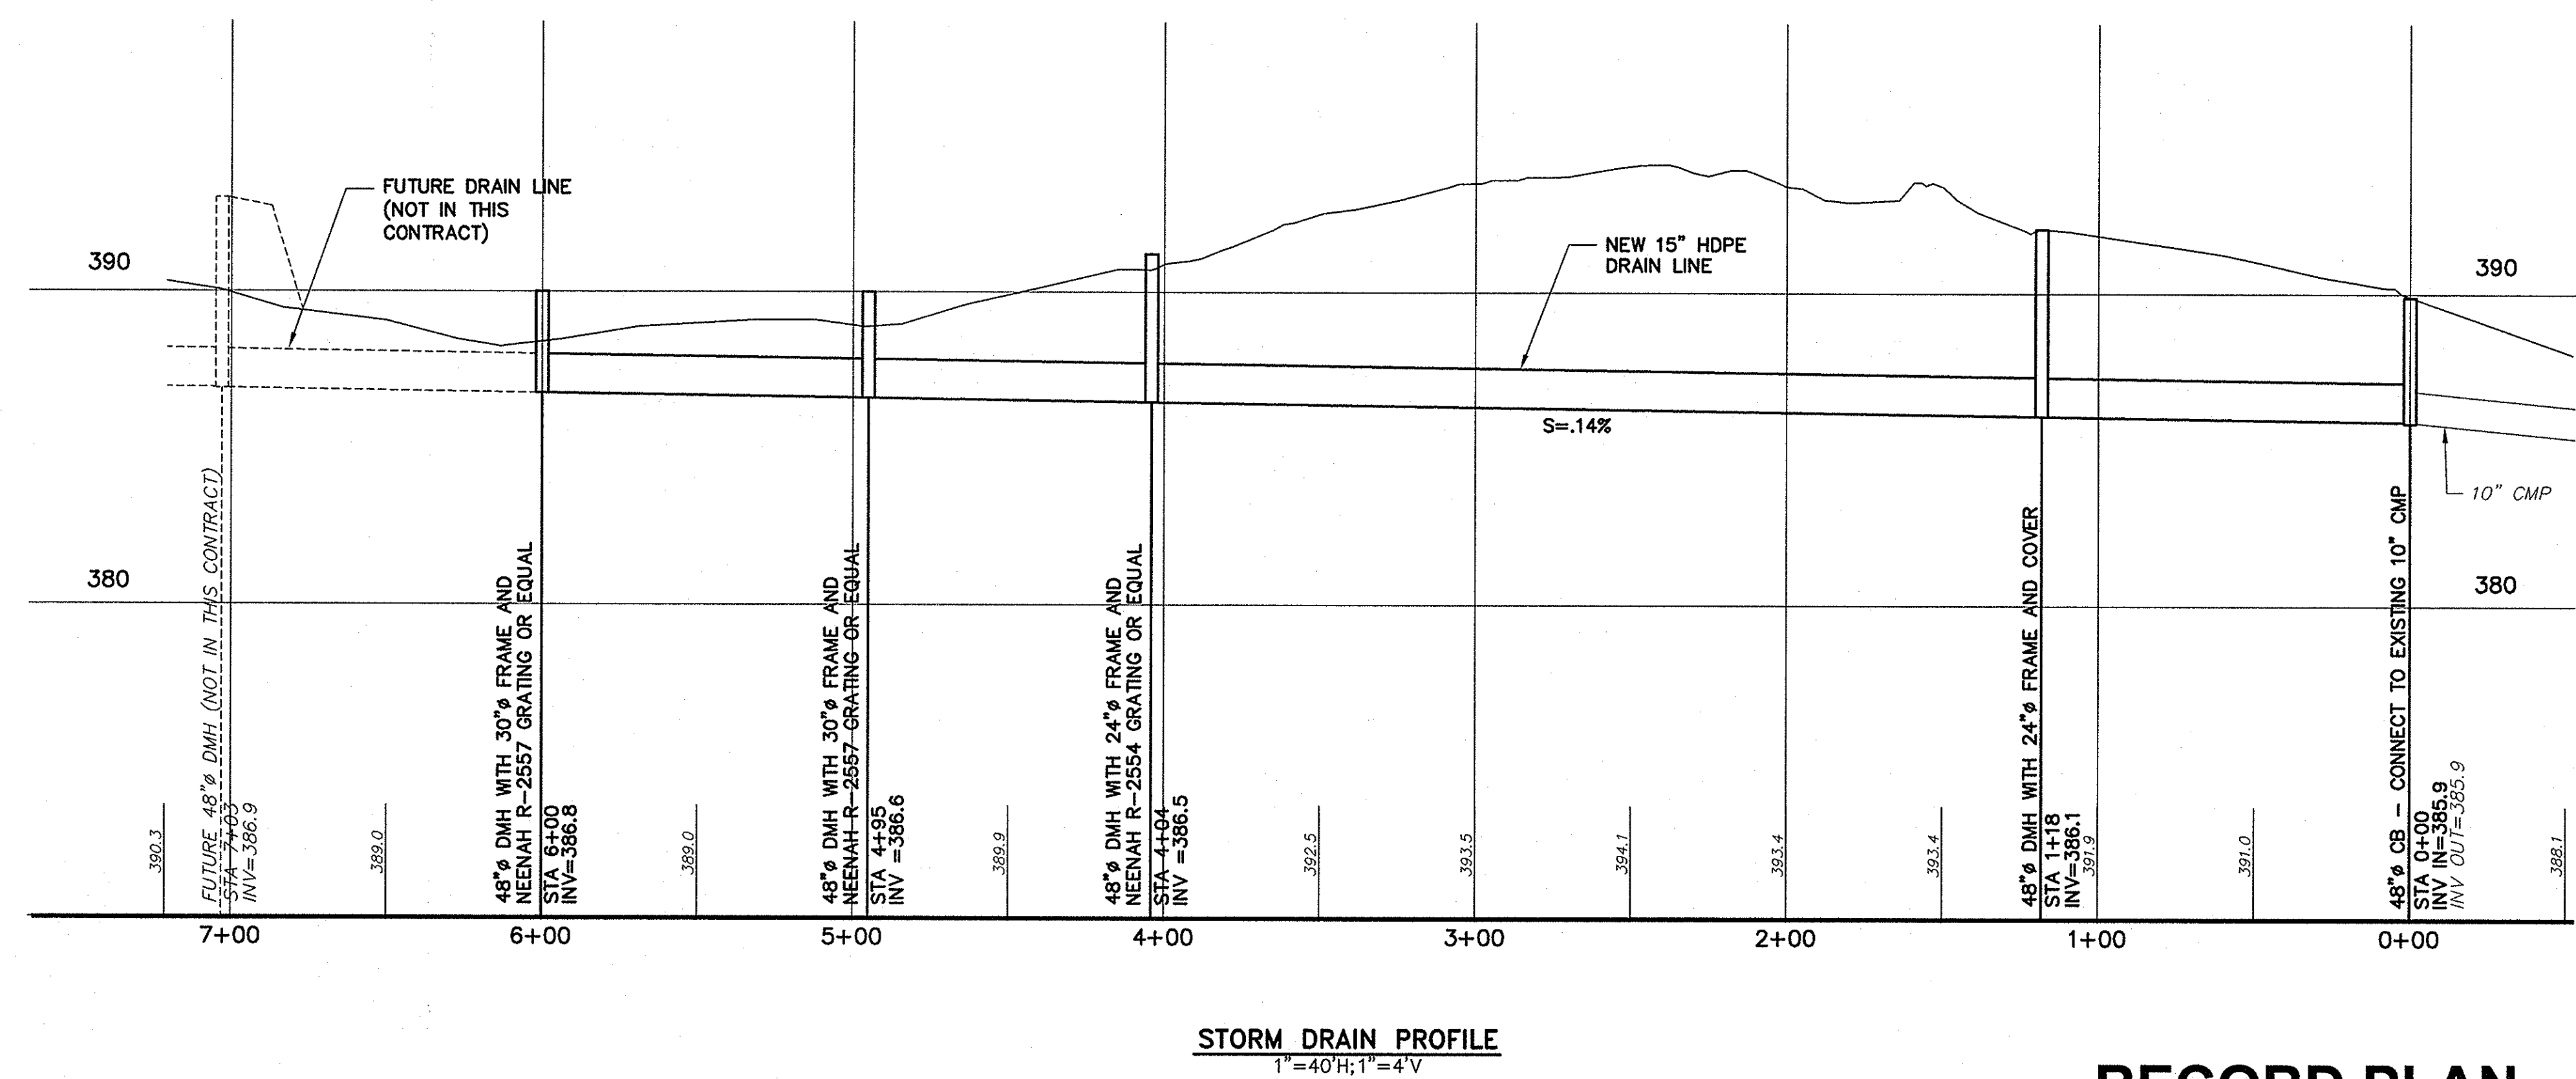
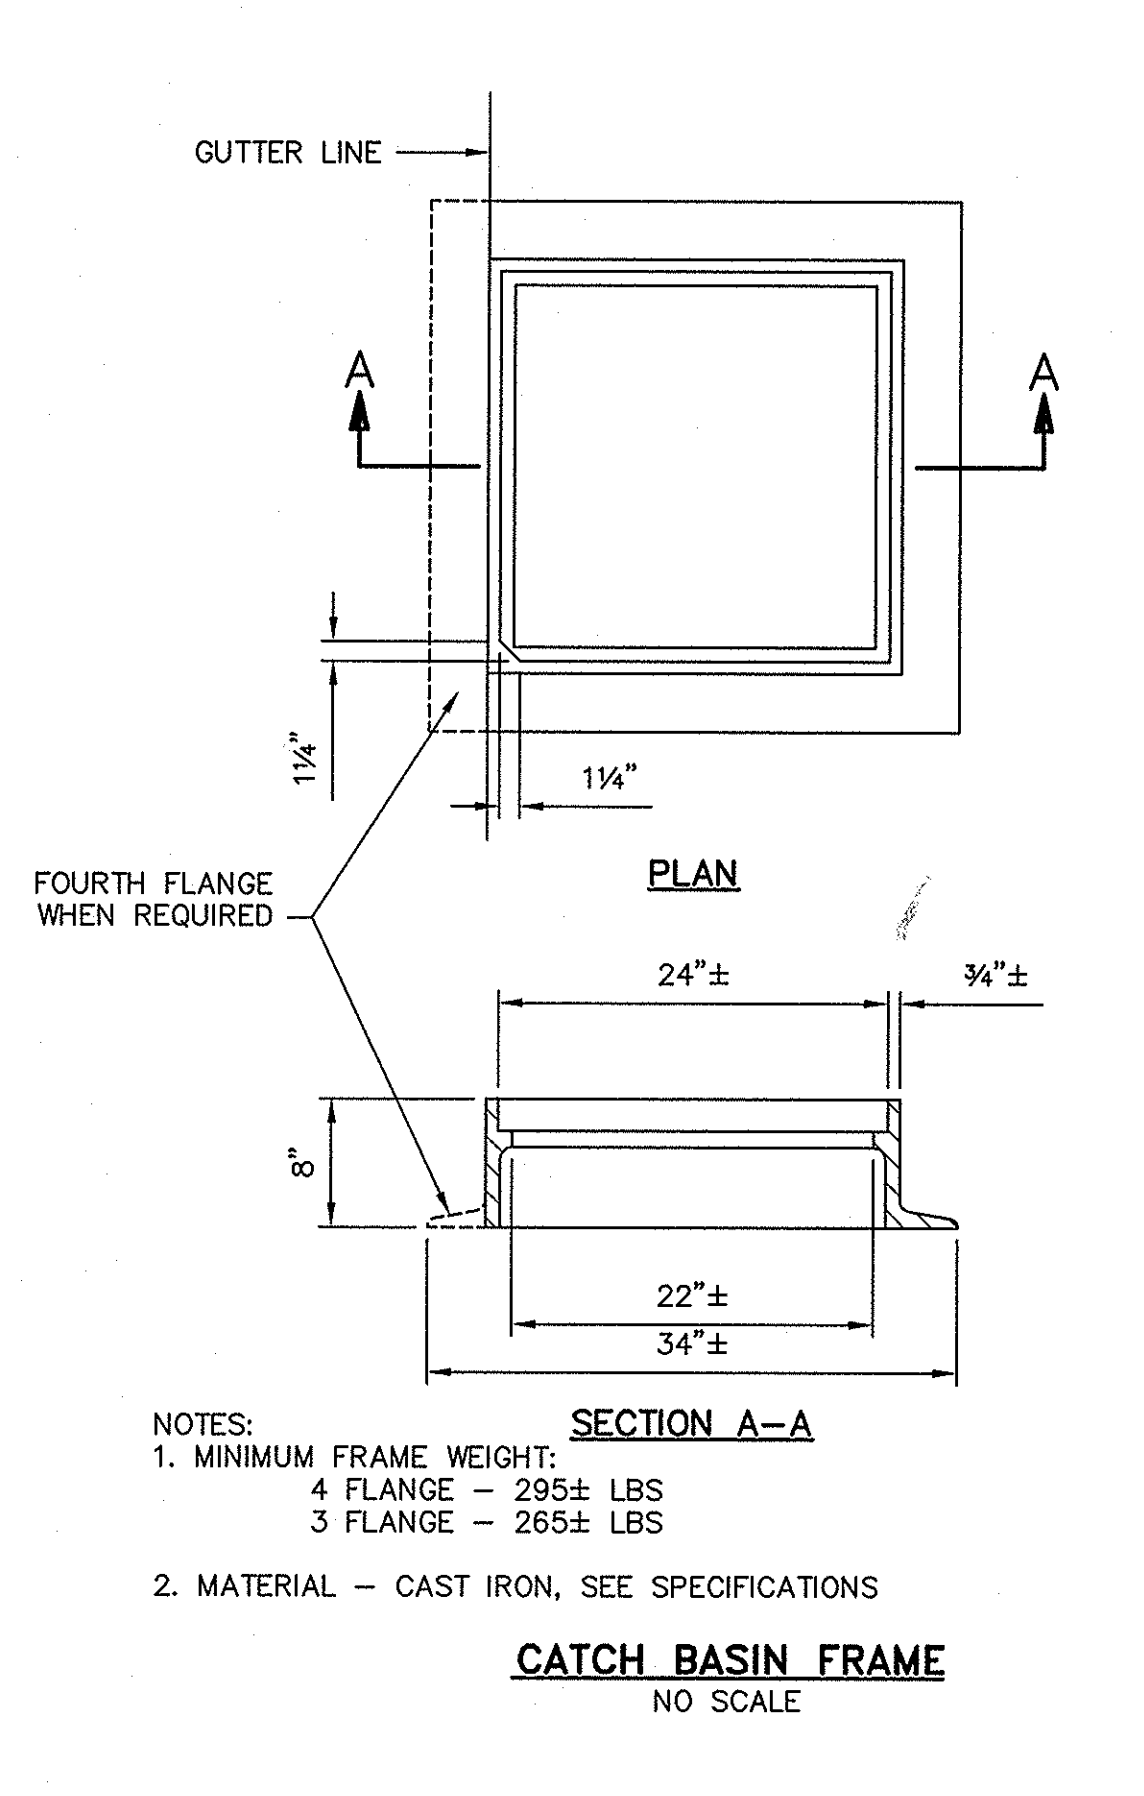
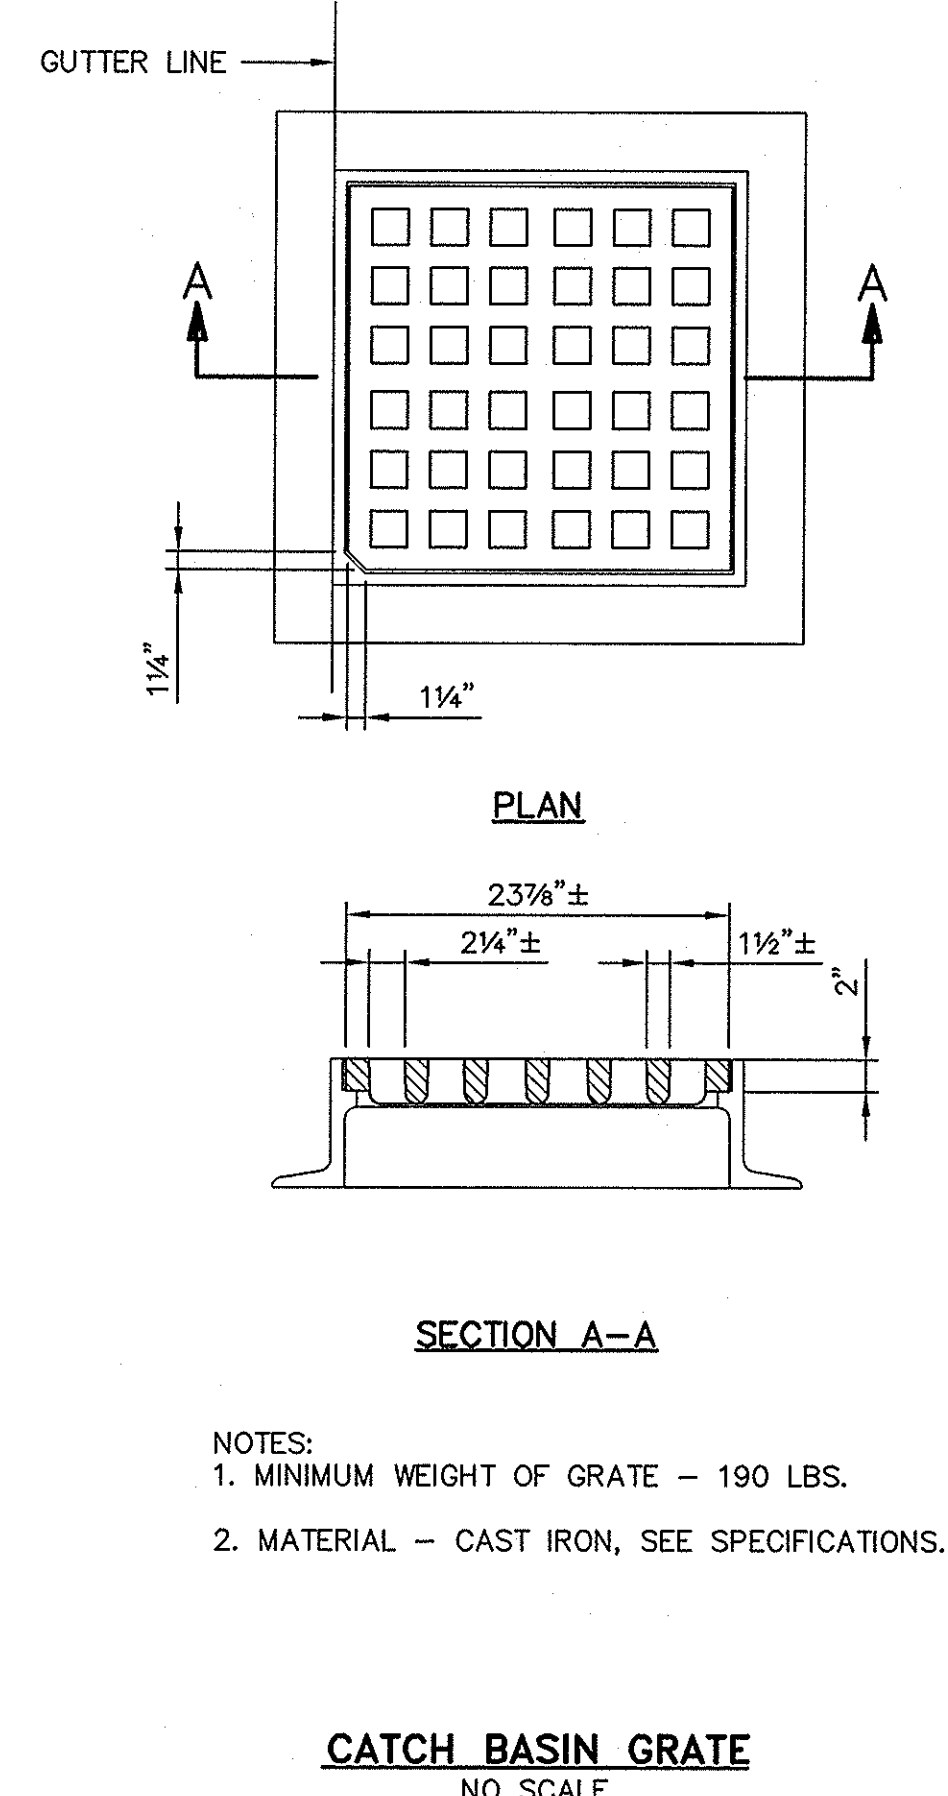
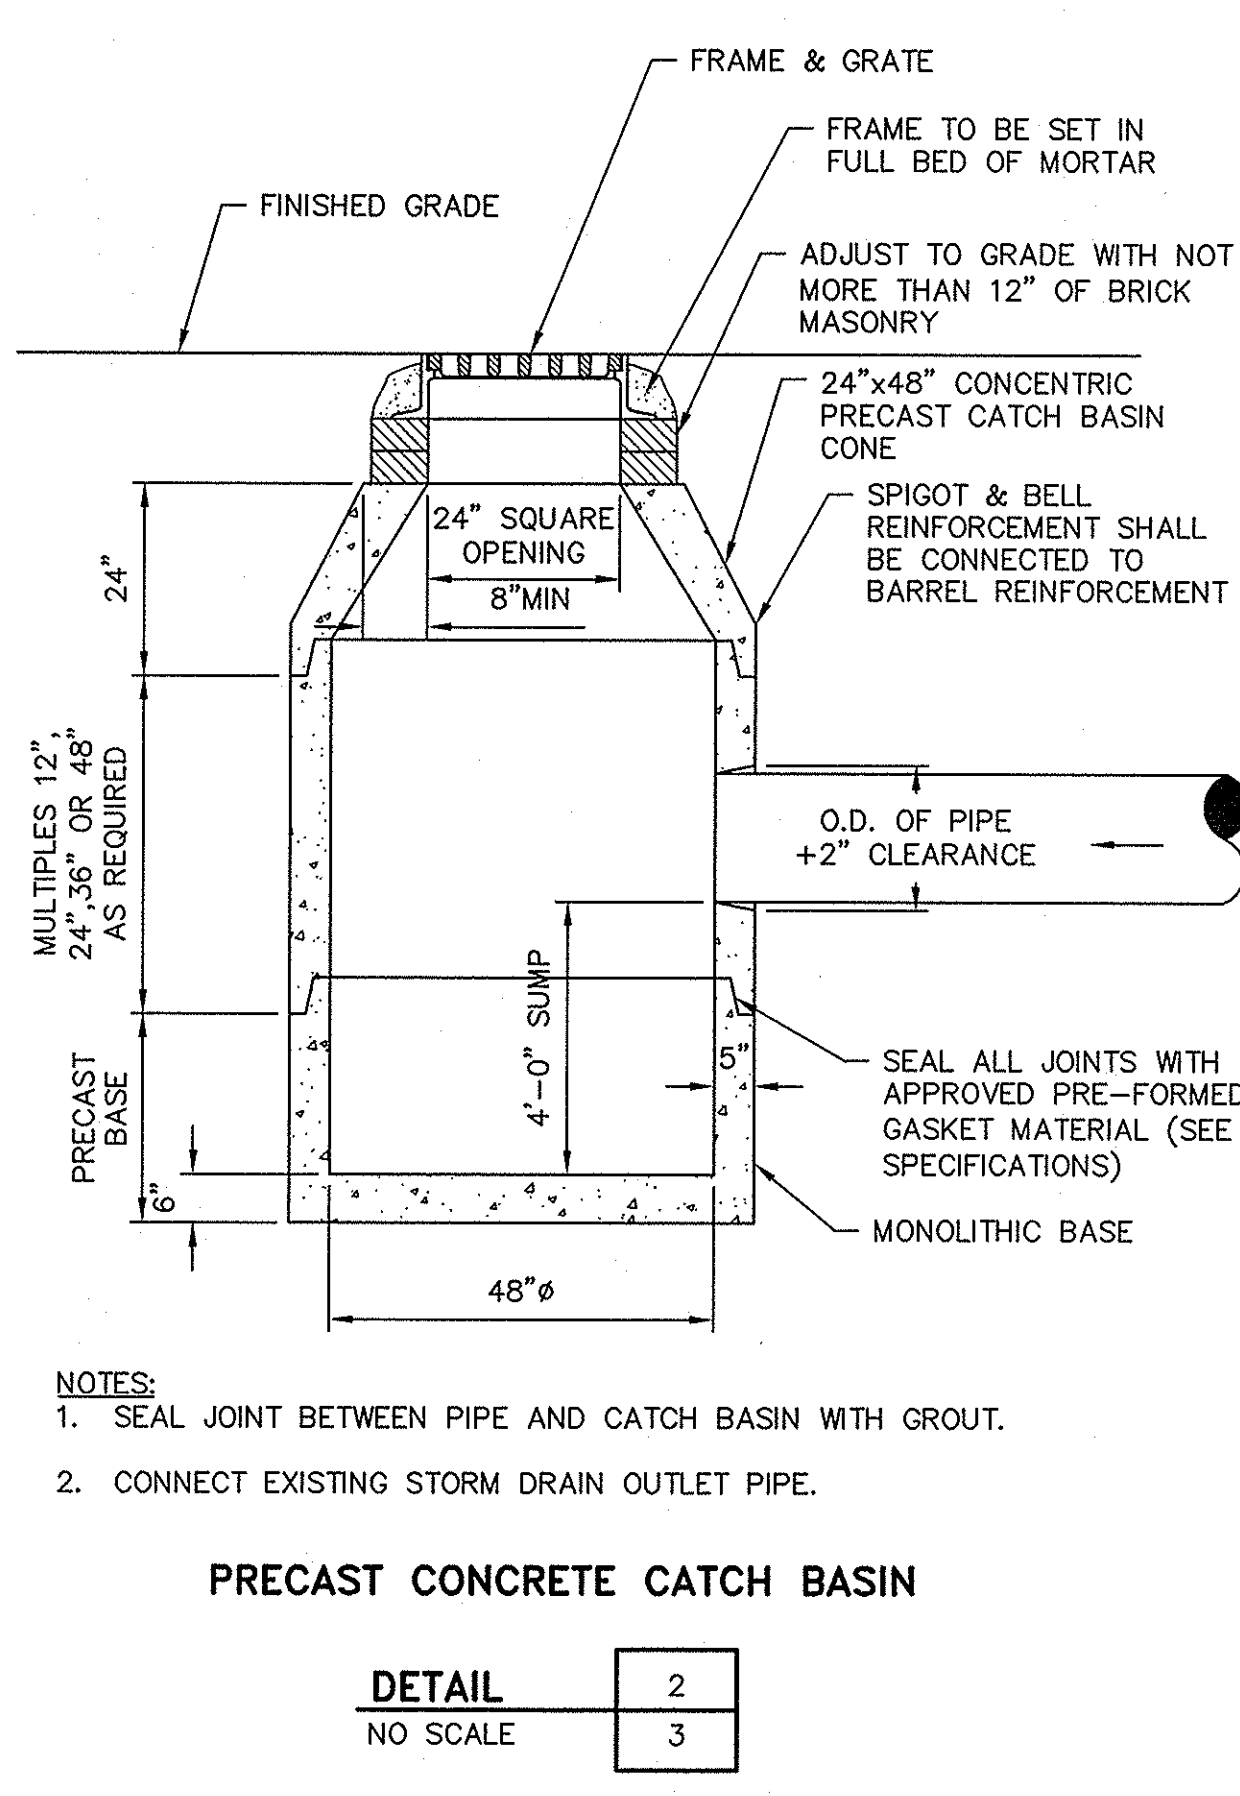
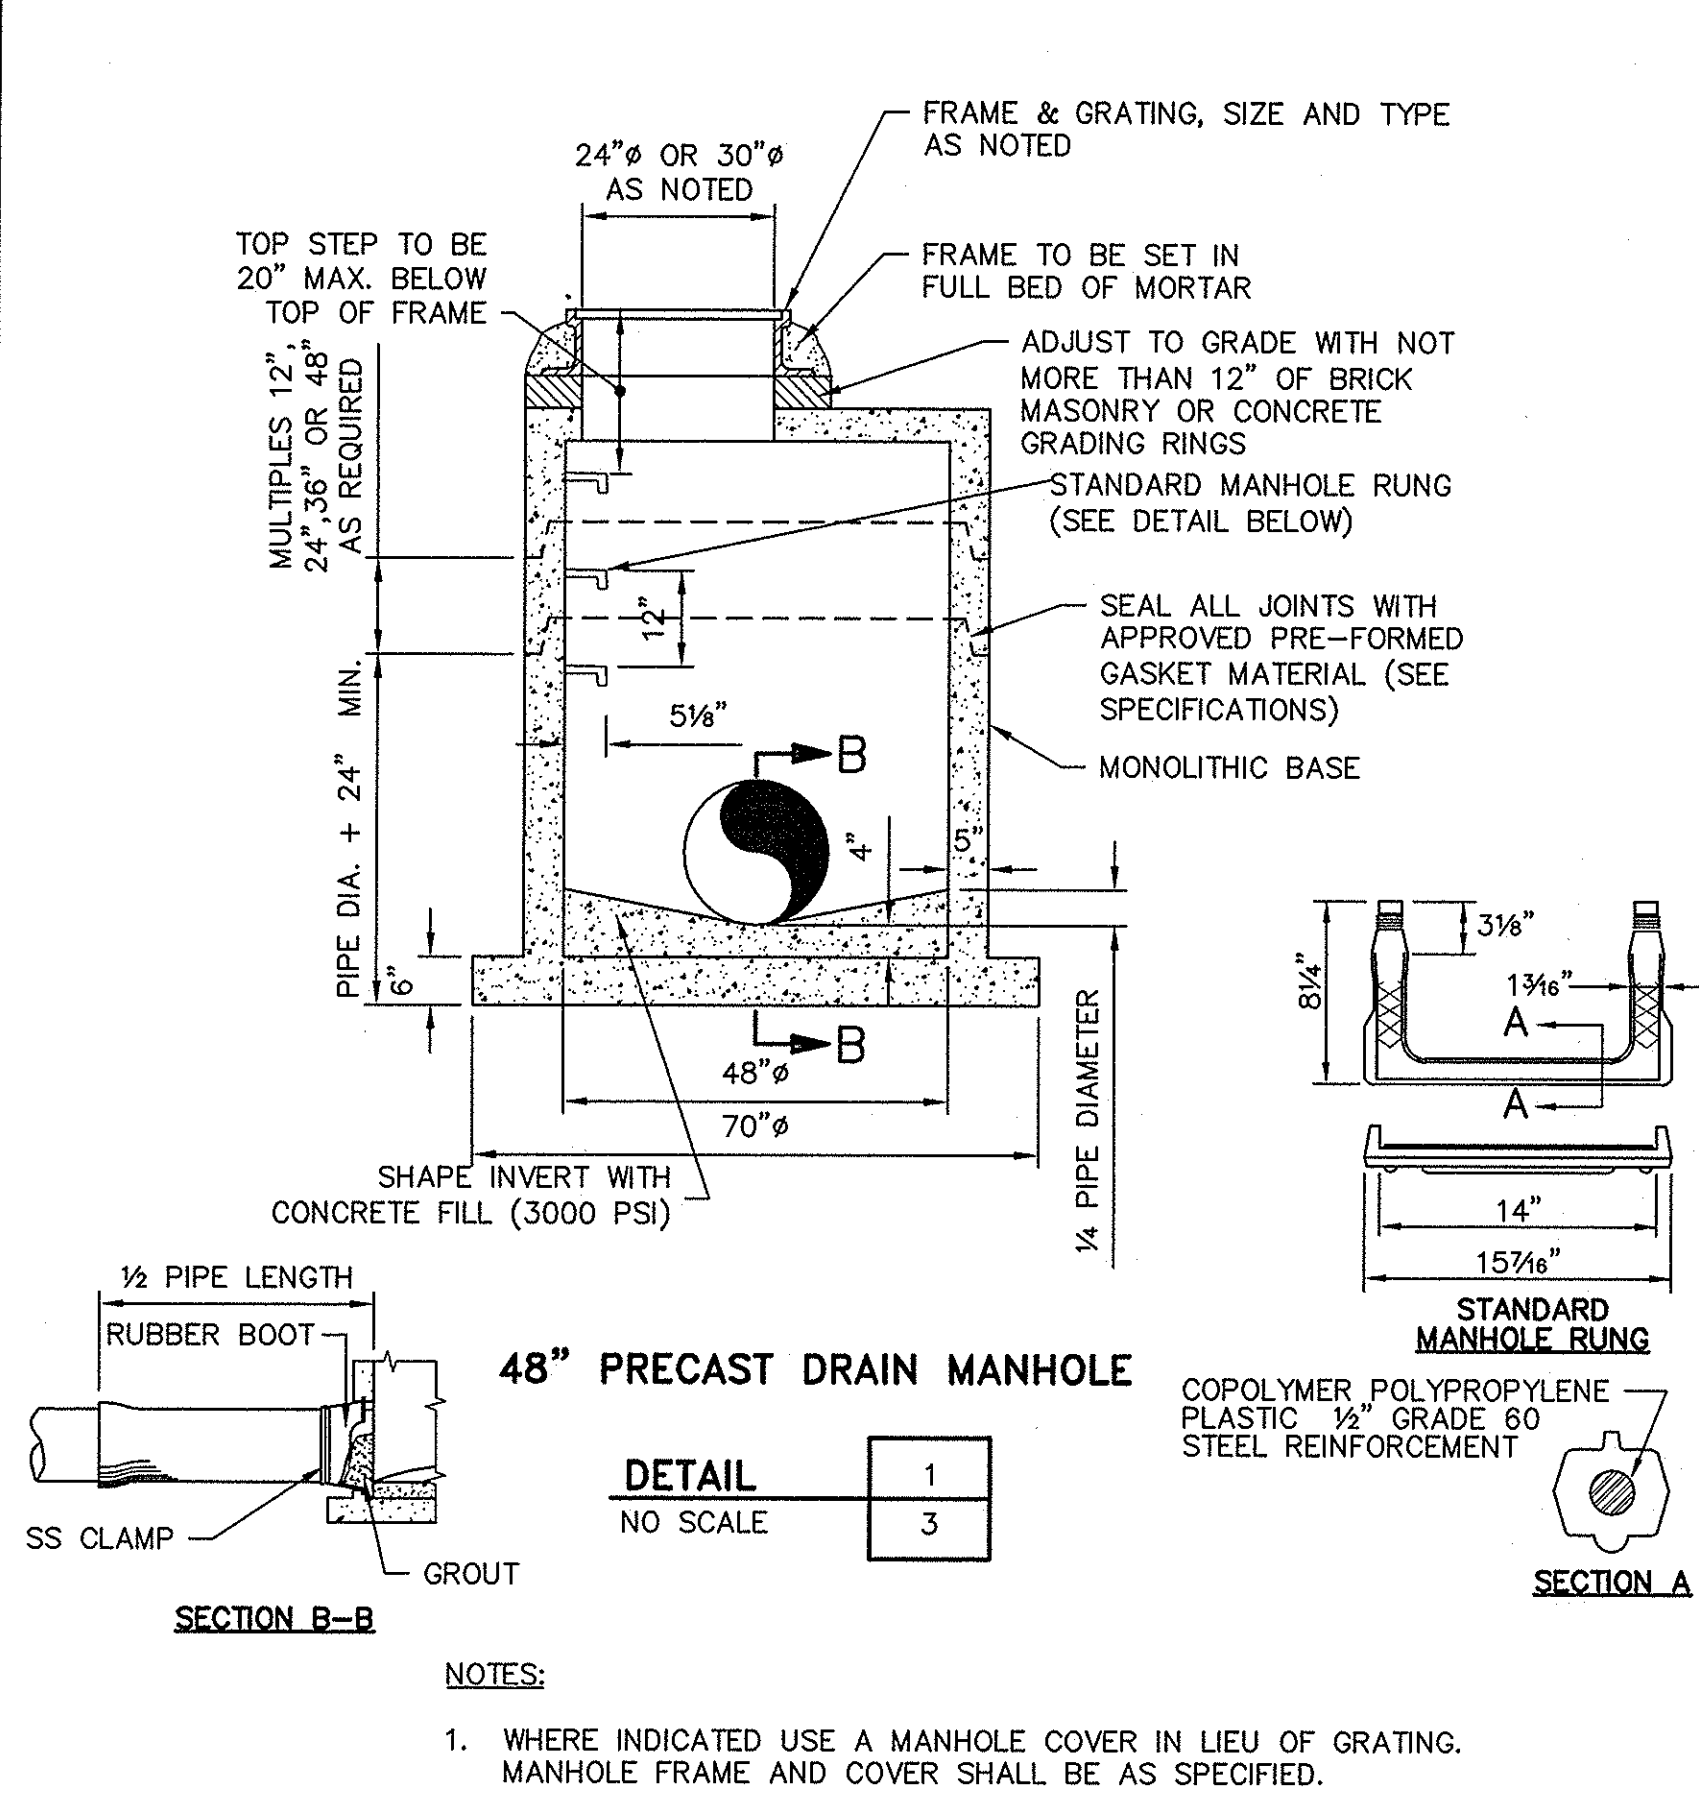


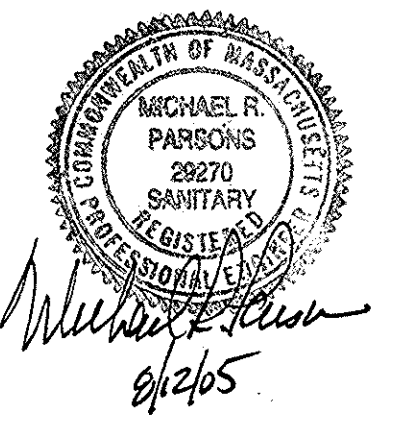

RECORD PLAN

THIS RECORD PLAN WAS PREPARED BASED ON LIMITED INFORMATION GATHERED DURING CONSTRUCTION OF THE PROJECT AND INDICATES ONLY SIGNIFICANT CHANGES MADE FROM THE DESIGN PLANS DURING CONSTRUCTION.

Tighe & Bond
Consulting Engineers
53 Southampton Road
Westfield, Massachusetts
(413) 562-1600
www.tighebond.com

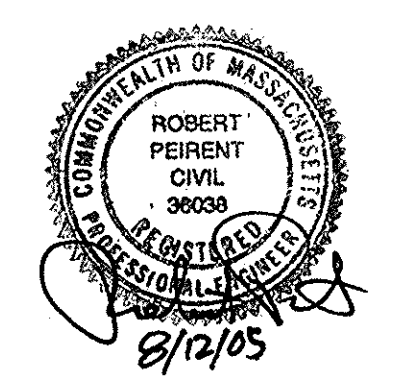

New Water
Storage Tank
Contract 1
Site Piping
Improvements

Department of
Public Works

East Longmeadow,
Massachusetts

1	11/06	RECORD PLAN
A	06/05	INITIAL ISSUE
Mark	Date	Description
PROJECT NO: E04512		
FILE: Water Tank DETAILS		
DRAWN BY: CFY		
CHECKED: ERL		
APPROVED BY: MRP, RP		

SITE DETAILS

SCALE: NO SCALE